


H-5360-A (MIDLAND) WESTLAND

FIT TO H-5360-B

FIT TO H-5360-A

FIT TO H-5360-B

FIT TO K-5564

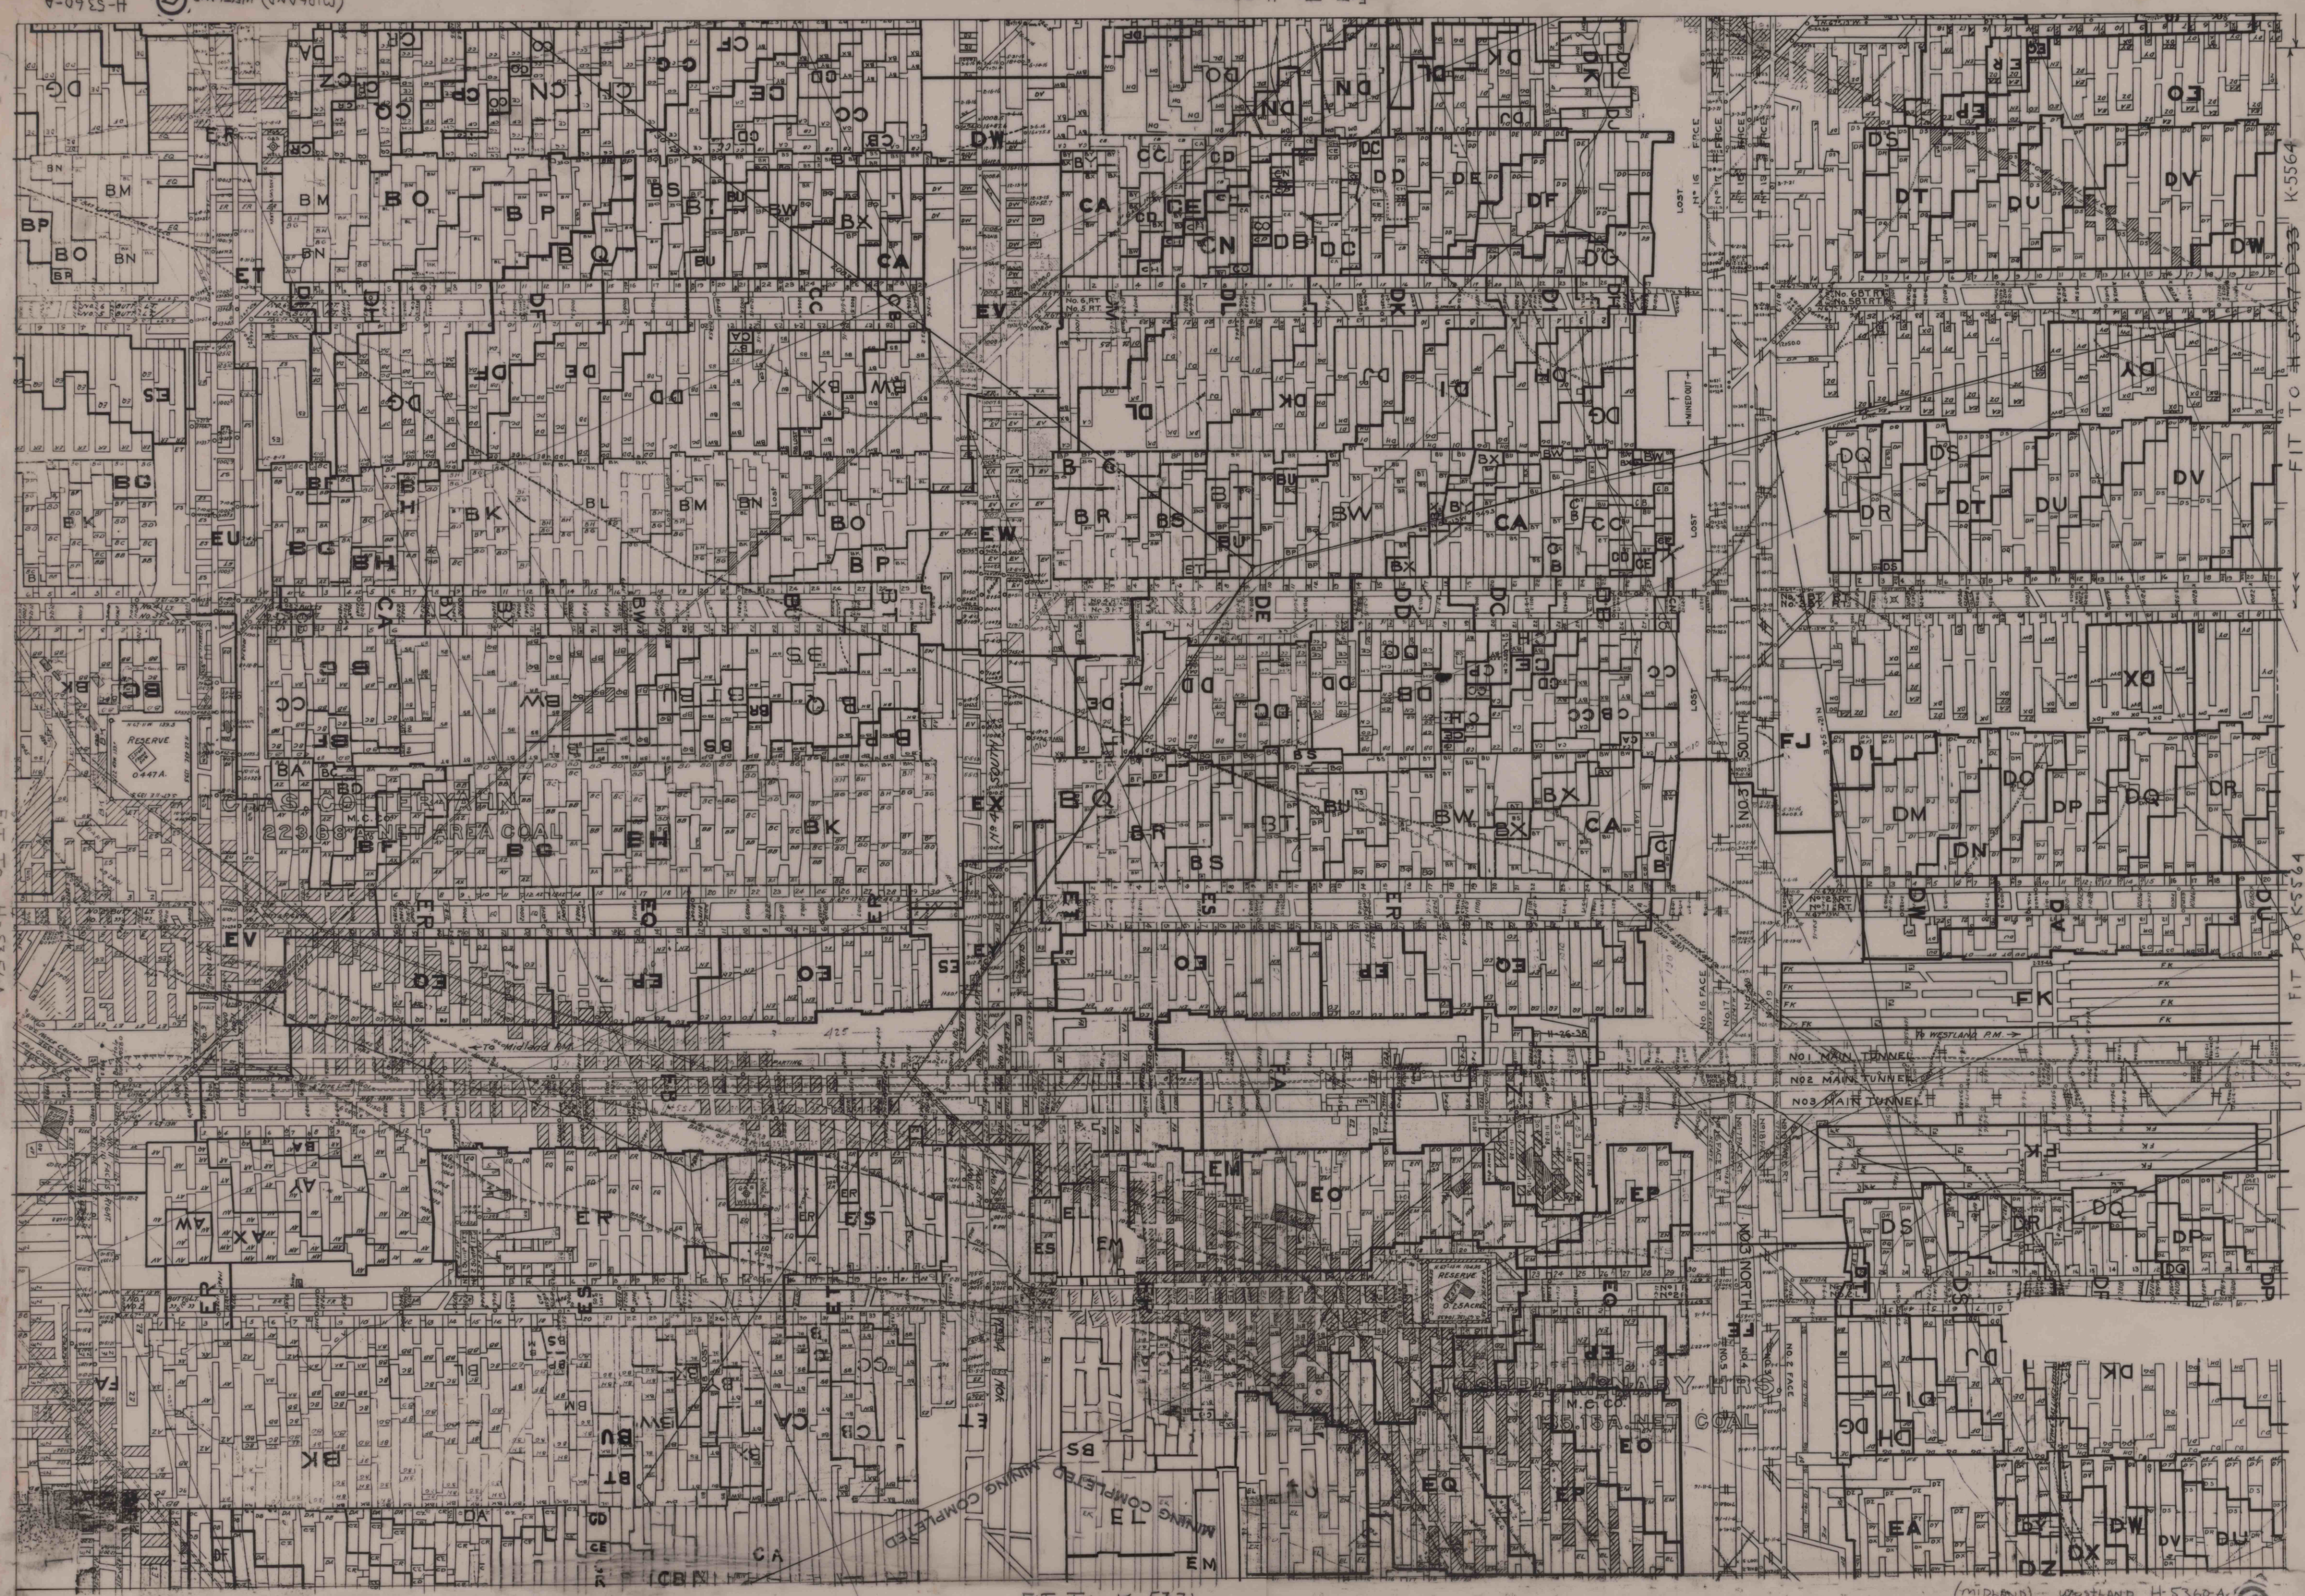

FIT TO K-5371

(MIDLAND) WESTLAND H-5360-A