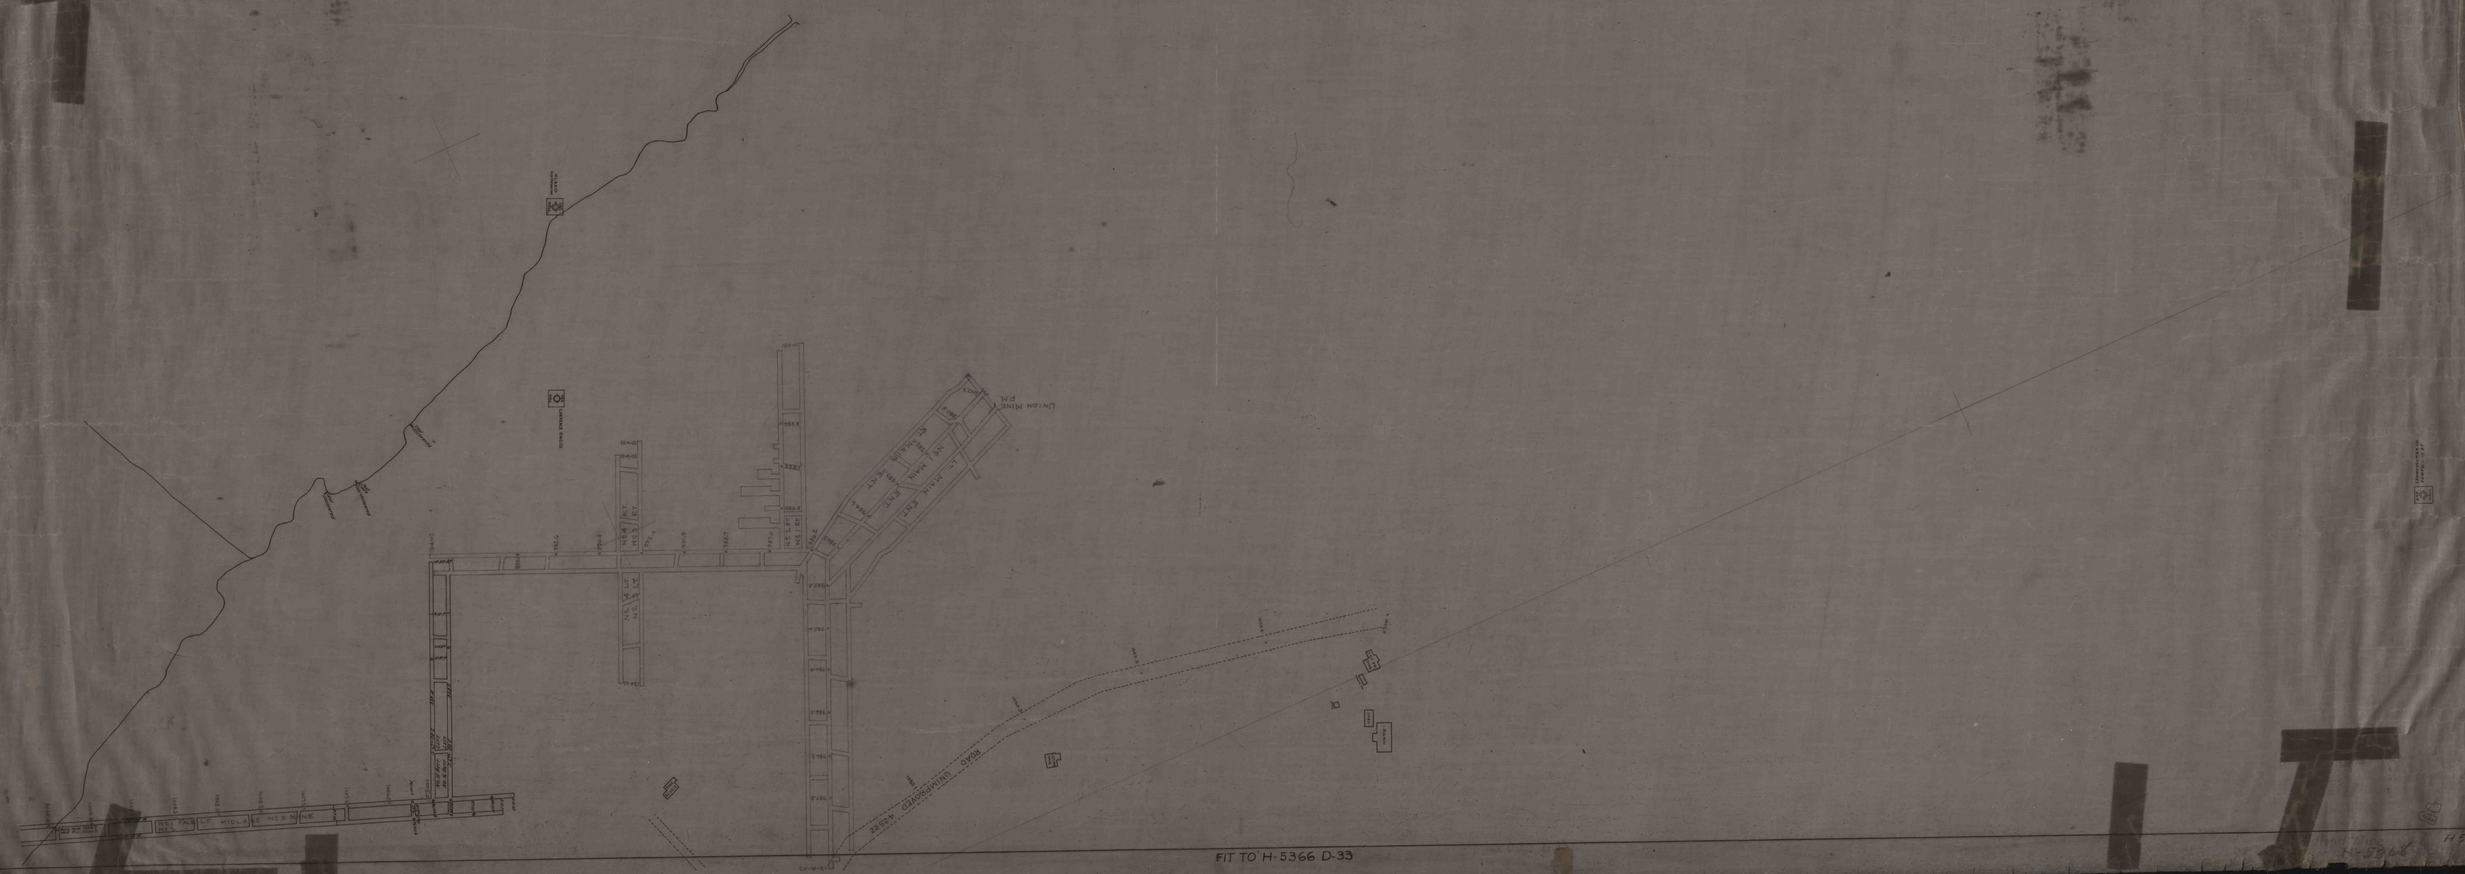
UNION MINE
PM
ROAD UNIMPROVED
FIT TO H-5366 D-33