


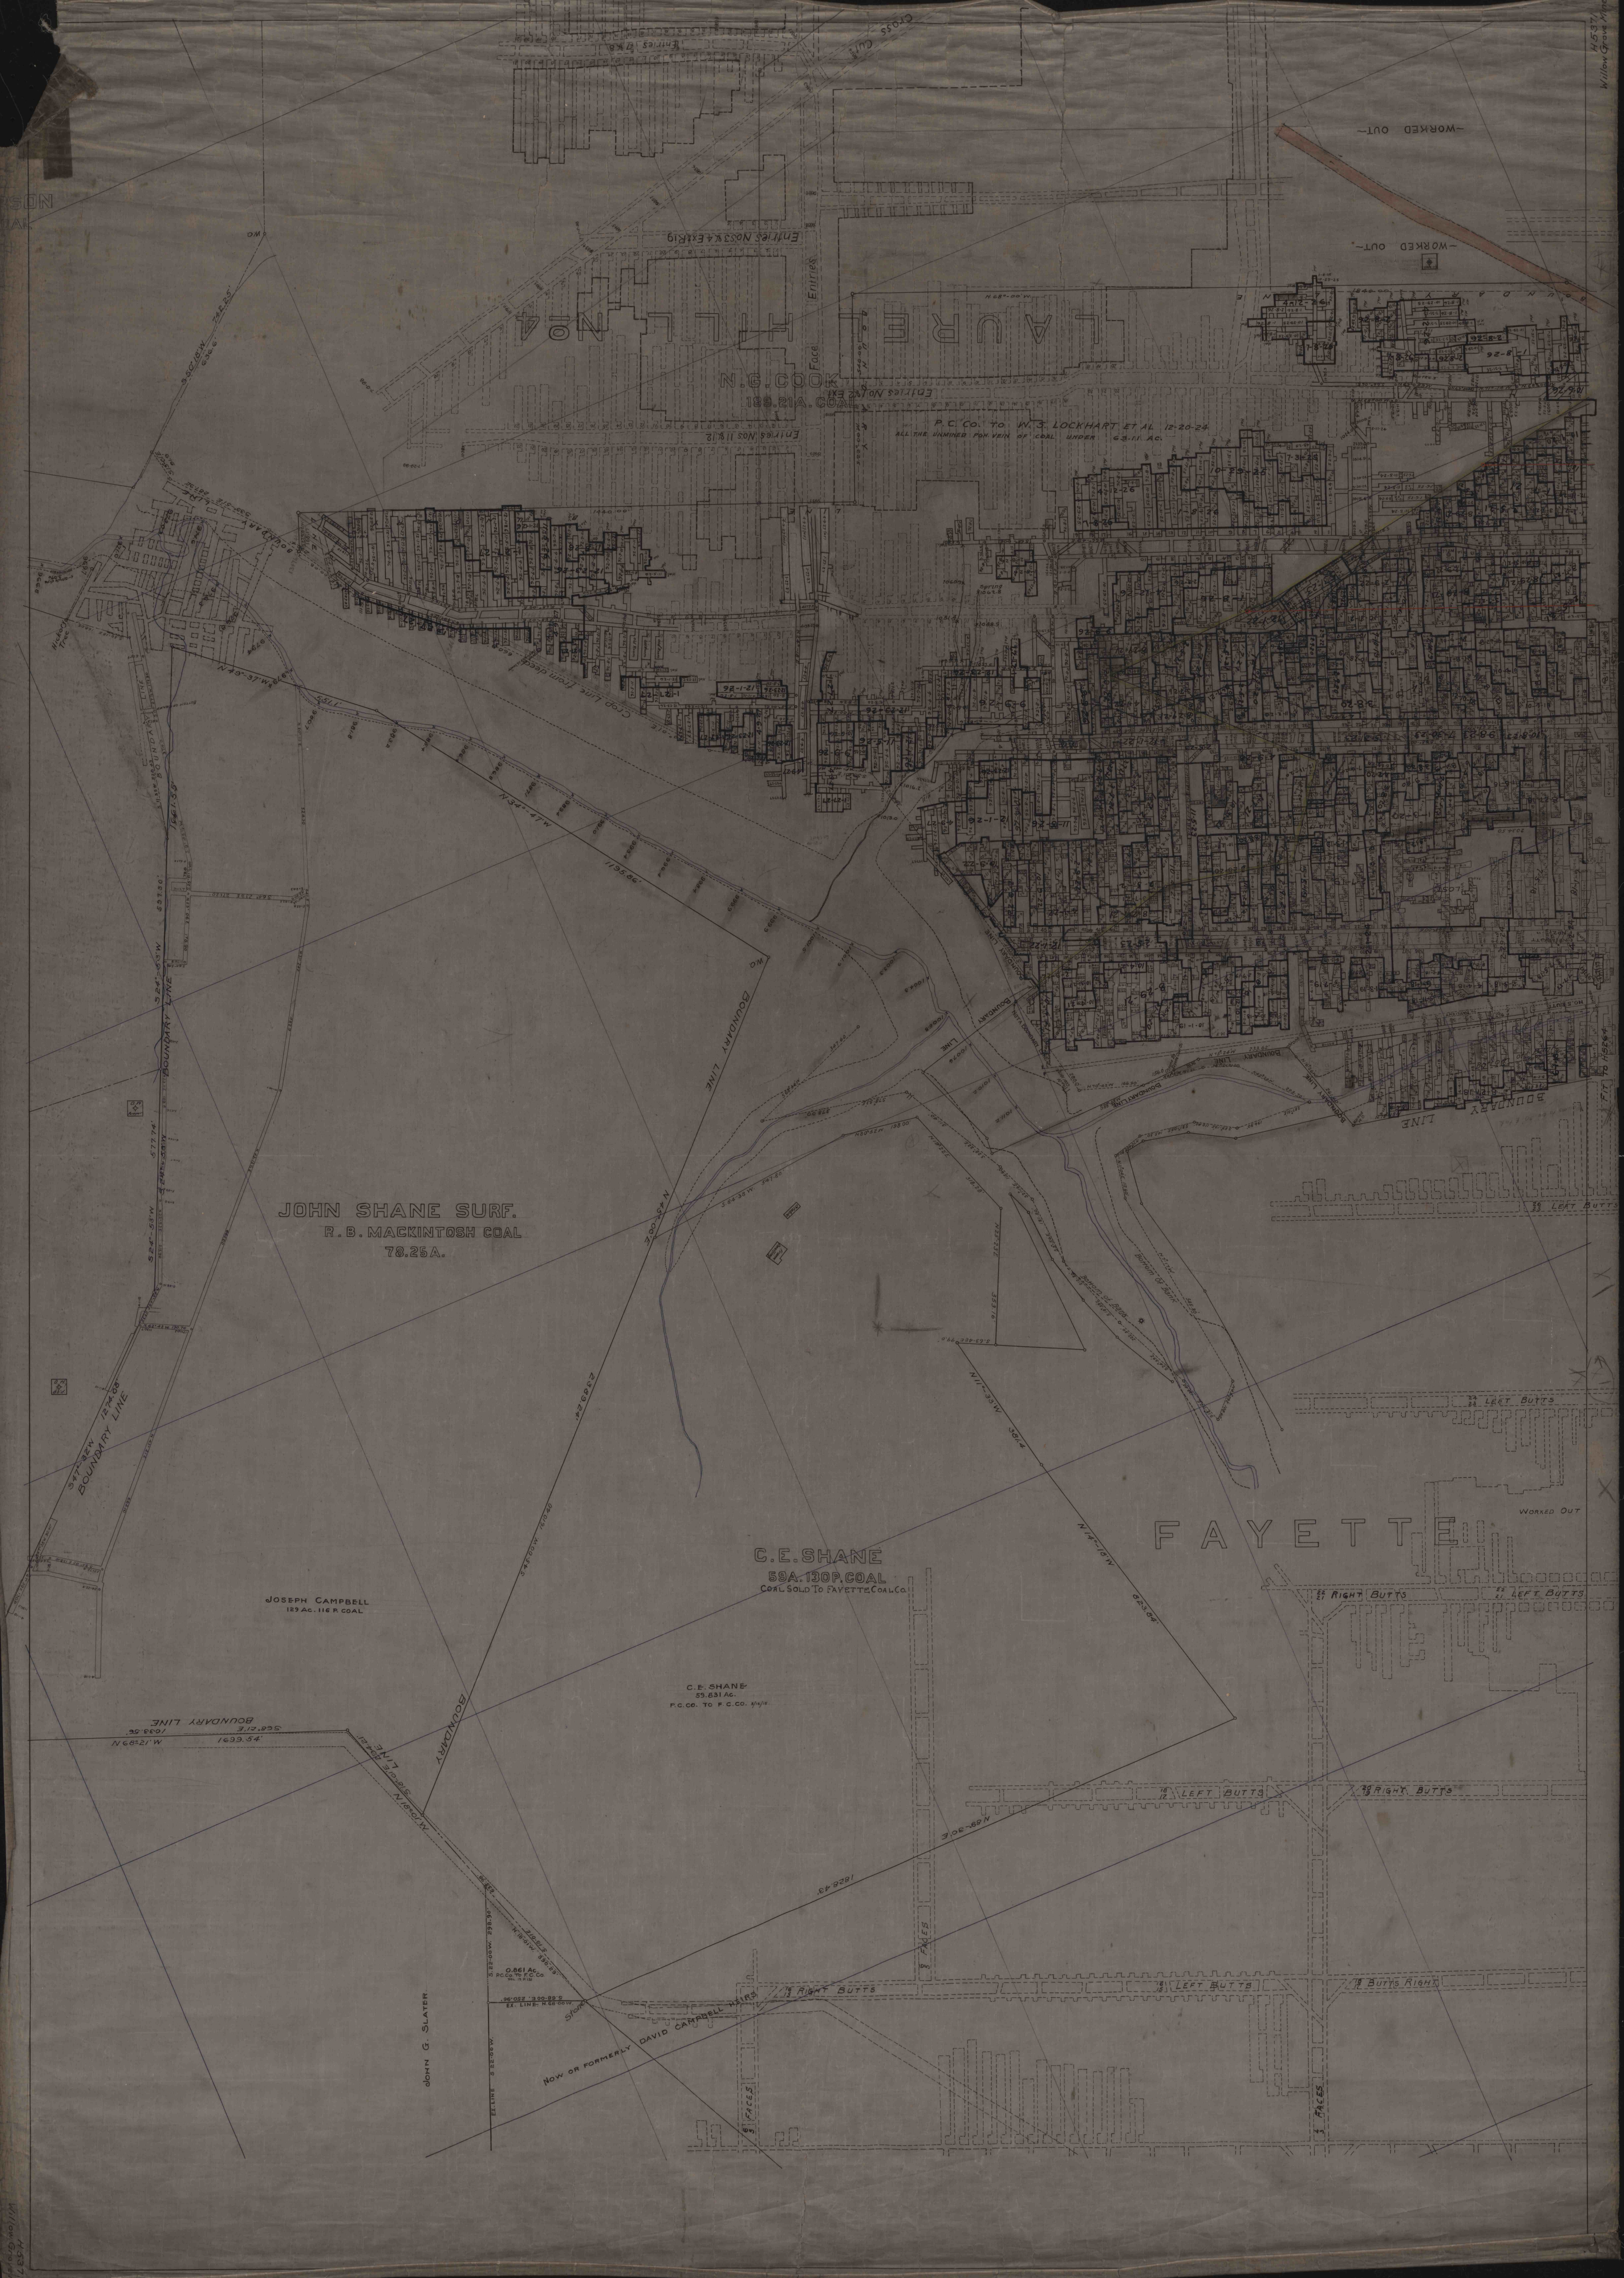

LAUREL

N.G. COOK
189.21A. COAL

P.C. CO. TO W.S. LOCKHART ET AL 12-20-24
ALL THE UNMINED PPH VEH OF COAL UNDER 63-11 AC.

JOHN SHANE SURF.
R.B. MACKINTOSH COAL
78.25A.

JOSEPH CAMPBELL
129 AC. 116 P. COAL

C.E. SHANE
59A. 130P. COAL
COAL SOLD TO FAYETTE COAL CO.

C.E. SHANE
59.631 AC.
P.C. CO. TO F.C. CO. 1/4/14

FAYETTE

NOW OR FORMERLY DAVID CAMPBELL MINE

JOHN G. SLATER

WORKED OUT

WORKED OUT

WORKED OUT

21 RIGHT BUTTS

21 LEFT BUTTS

2 LEFT BUTTS

19 RIGHT BUTTS

15 RIGHT BUTTS

11 LEFT BUTTS

18 BUTTS RIGHT

3 FACES

8 FACES


SON

