


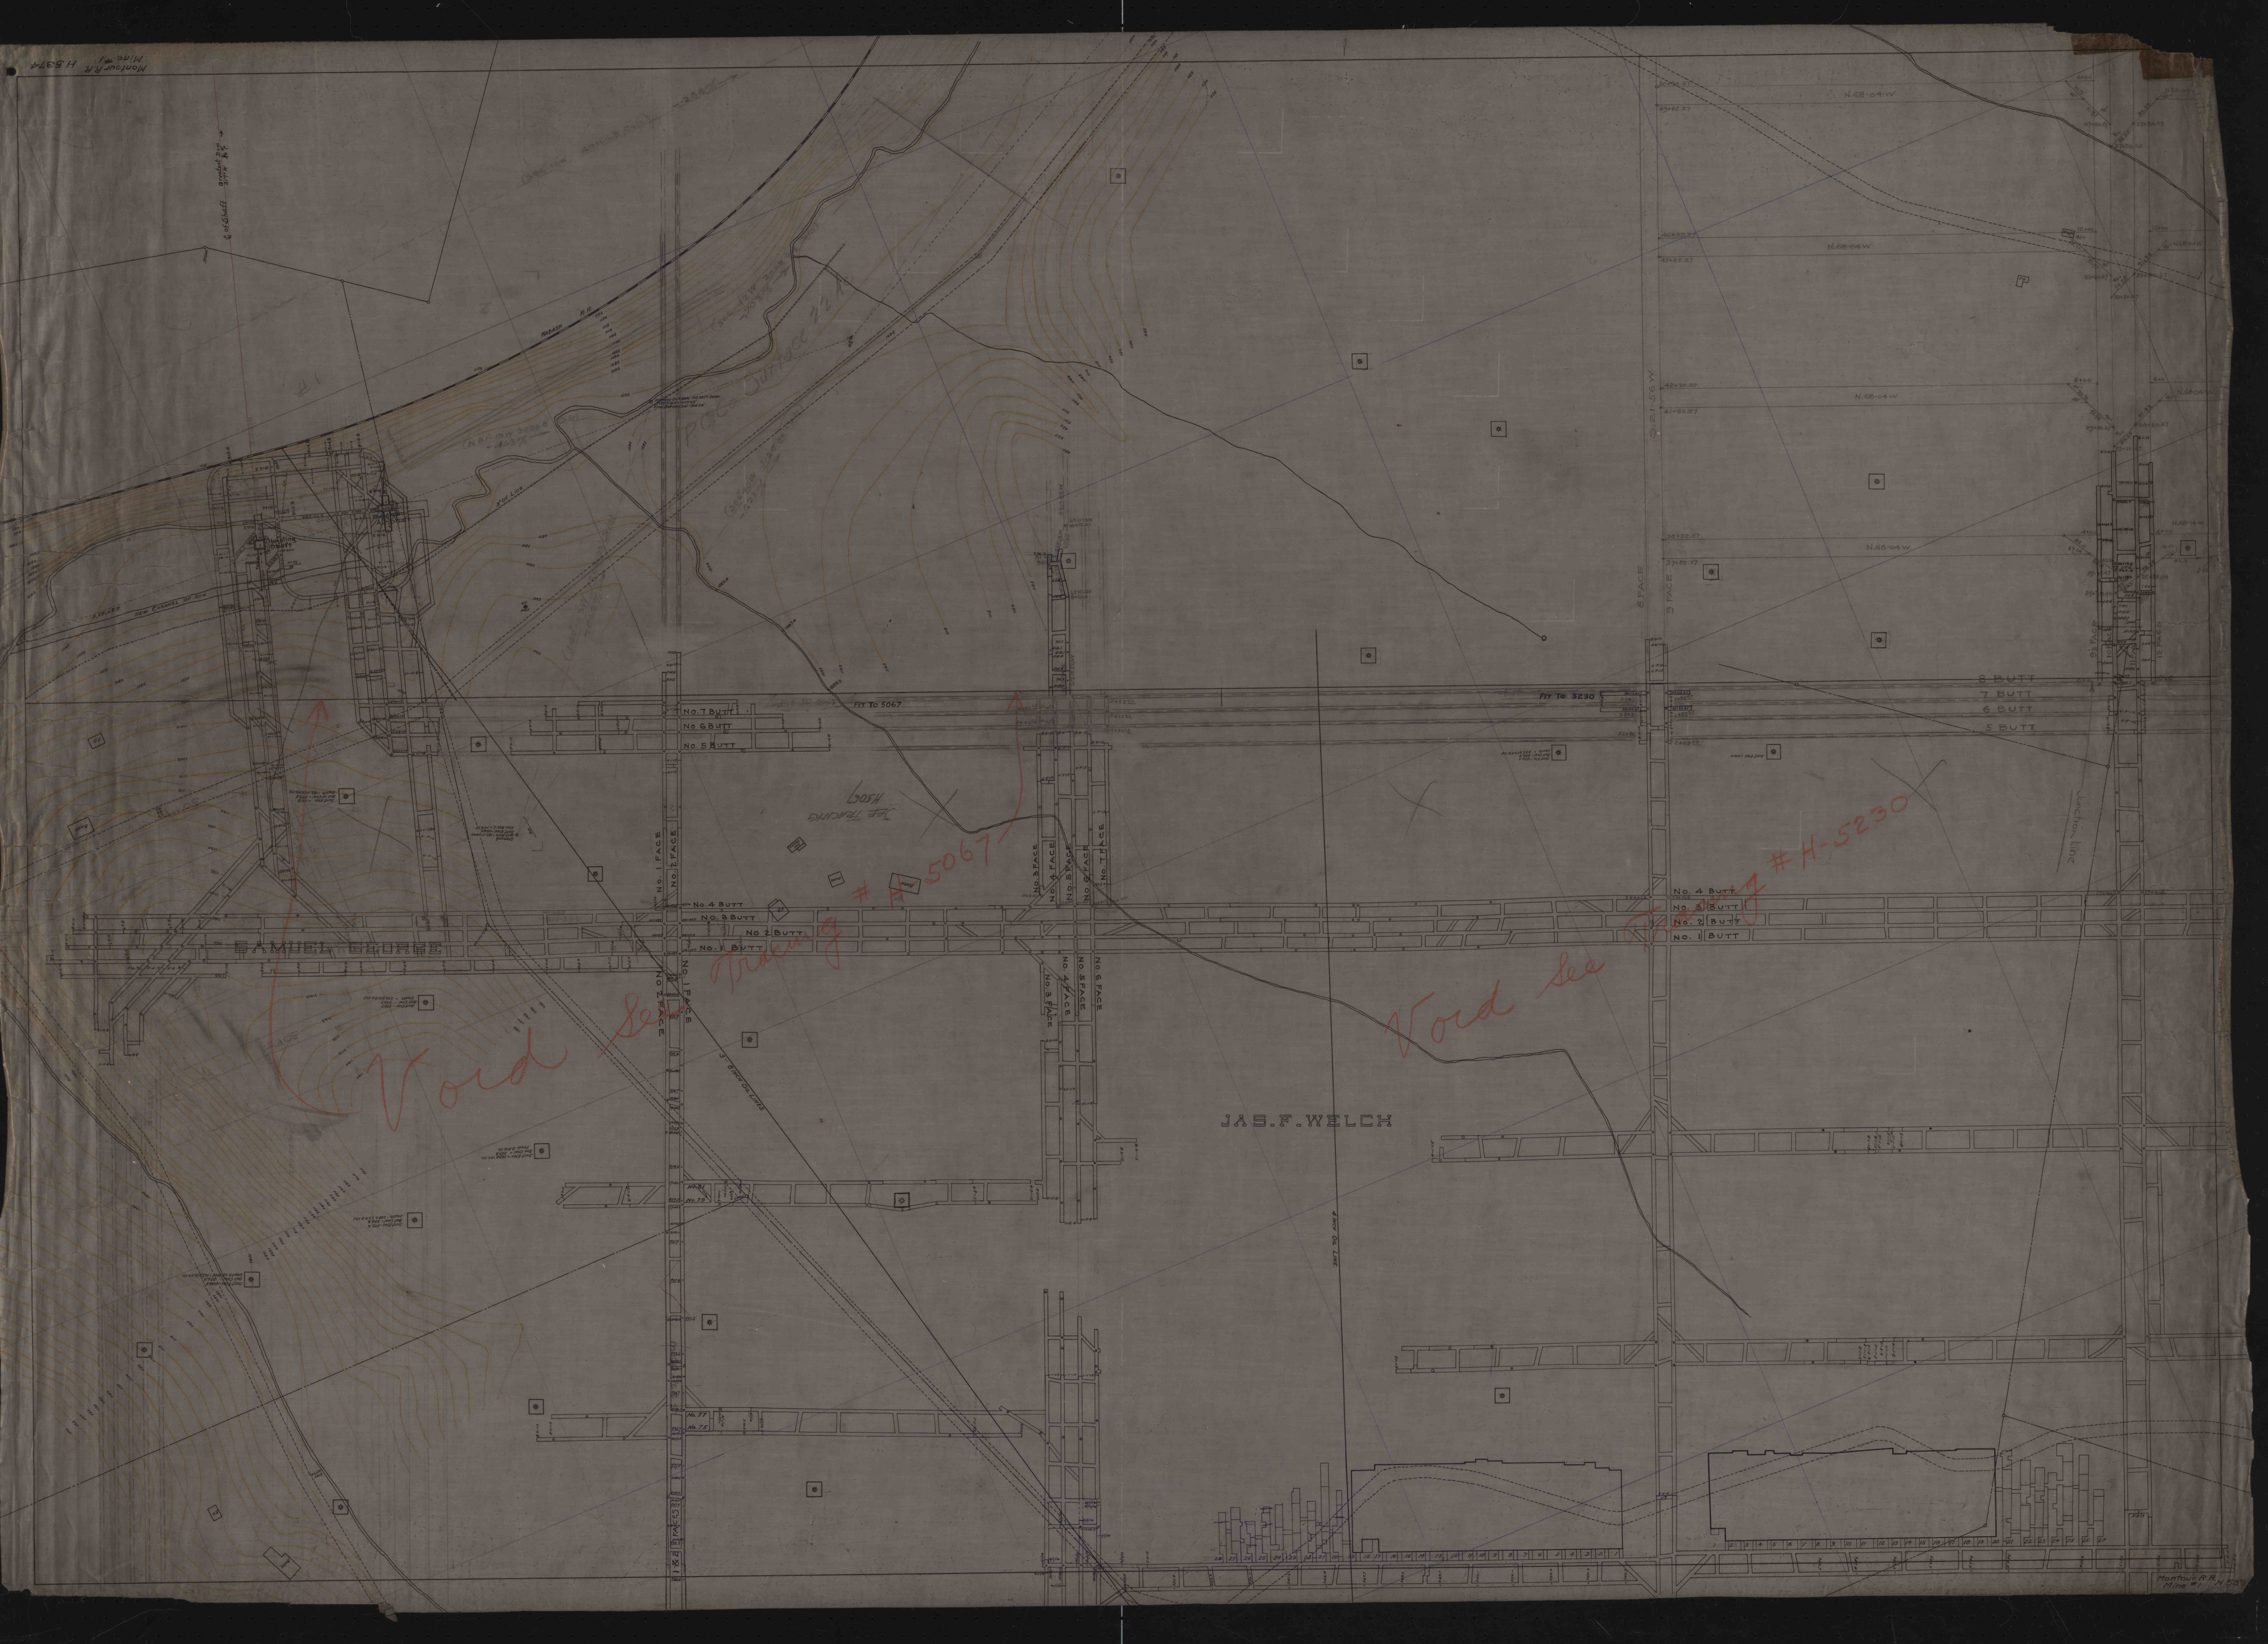

*Void See*

*Tracing # H-5067*

*Void See*

*# H-5230*

J.B.F. WELCH