


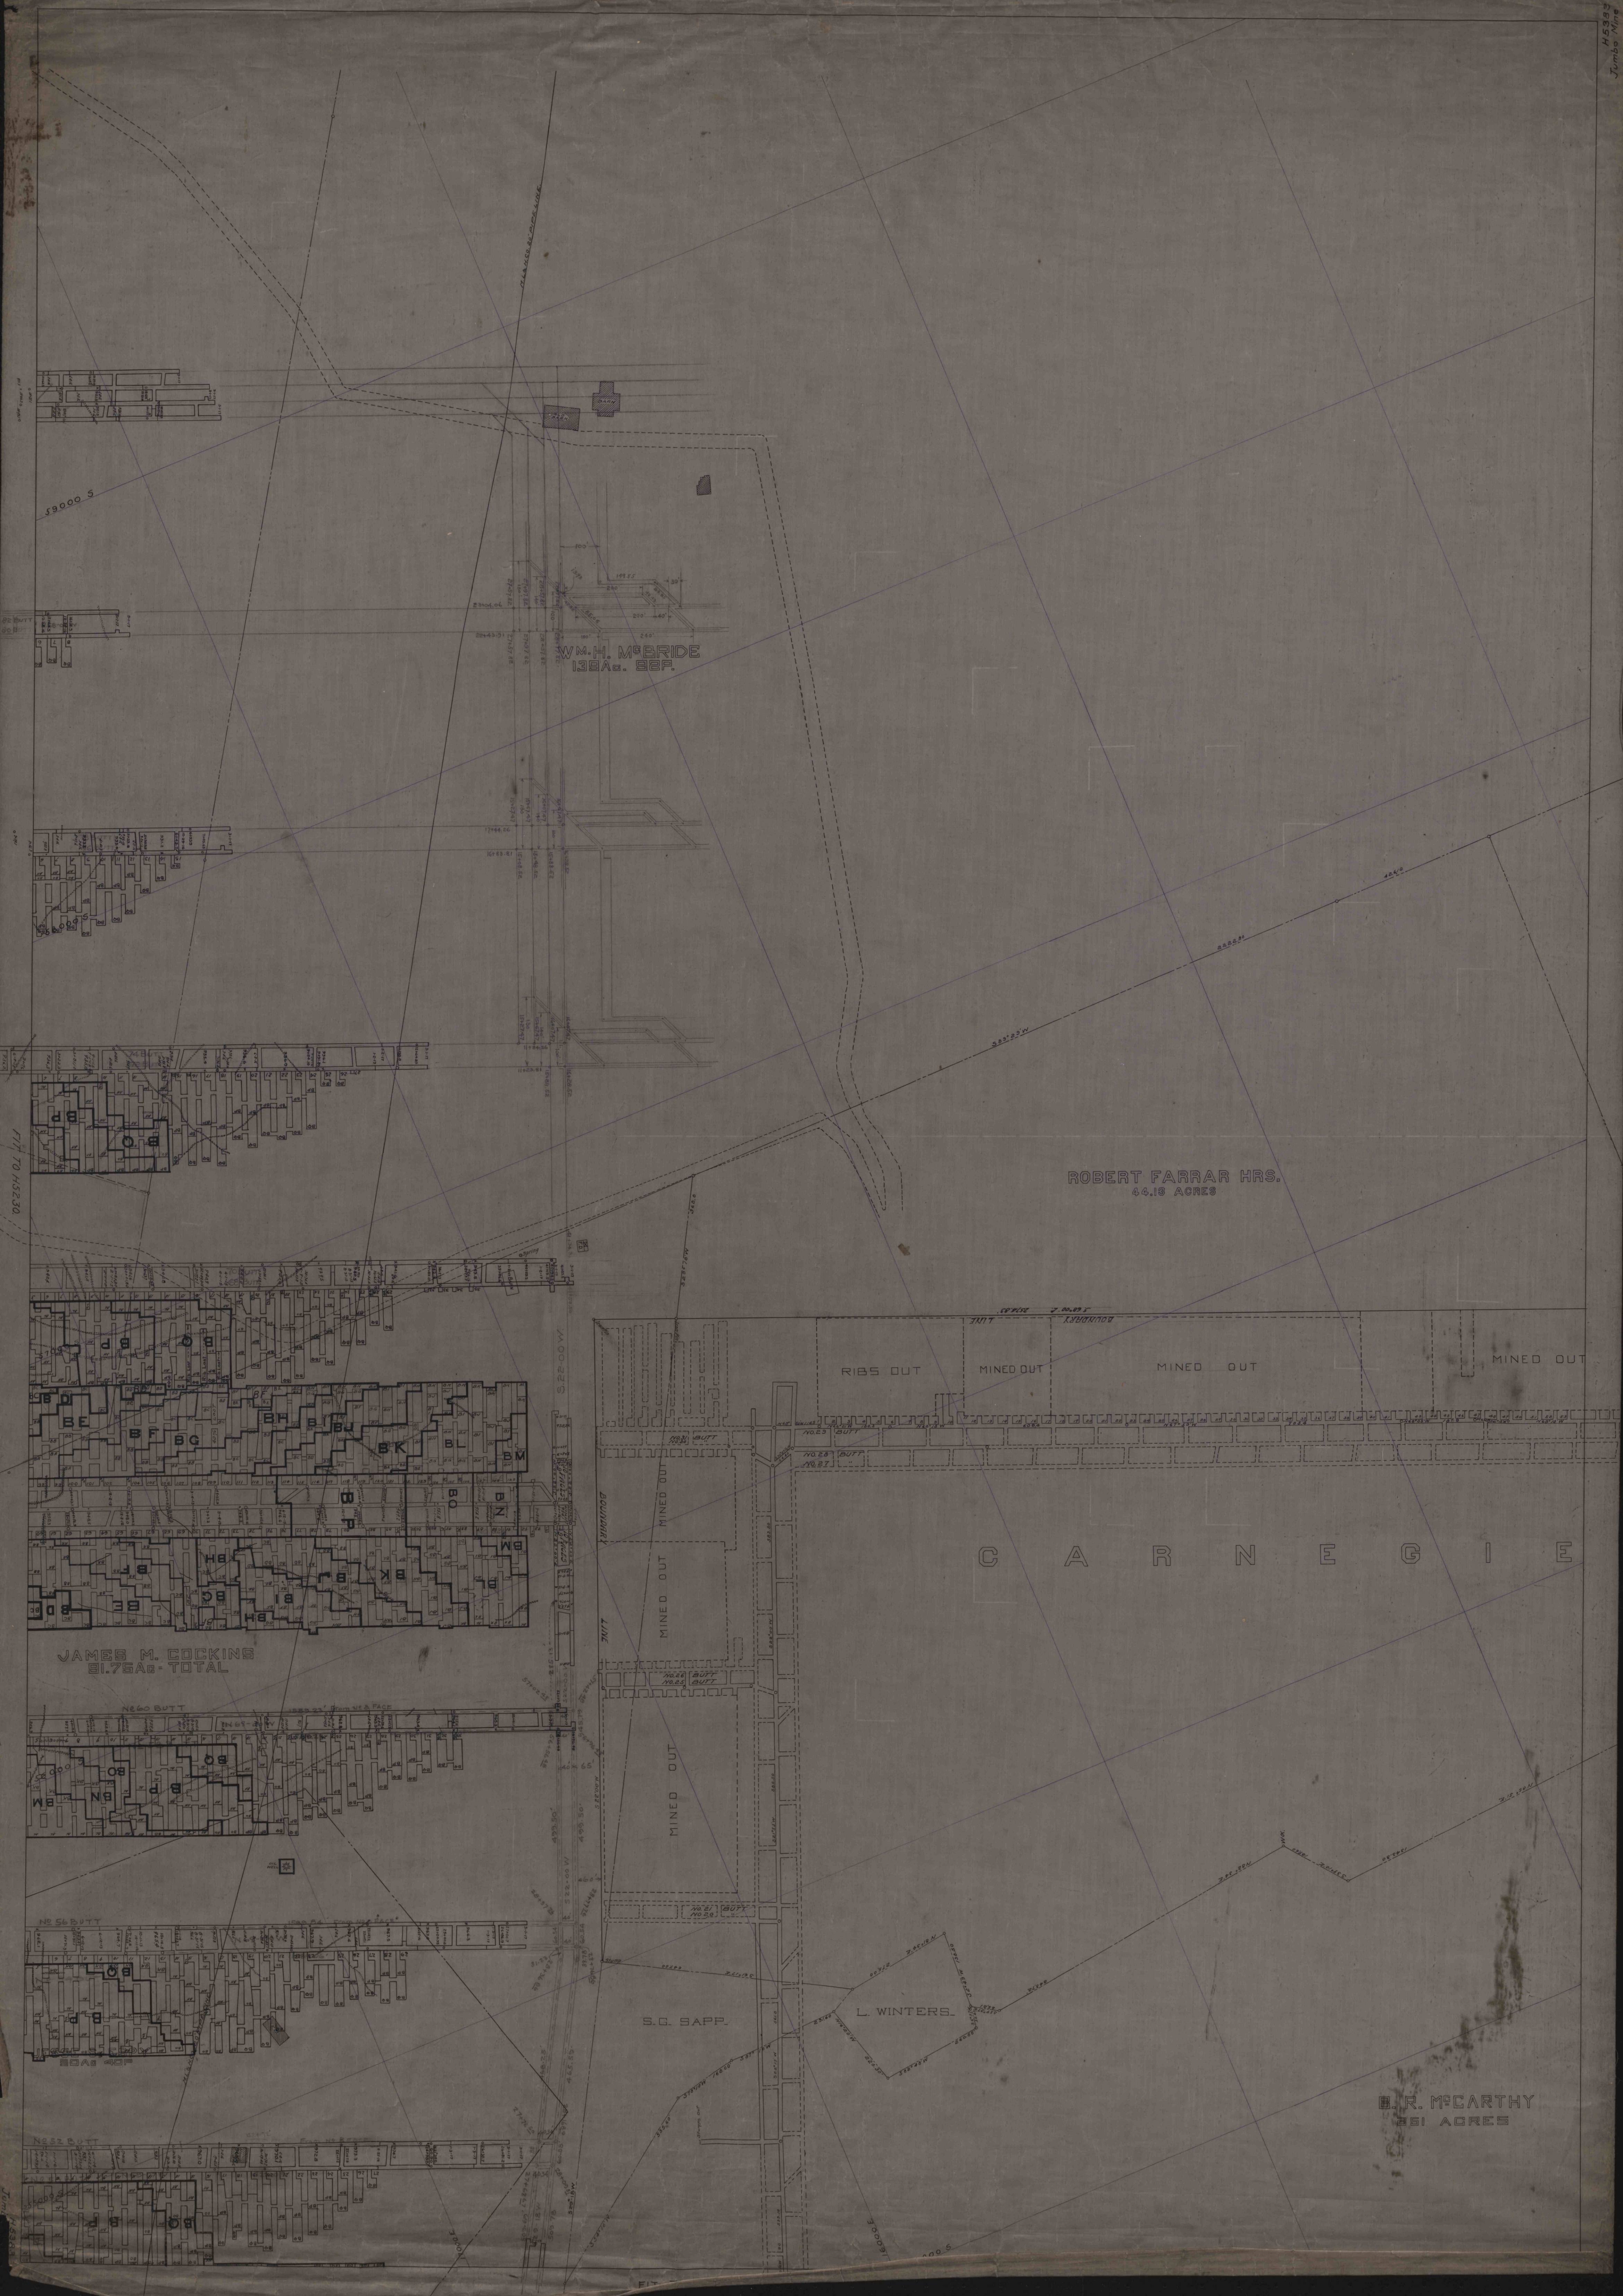

WM. H. MCBRIDE
138A. 88P.

ROBERT FARRAR HRS.
64.18 ACRES

JAMES M. COCKINS
81.75A. TOTAL

S.D. SAPP

L. WINTERS

R. MCARTHY
851 ACRES

C A R N E G I E