


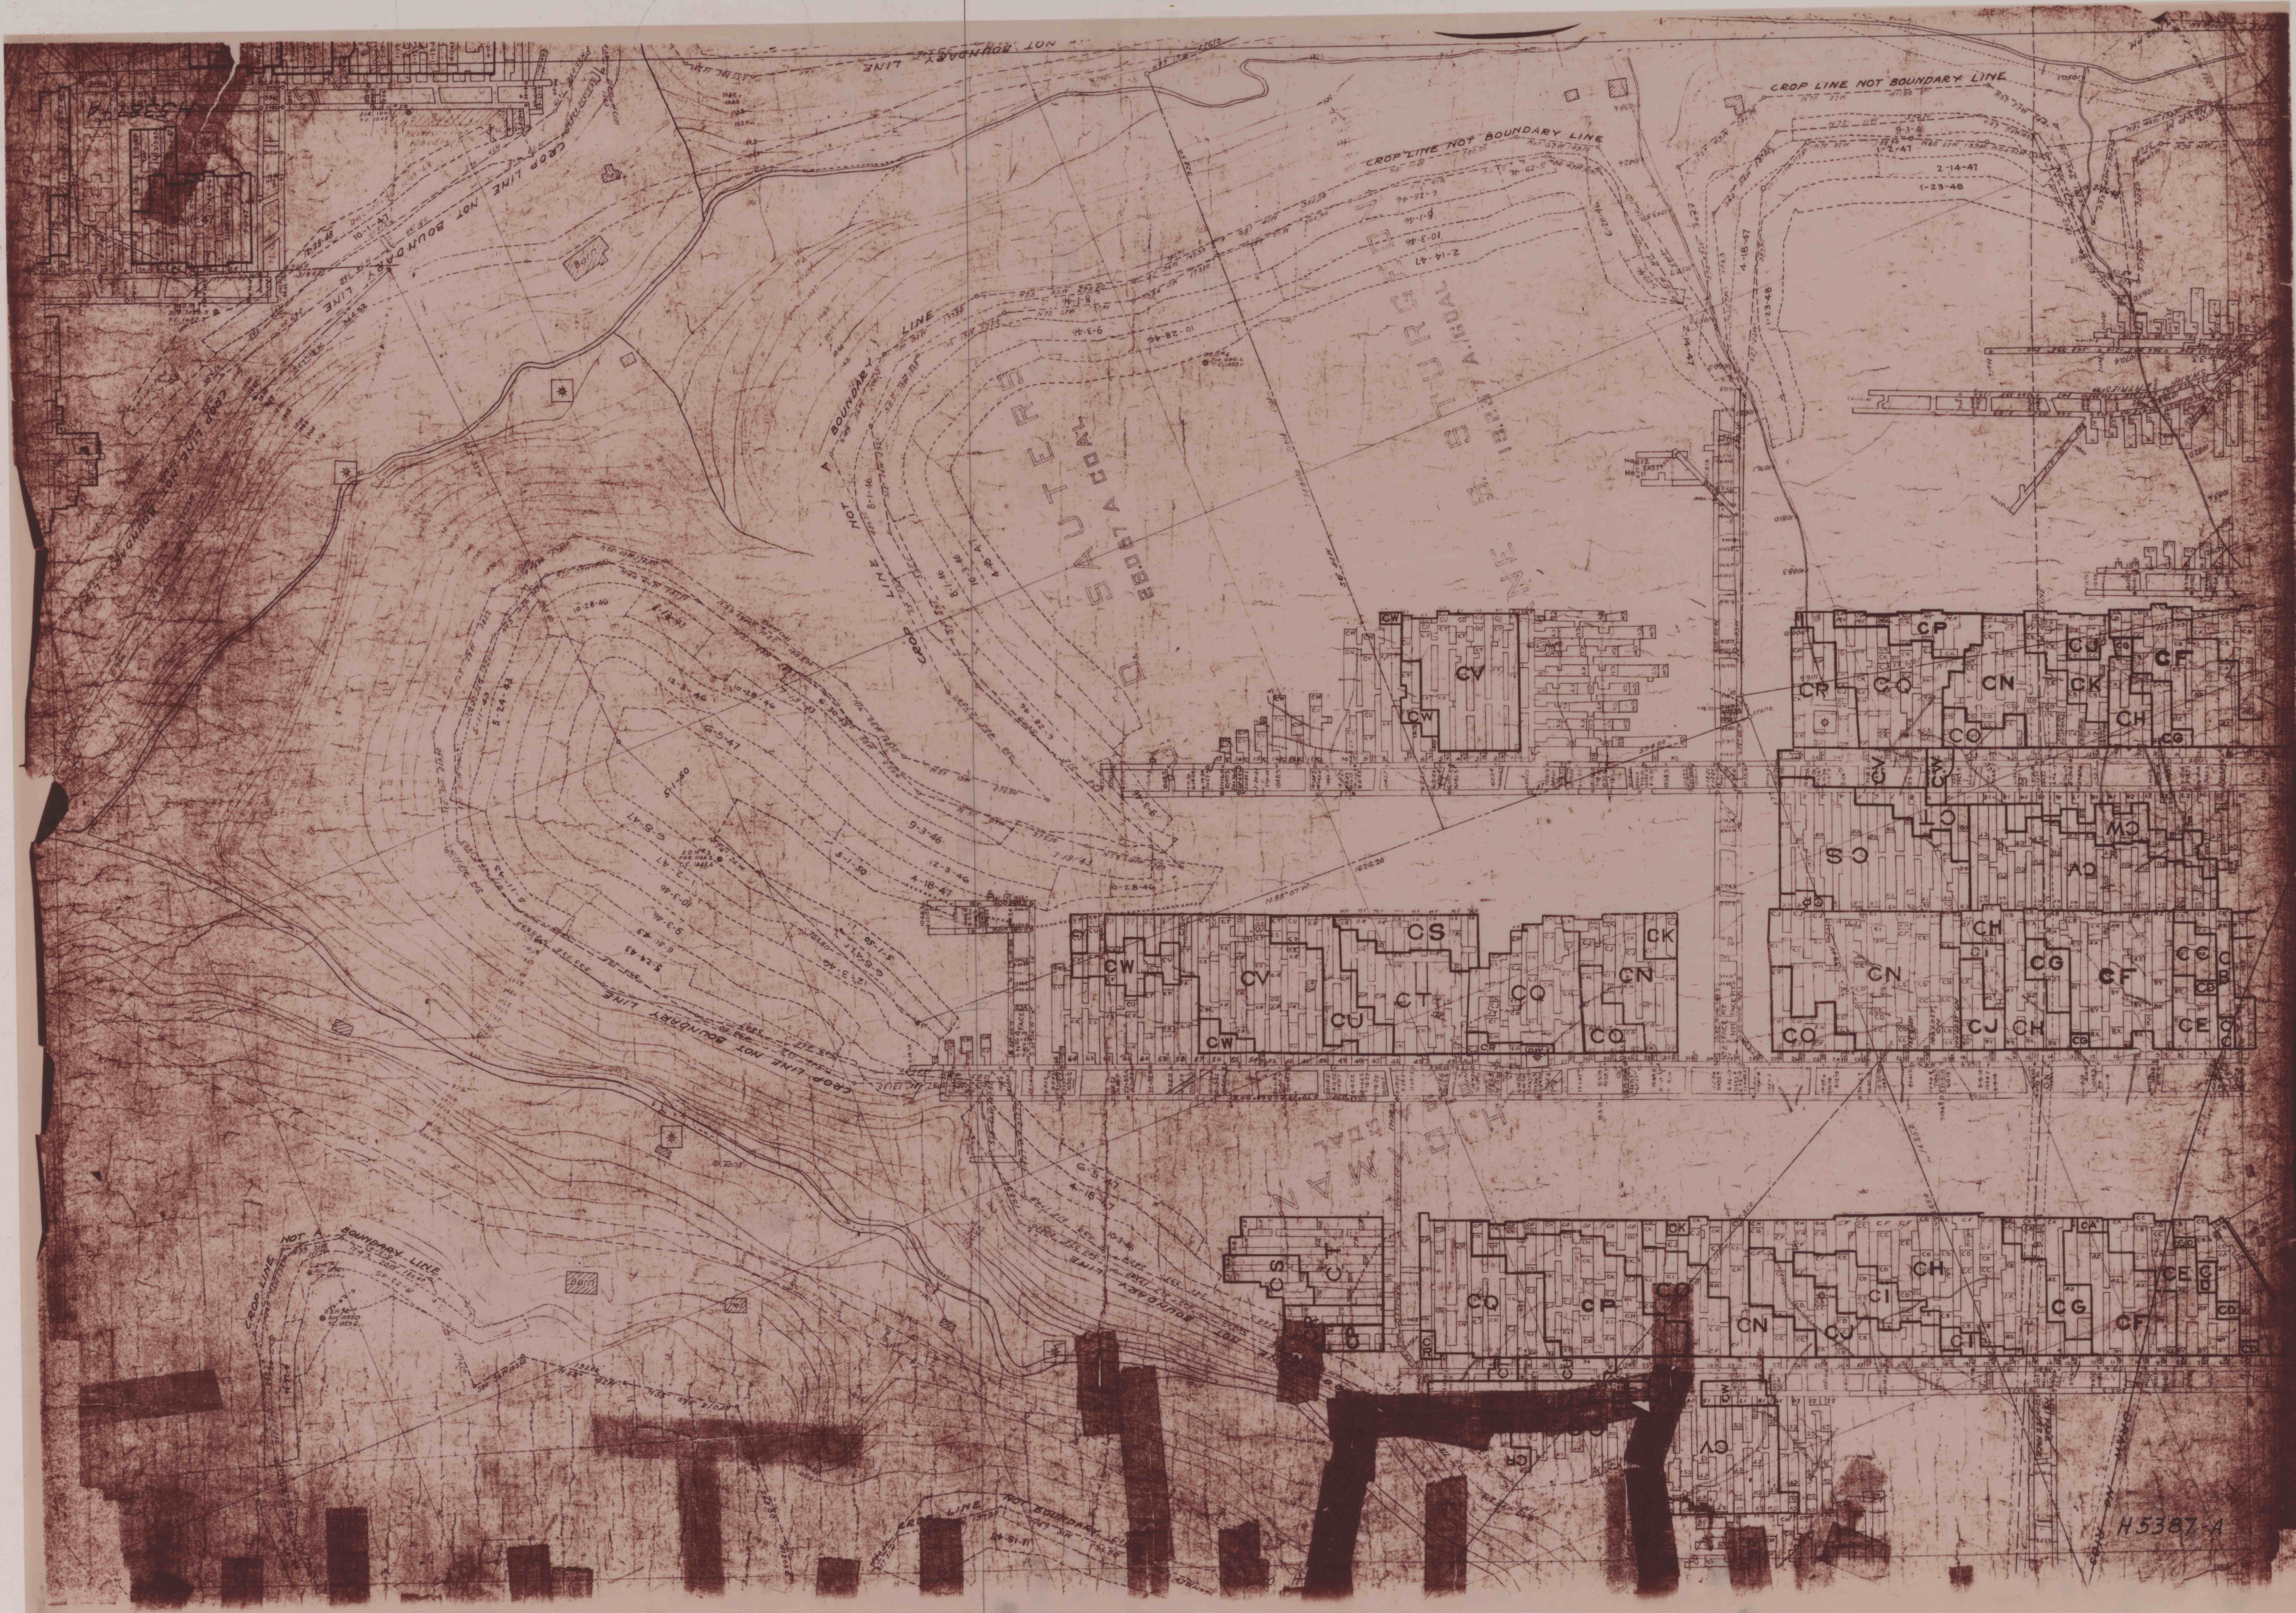

H5387-A