

500 Feet C. 111307

WASHINGTON COAL CO.


DAVID P. STEPHENS.
22A COAL.

51831A COAL.

WM. H. B. BING
1424A COAL.

MINE

APOLLO

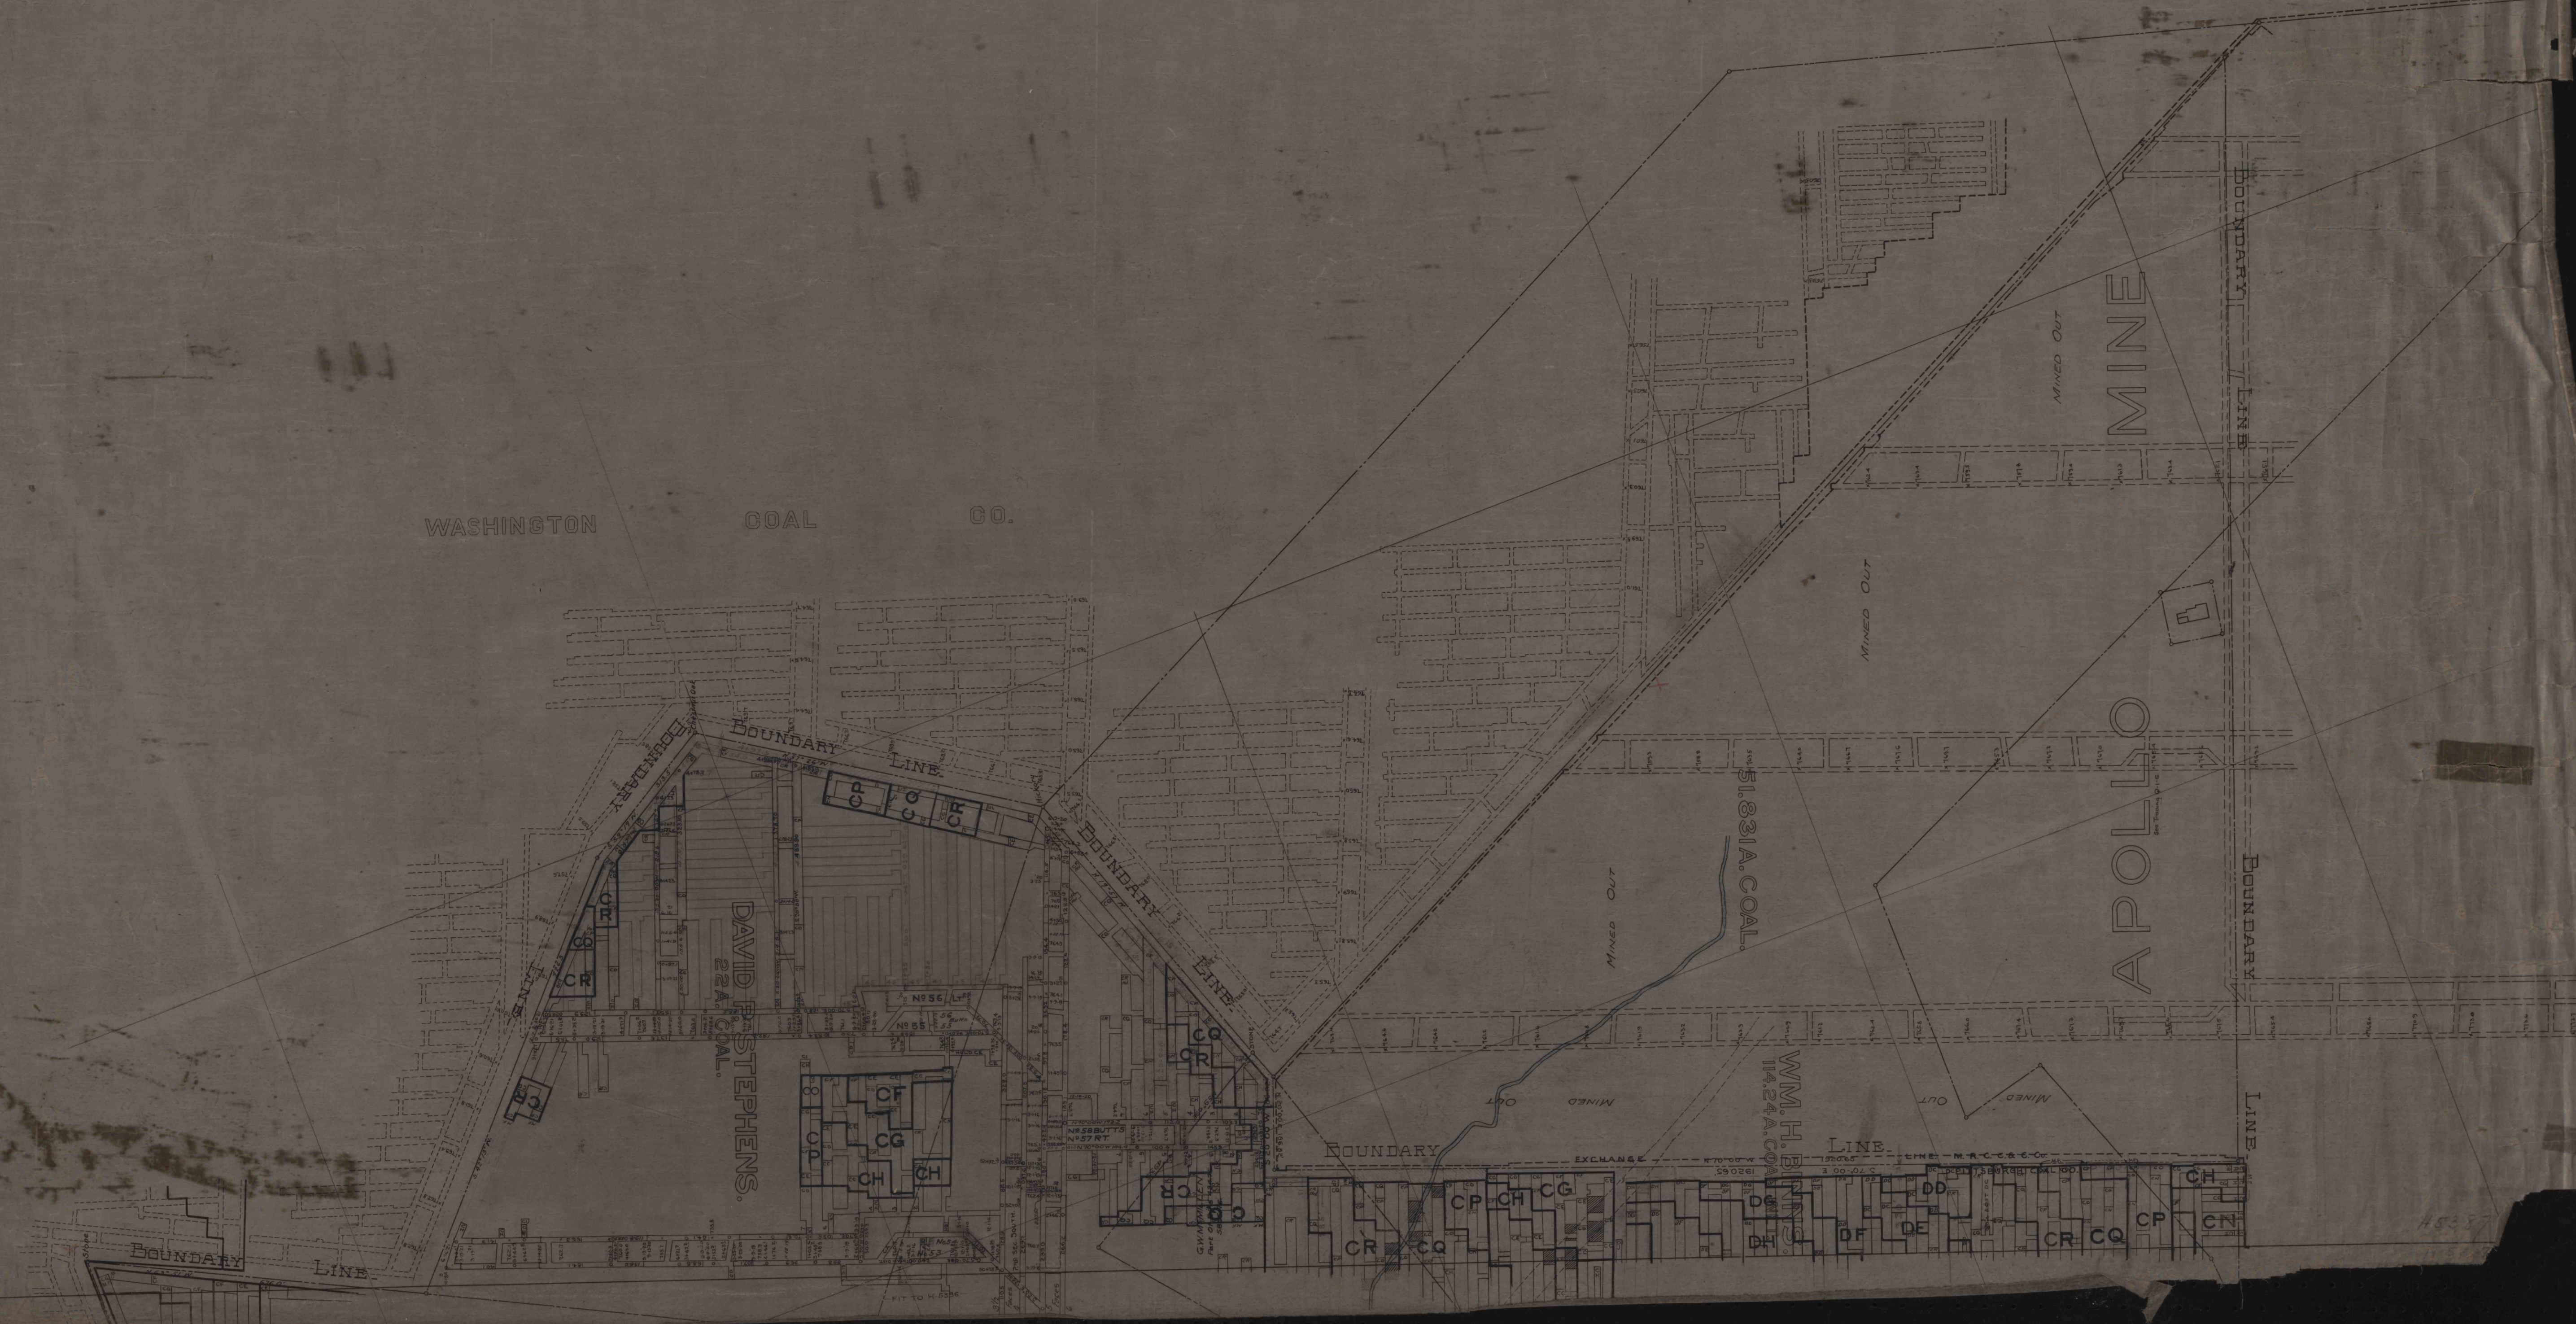

5389