


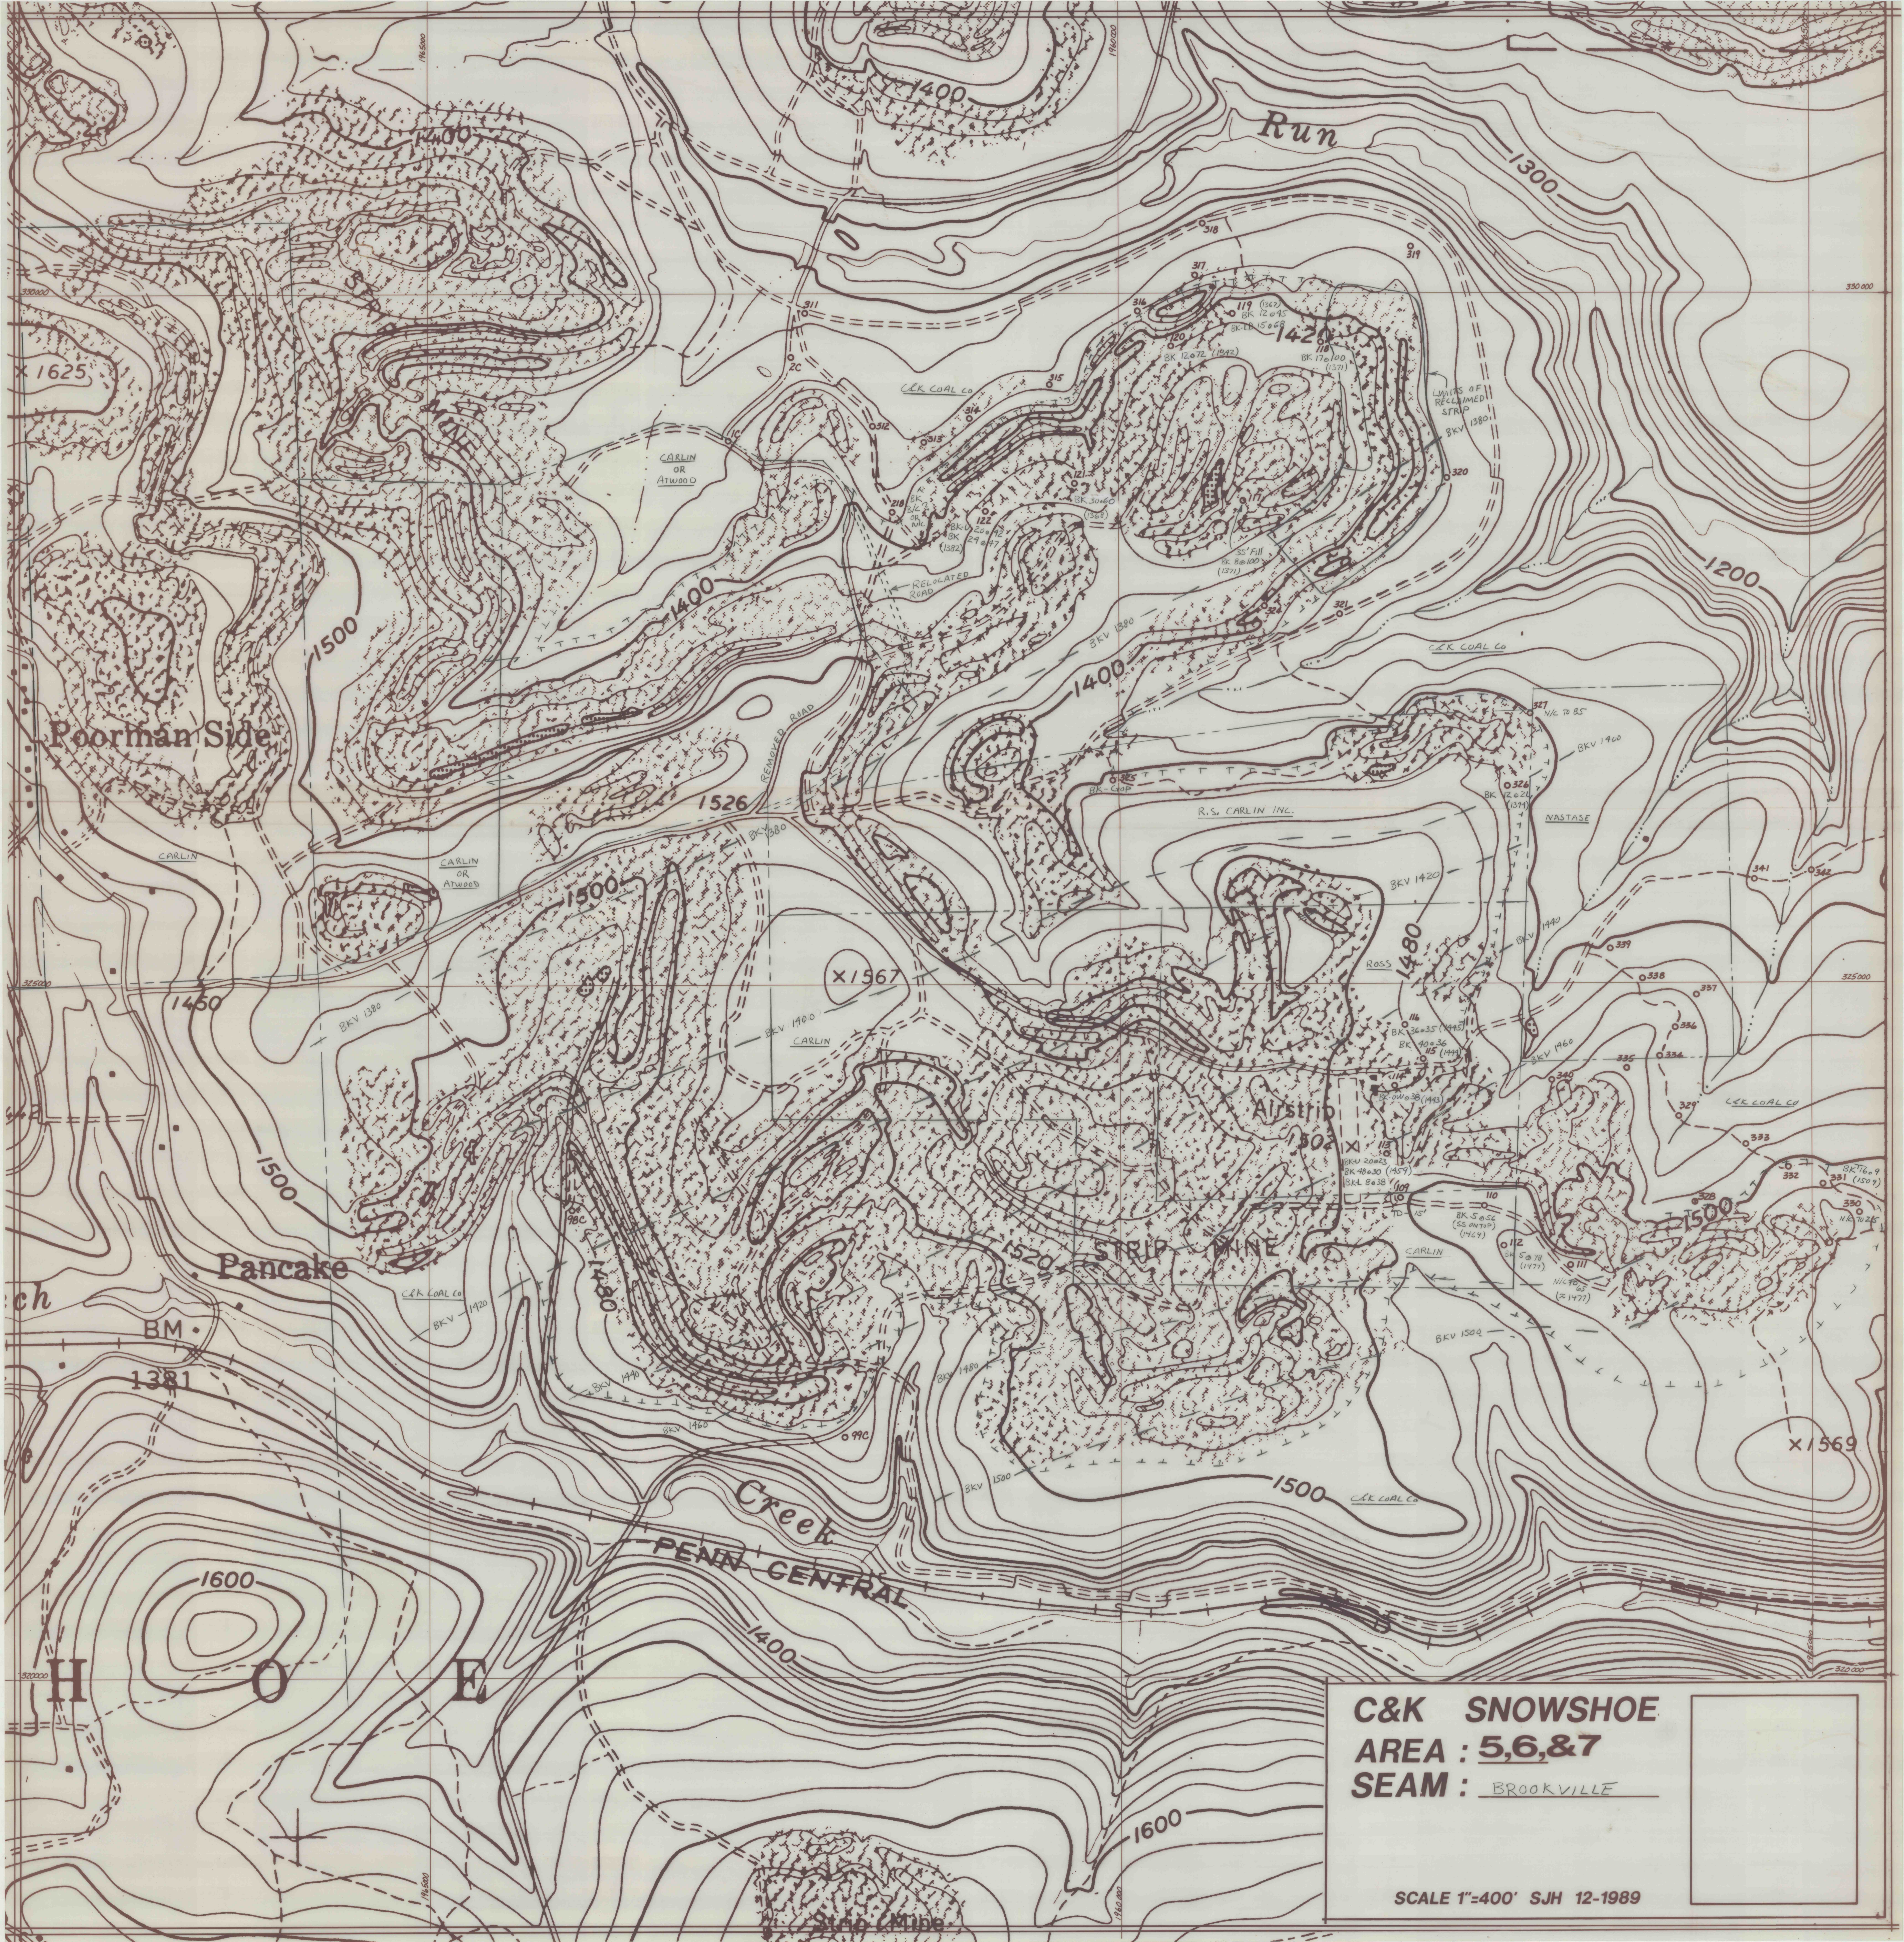

C&K SNOWSHOE
AREA : 5,6,&7
SEAM : BROOKVILLE

SCALE 1"=400' SJH 12-1989