


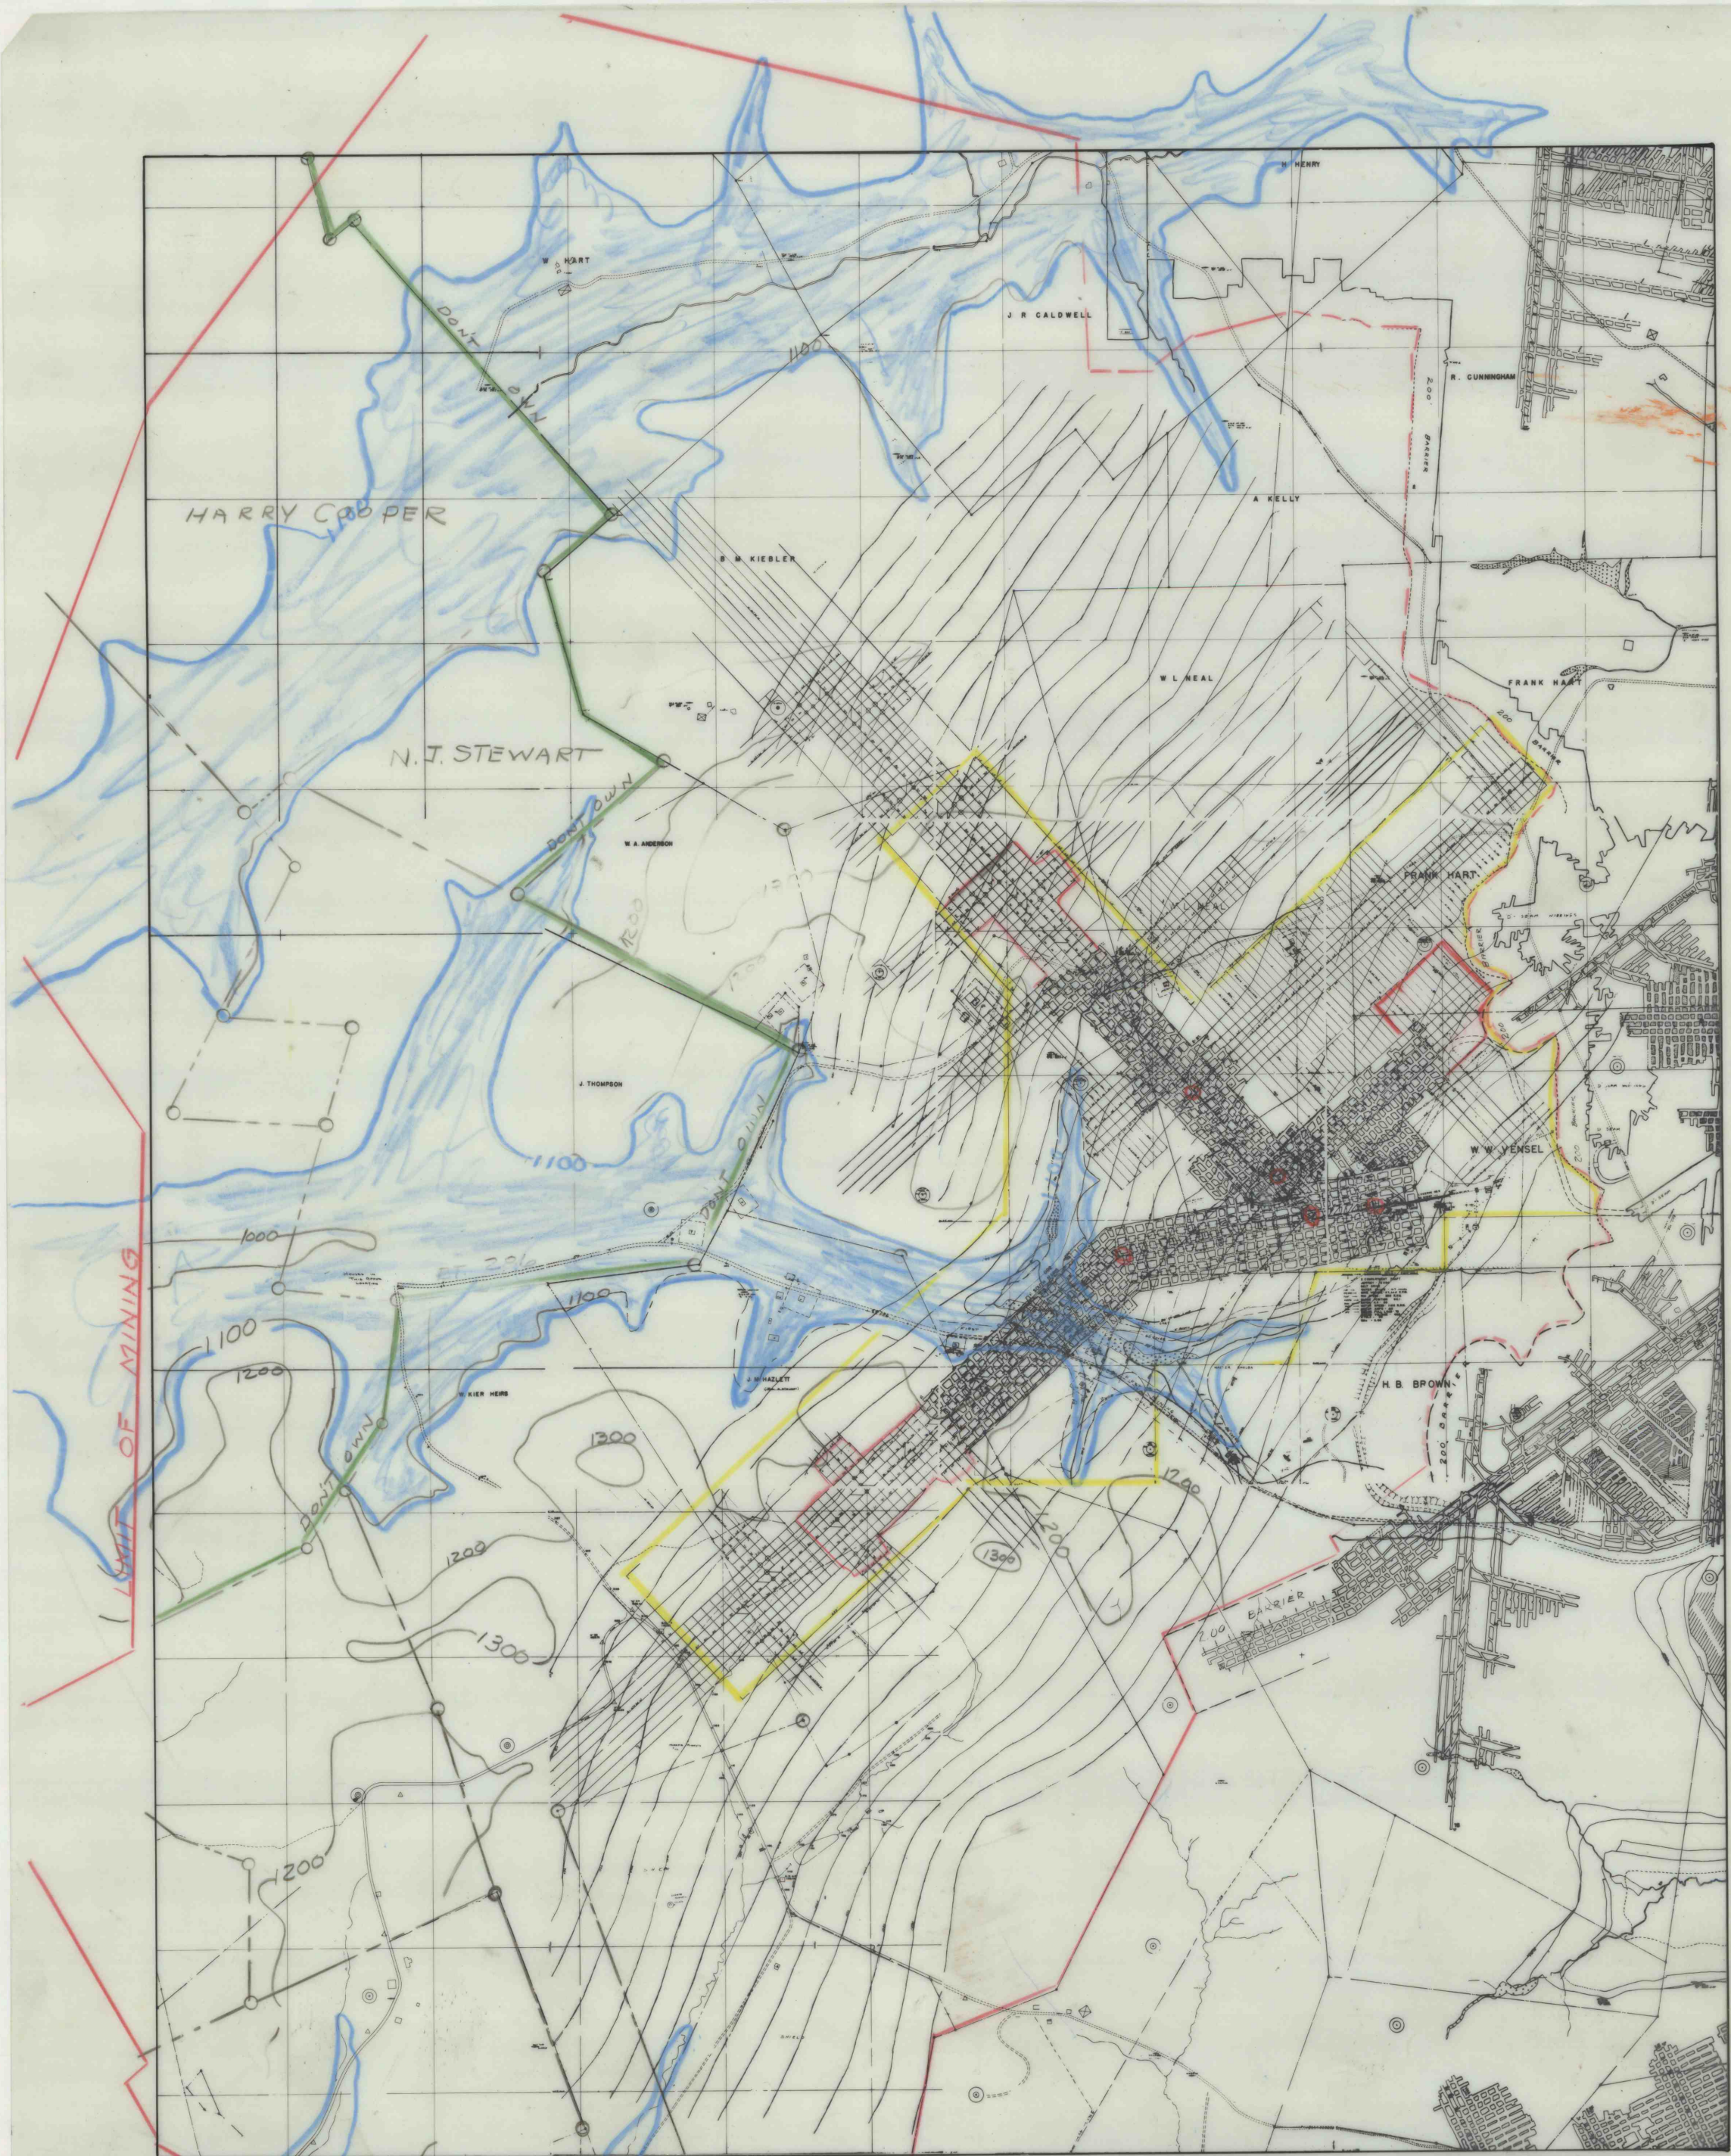

LUCERNE NO. 8
HELVETIA COAL CO.

1" = 1000
7-1-76