


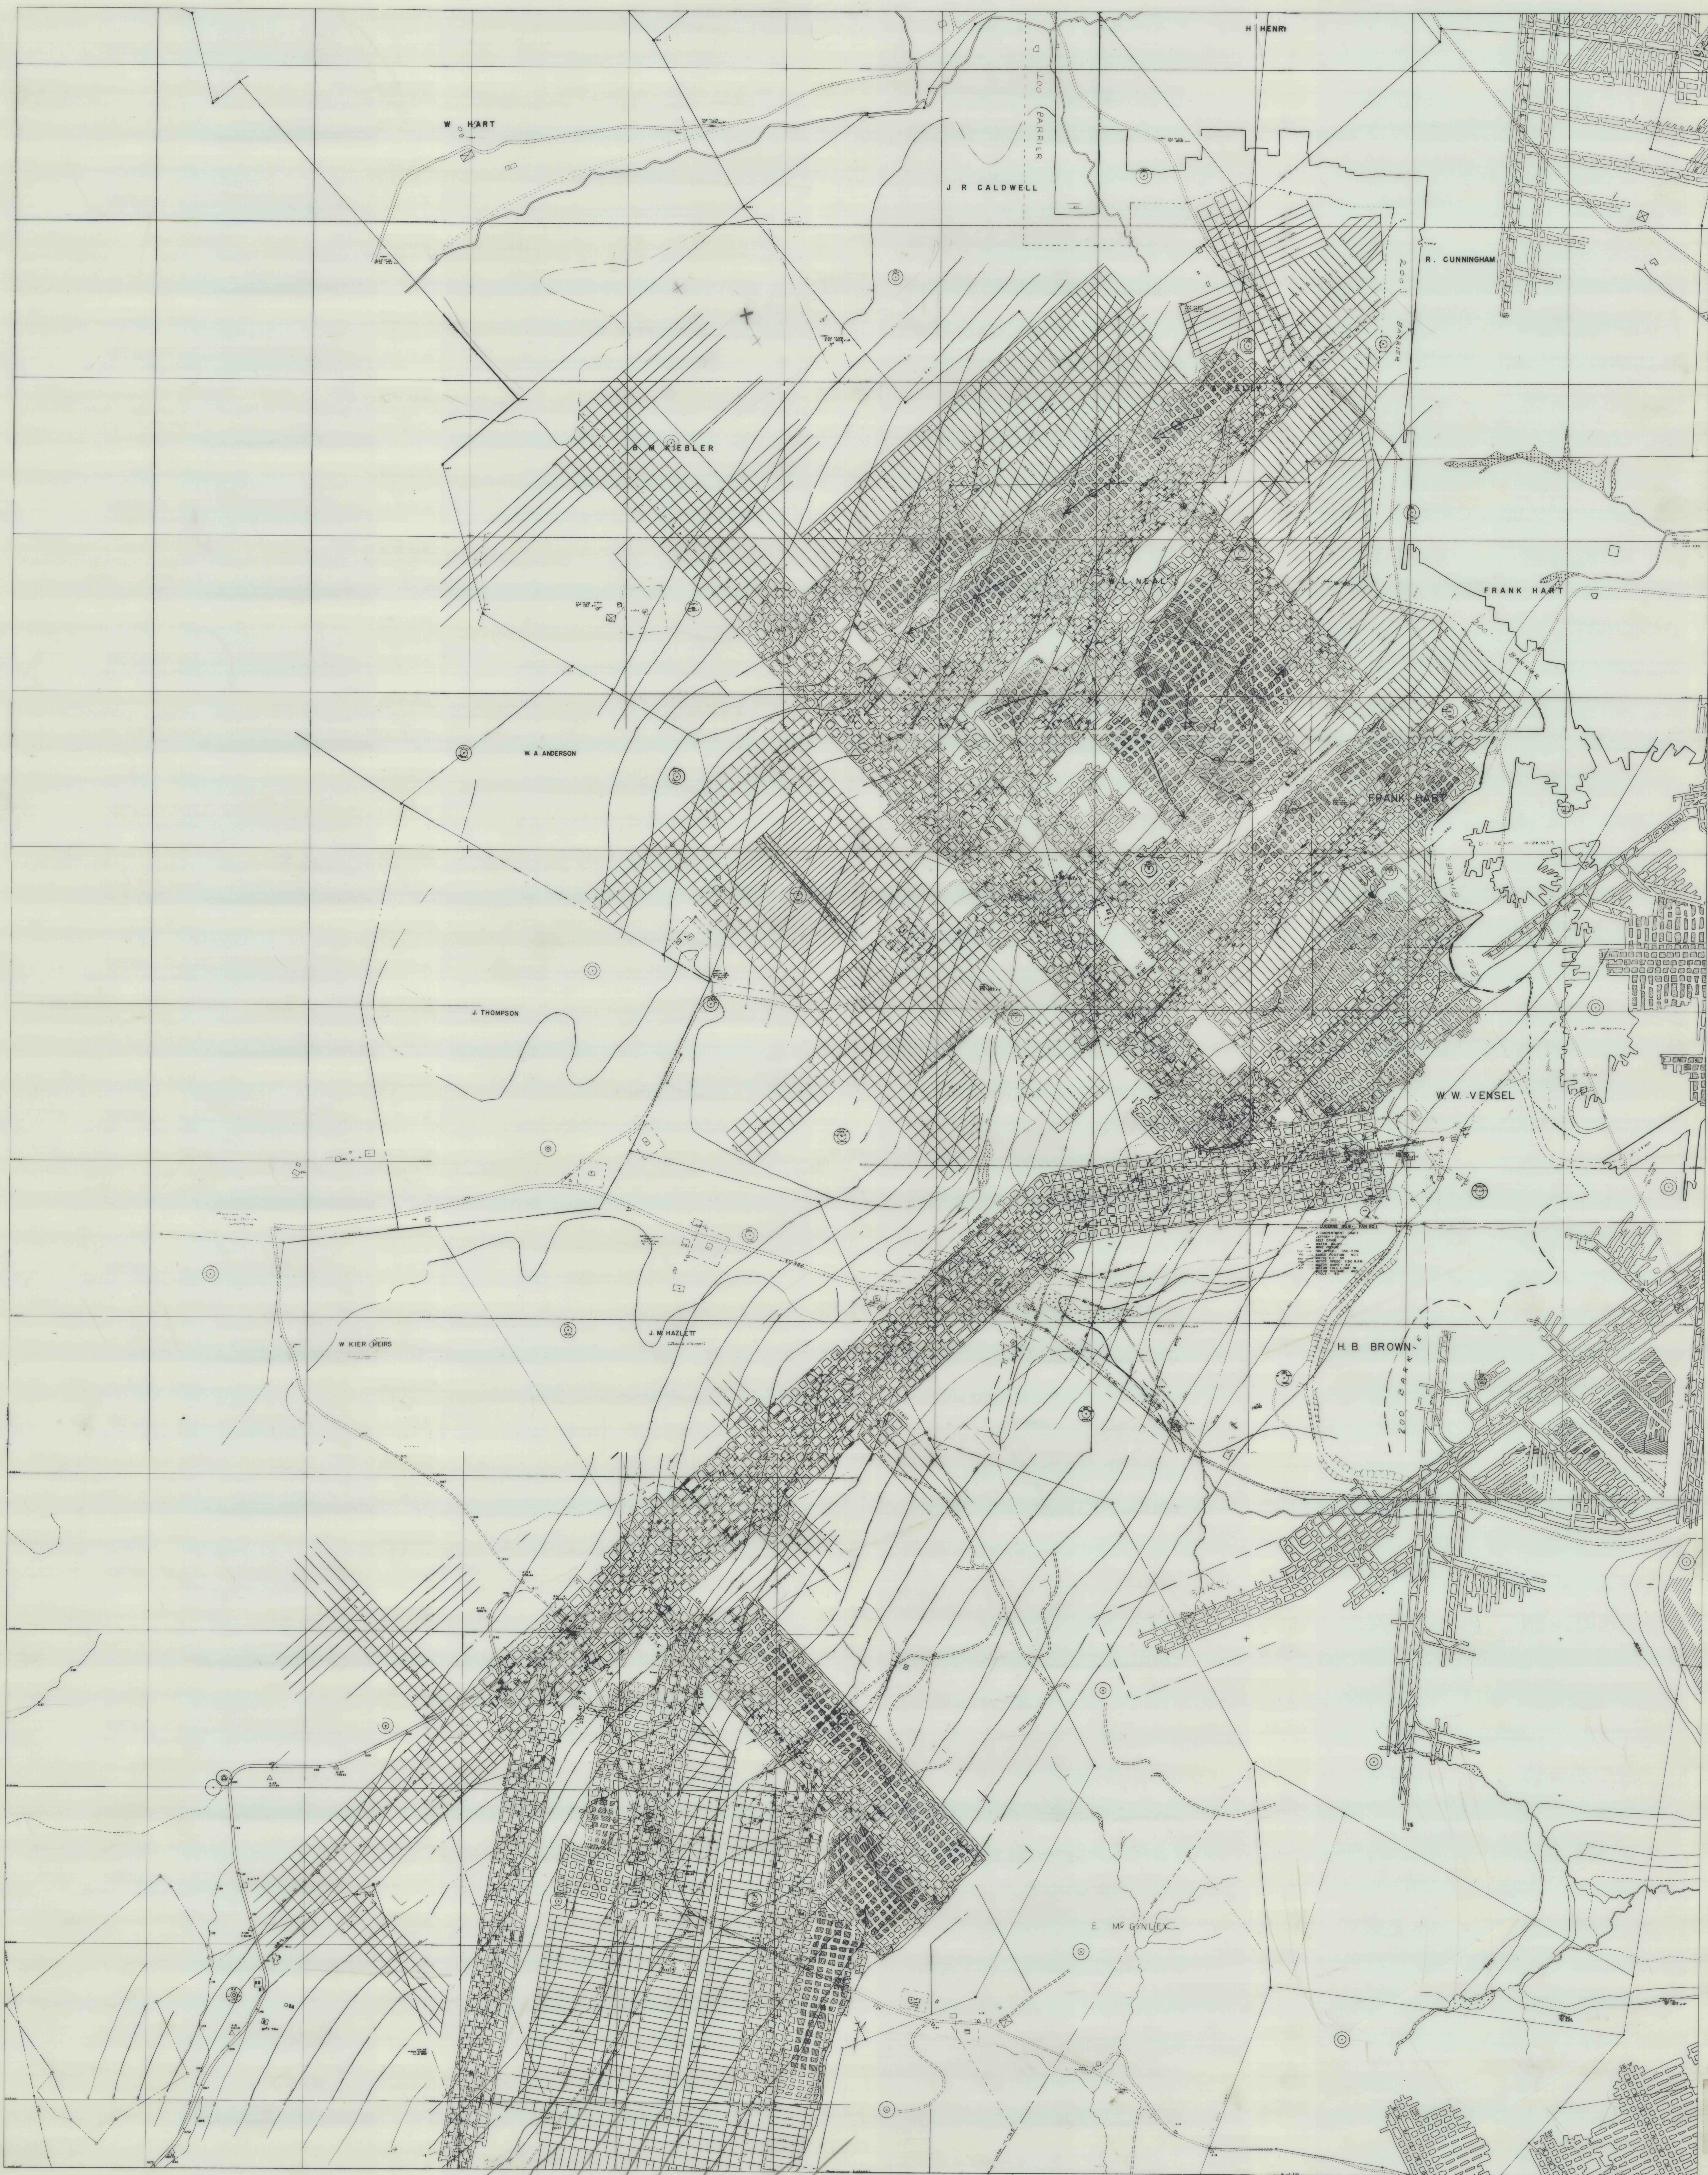

1-1-81



1"-400'

LUCERNE #8