


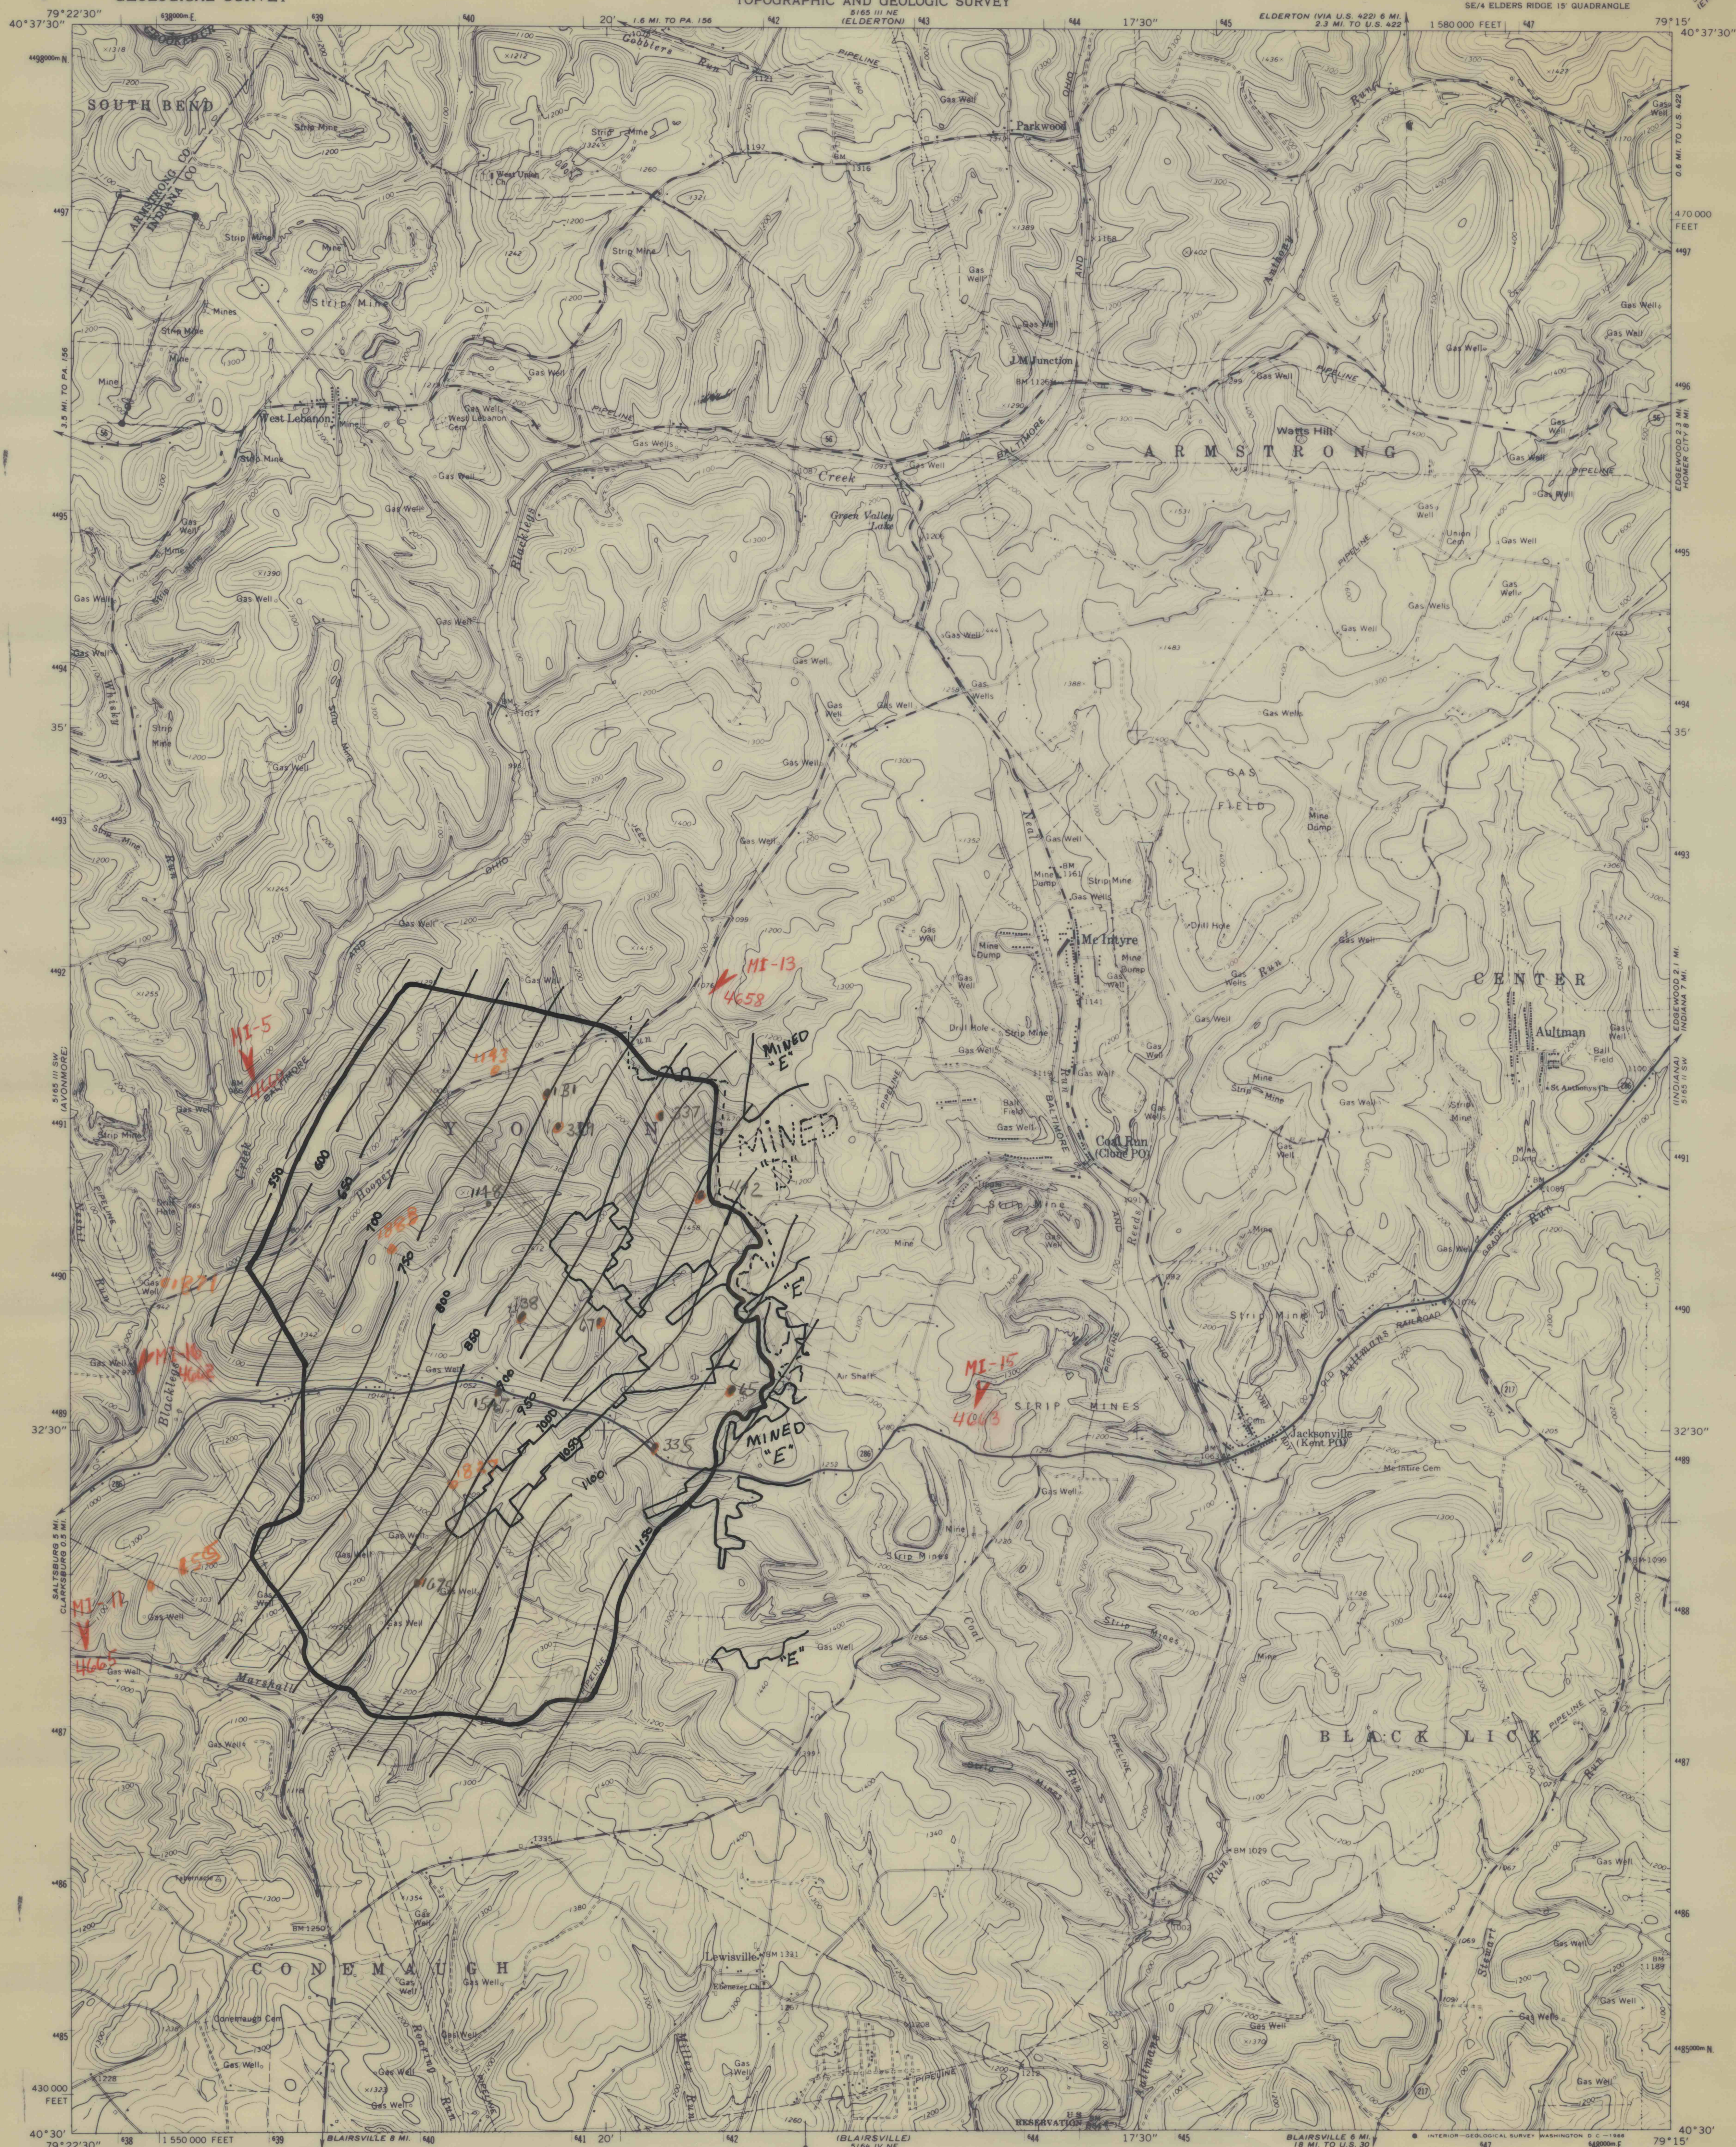

Mapped, edited, and published by the Geological Survey



Control by USGS, USC&GS, and USCE

Topography by photogrammetric methods from aerial photographs taken 1962 and 1963. Field checked 1964


Polyconic projection. 1927 North American datum
10,000-foot grid based on Pennsylvania coordinate system, south zone
1000-meter Universal Transverse Mercator grid ticks,
zone 17, shown in blue

Fine red dashed lines indicate selected fence and field lines where generally visible on aerial photographs. This information is unchecked

U.S. Reservation boundary from maps by U.S. Corps of Engineers
Area covered by dashed light-blue pattern is subject to controlled
inundation to 975 feet by Conemaugh Dam

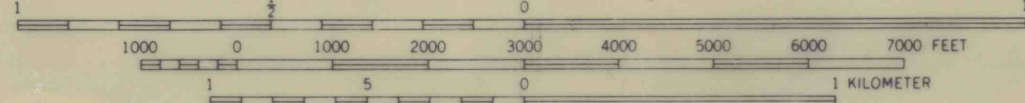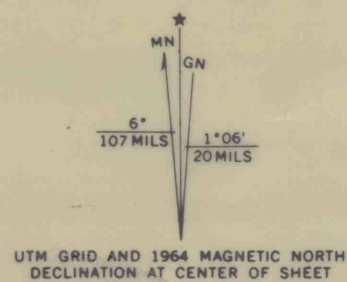

CONTOUR INTERVAL 20 FEET
DATUM IS MEAN SEA LEVEL

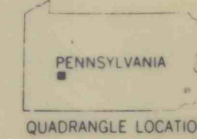

ROAD CLASSIFICATION
Heavy-duty ——— Light-duty ———
Medium-duty ——— Unimproved dirt ———
○ State Route

MCINTYRE, PA.
SE/4 ELDERS RIDGE 15' QUADRANGLE
N4030-W7915/7.5

1964

AMS 5165 III SE-SERIES V.831