


6

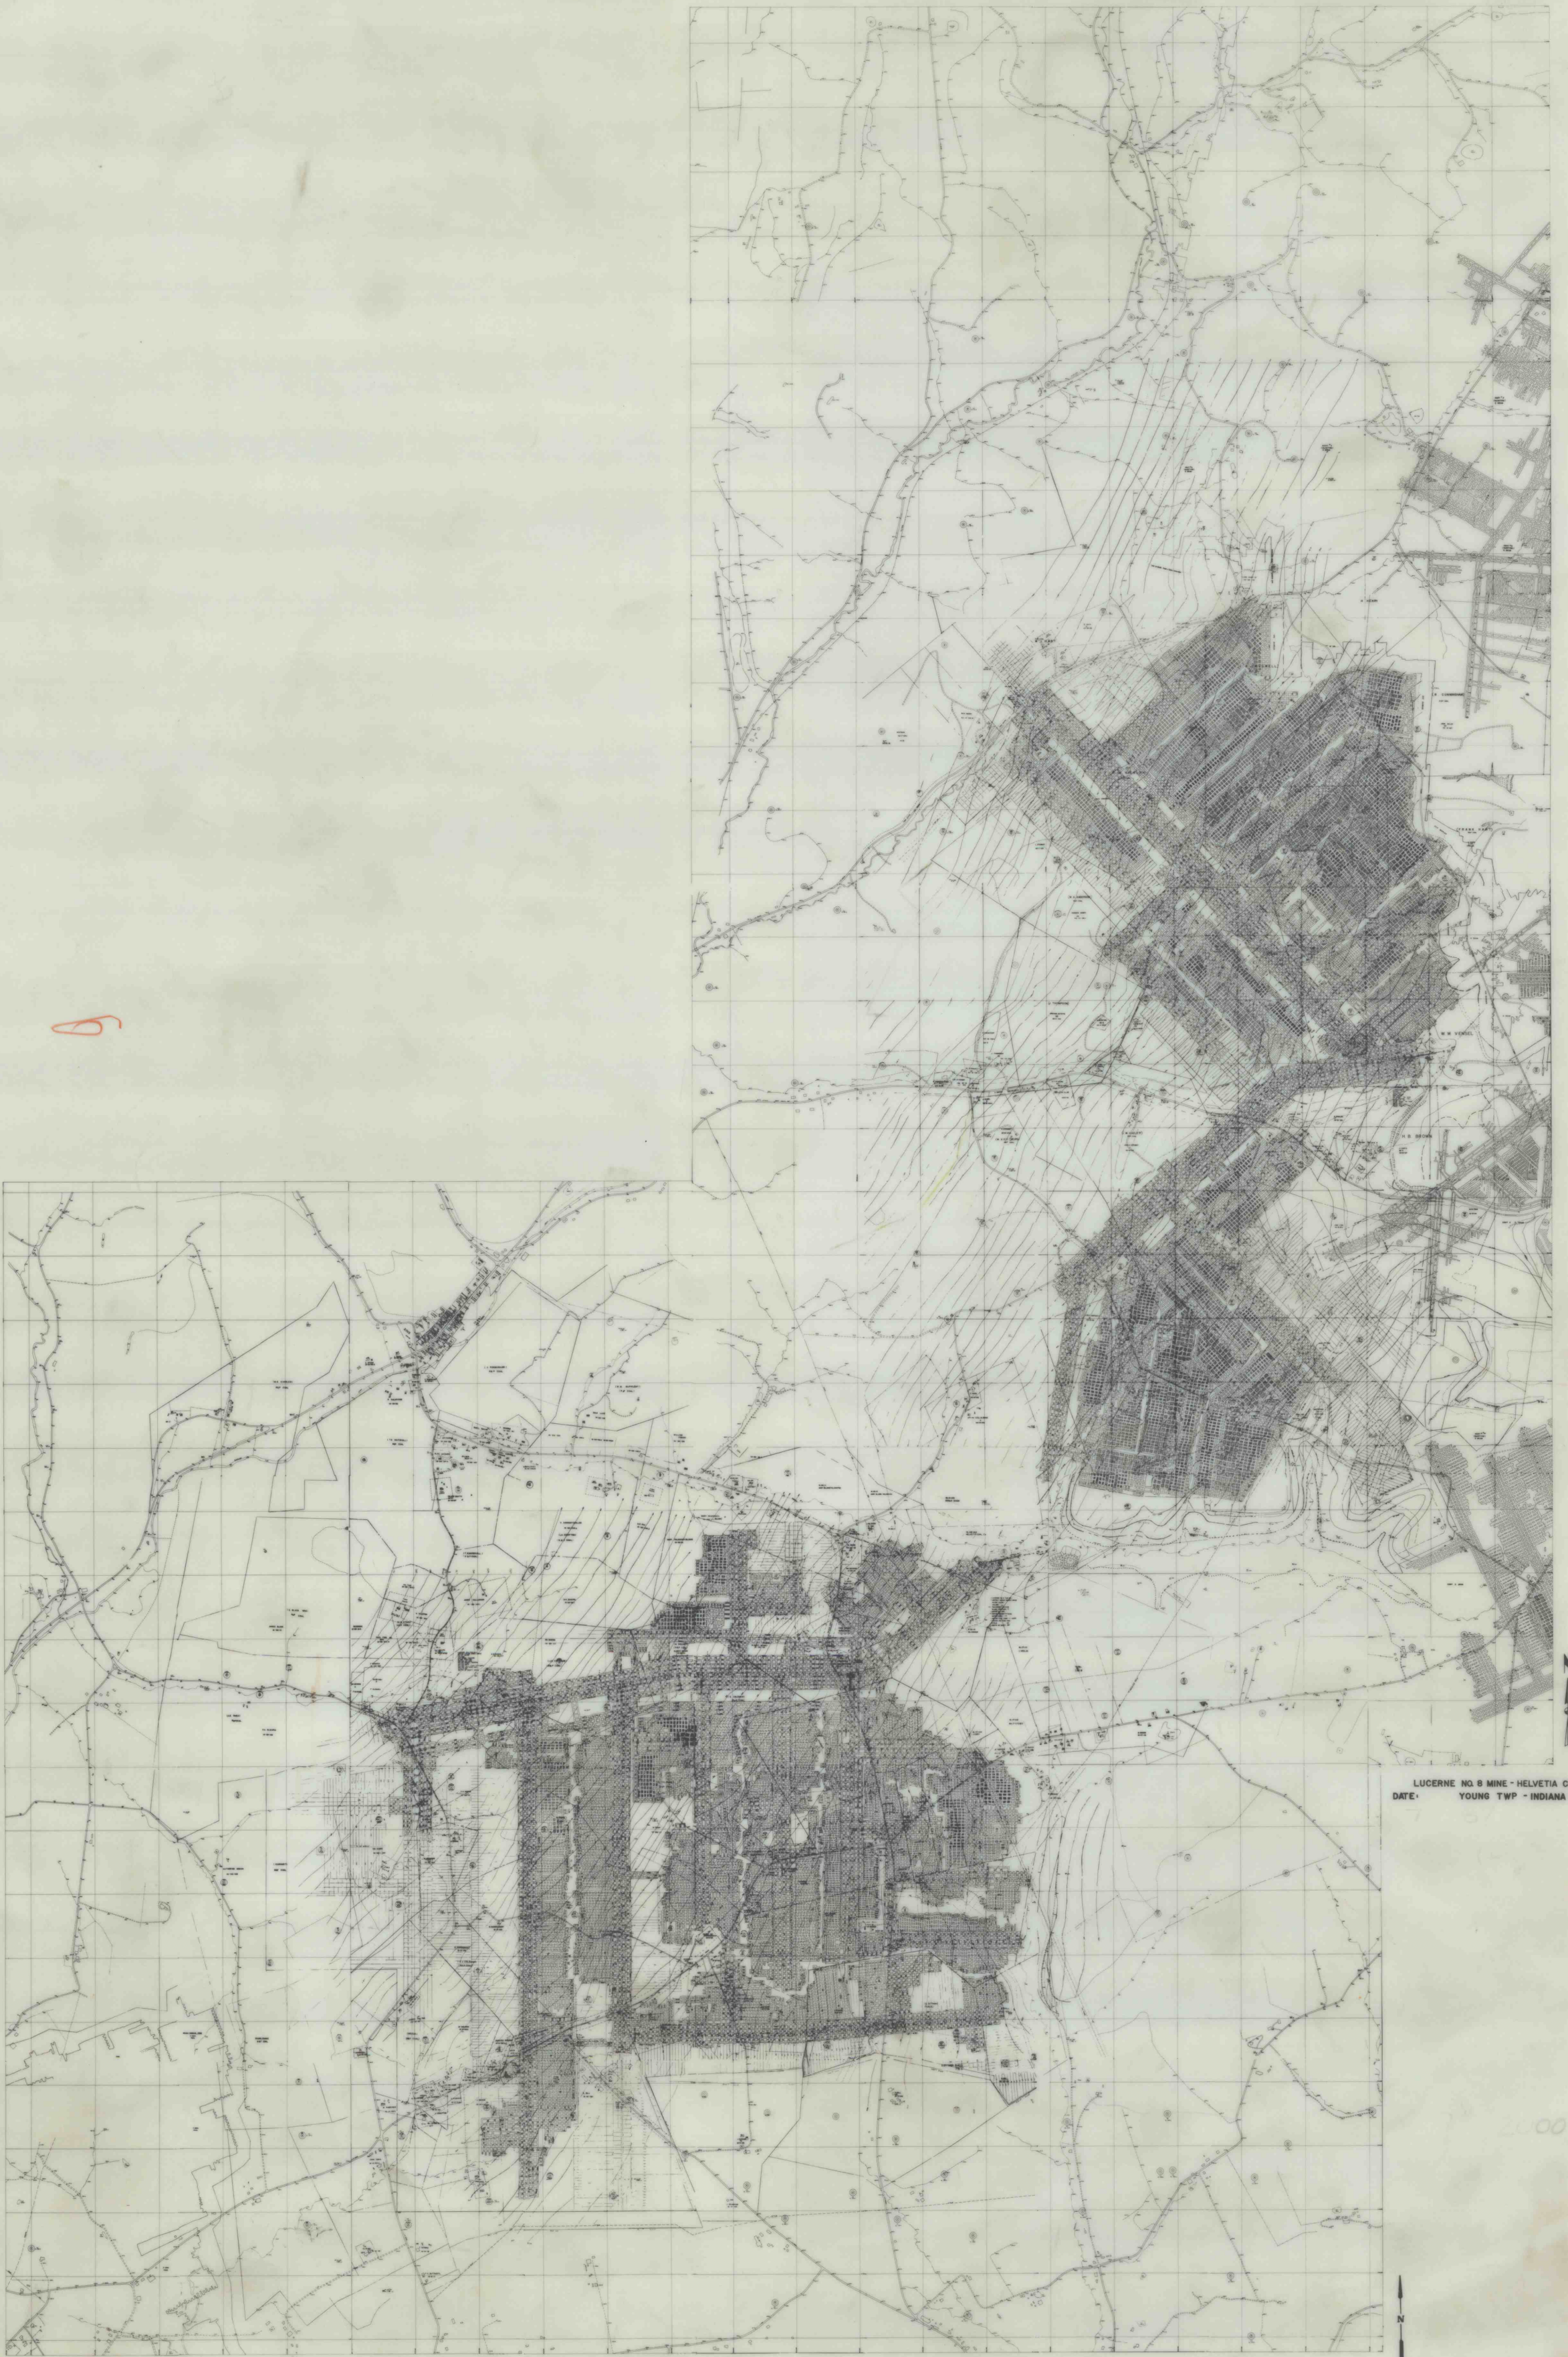

LUCERNE NO. 8 MINE - HELVETIA COAL CO.
DATE: YOUNG TWP - INDIANA CO, PA.

LUCERNE 9 MINE DATE 1"