


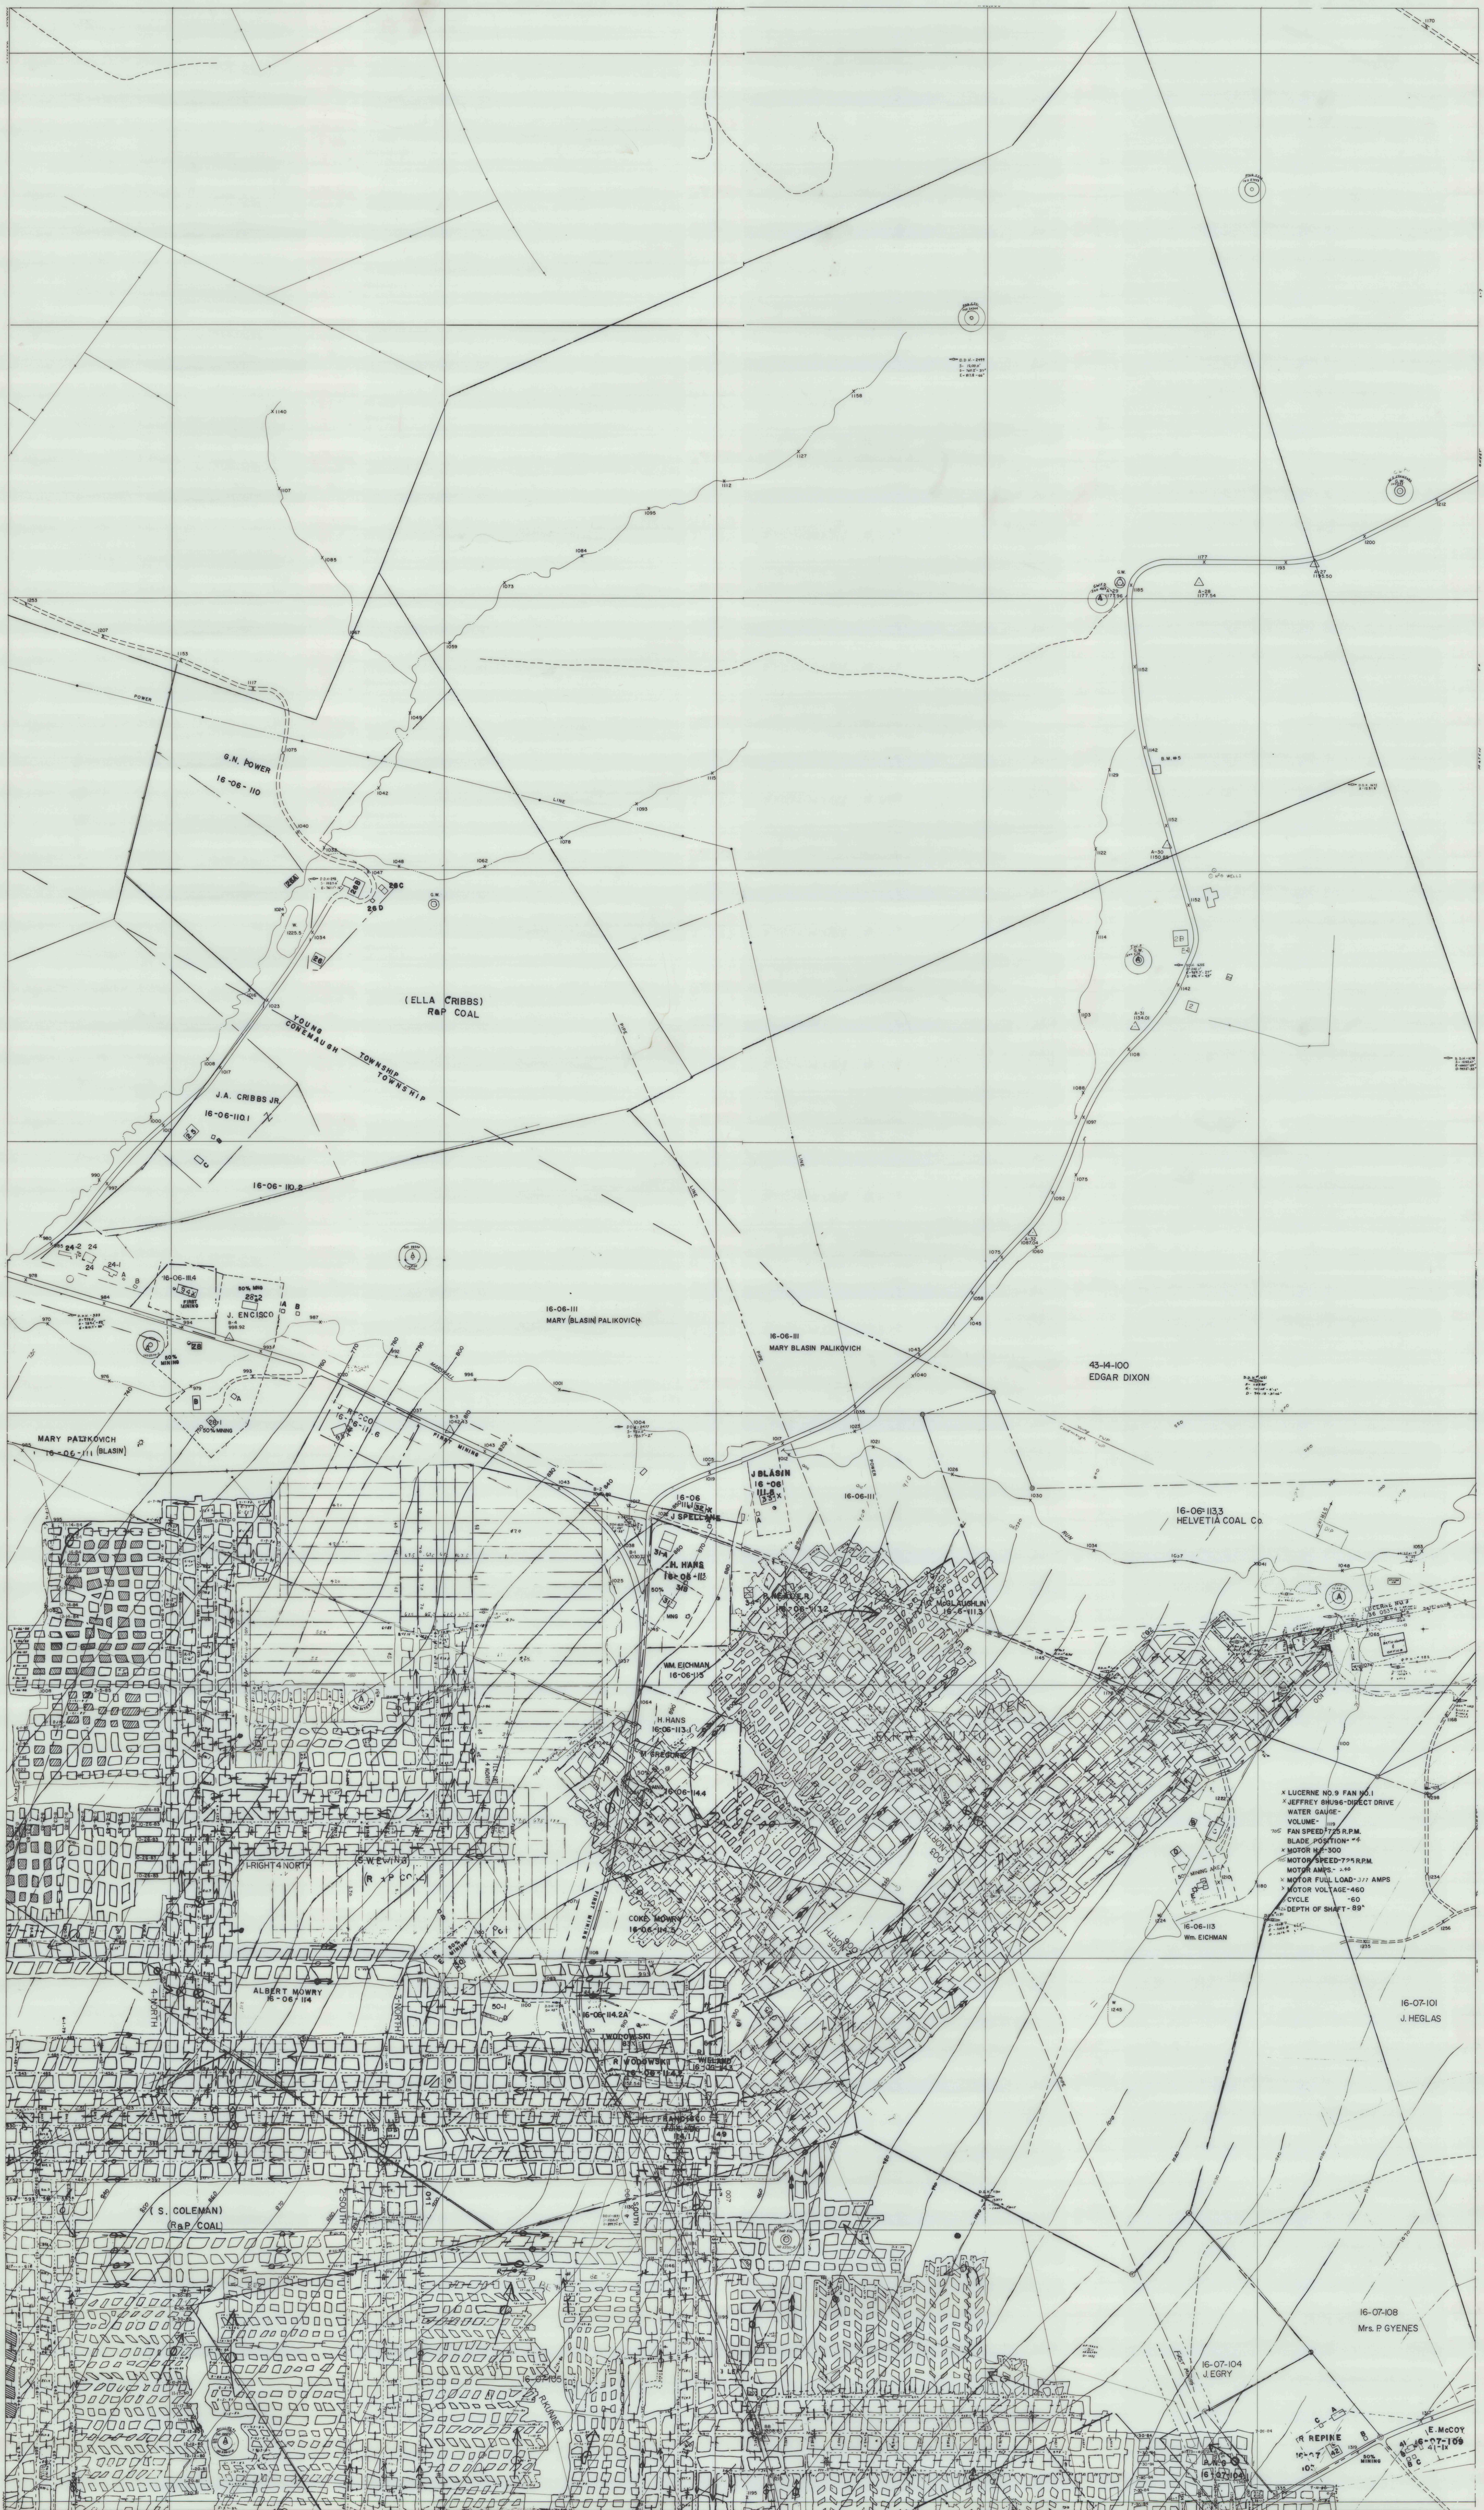

* LUCERNE NO. 9 FAN NO. 1
* JEFFREY BRUSH DIRECT DRIVE
WATER GAUGE -
VOLUME - 100
* MOTOR H.P. - 300
MOTOR AMPS - 140
* MOTOR FULL LOAD - 277 AMPS
* MOTOR VOLTAGE - 460
CYCLE - 60
* DEPTH OF SHAFT - 85'