


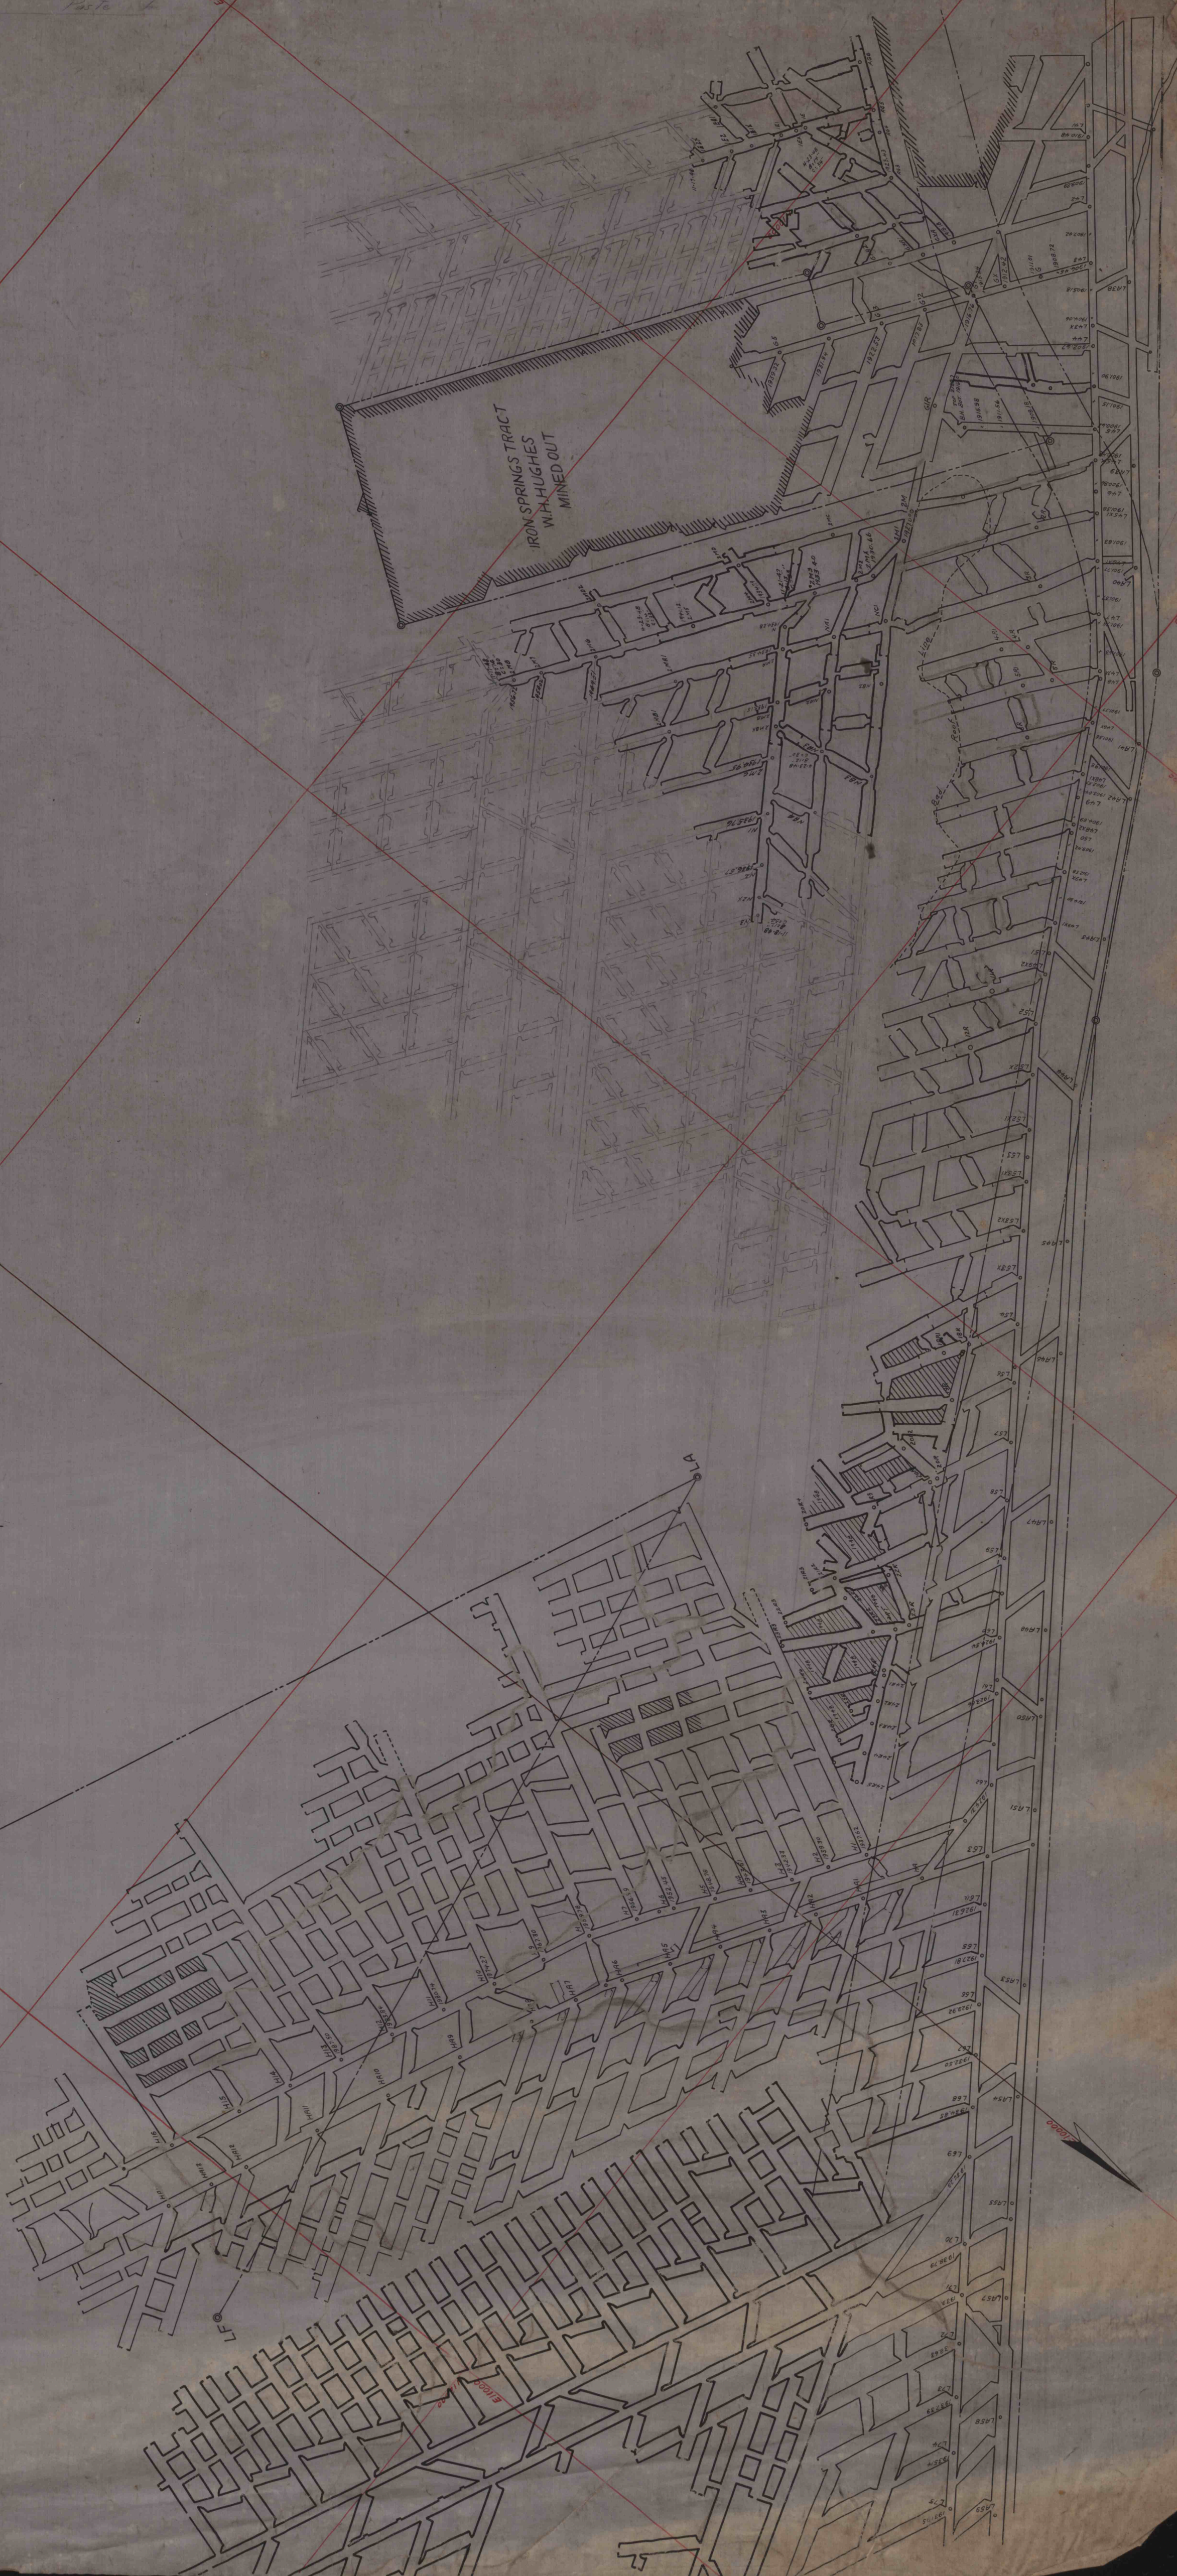

IRON SPRINGS TRACT
WITH HUGHES
MINED OUT

