


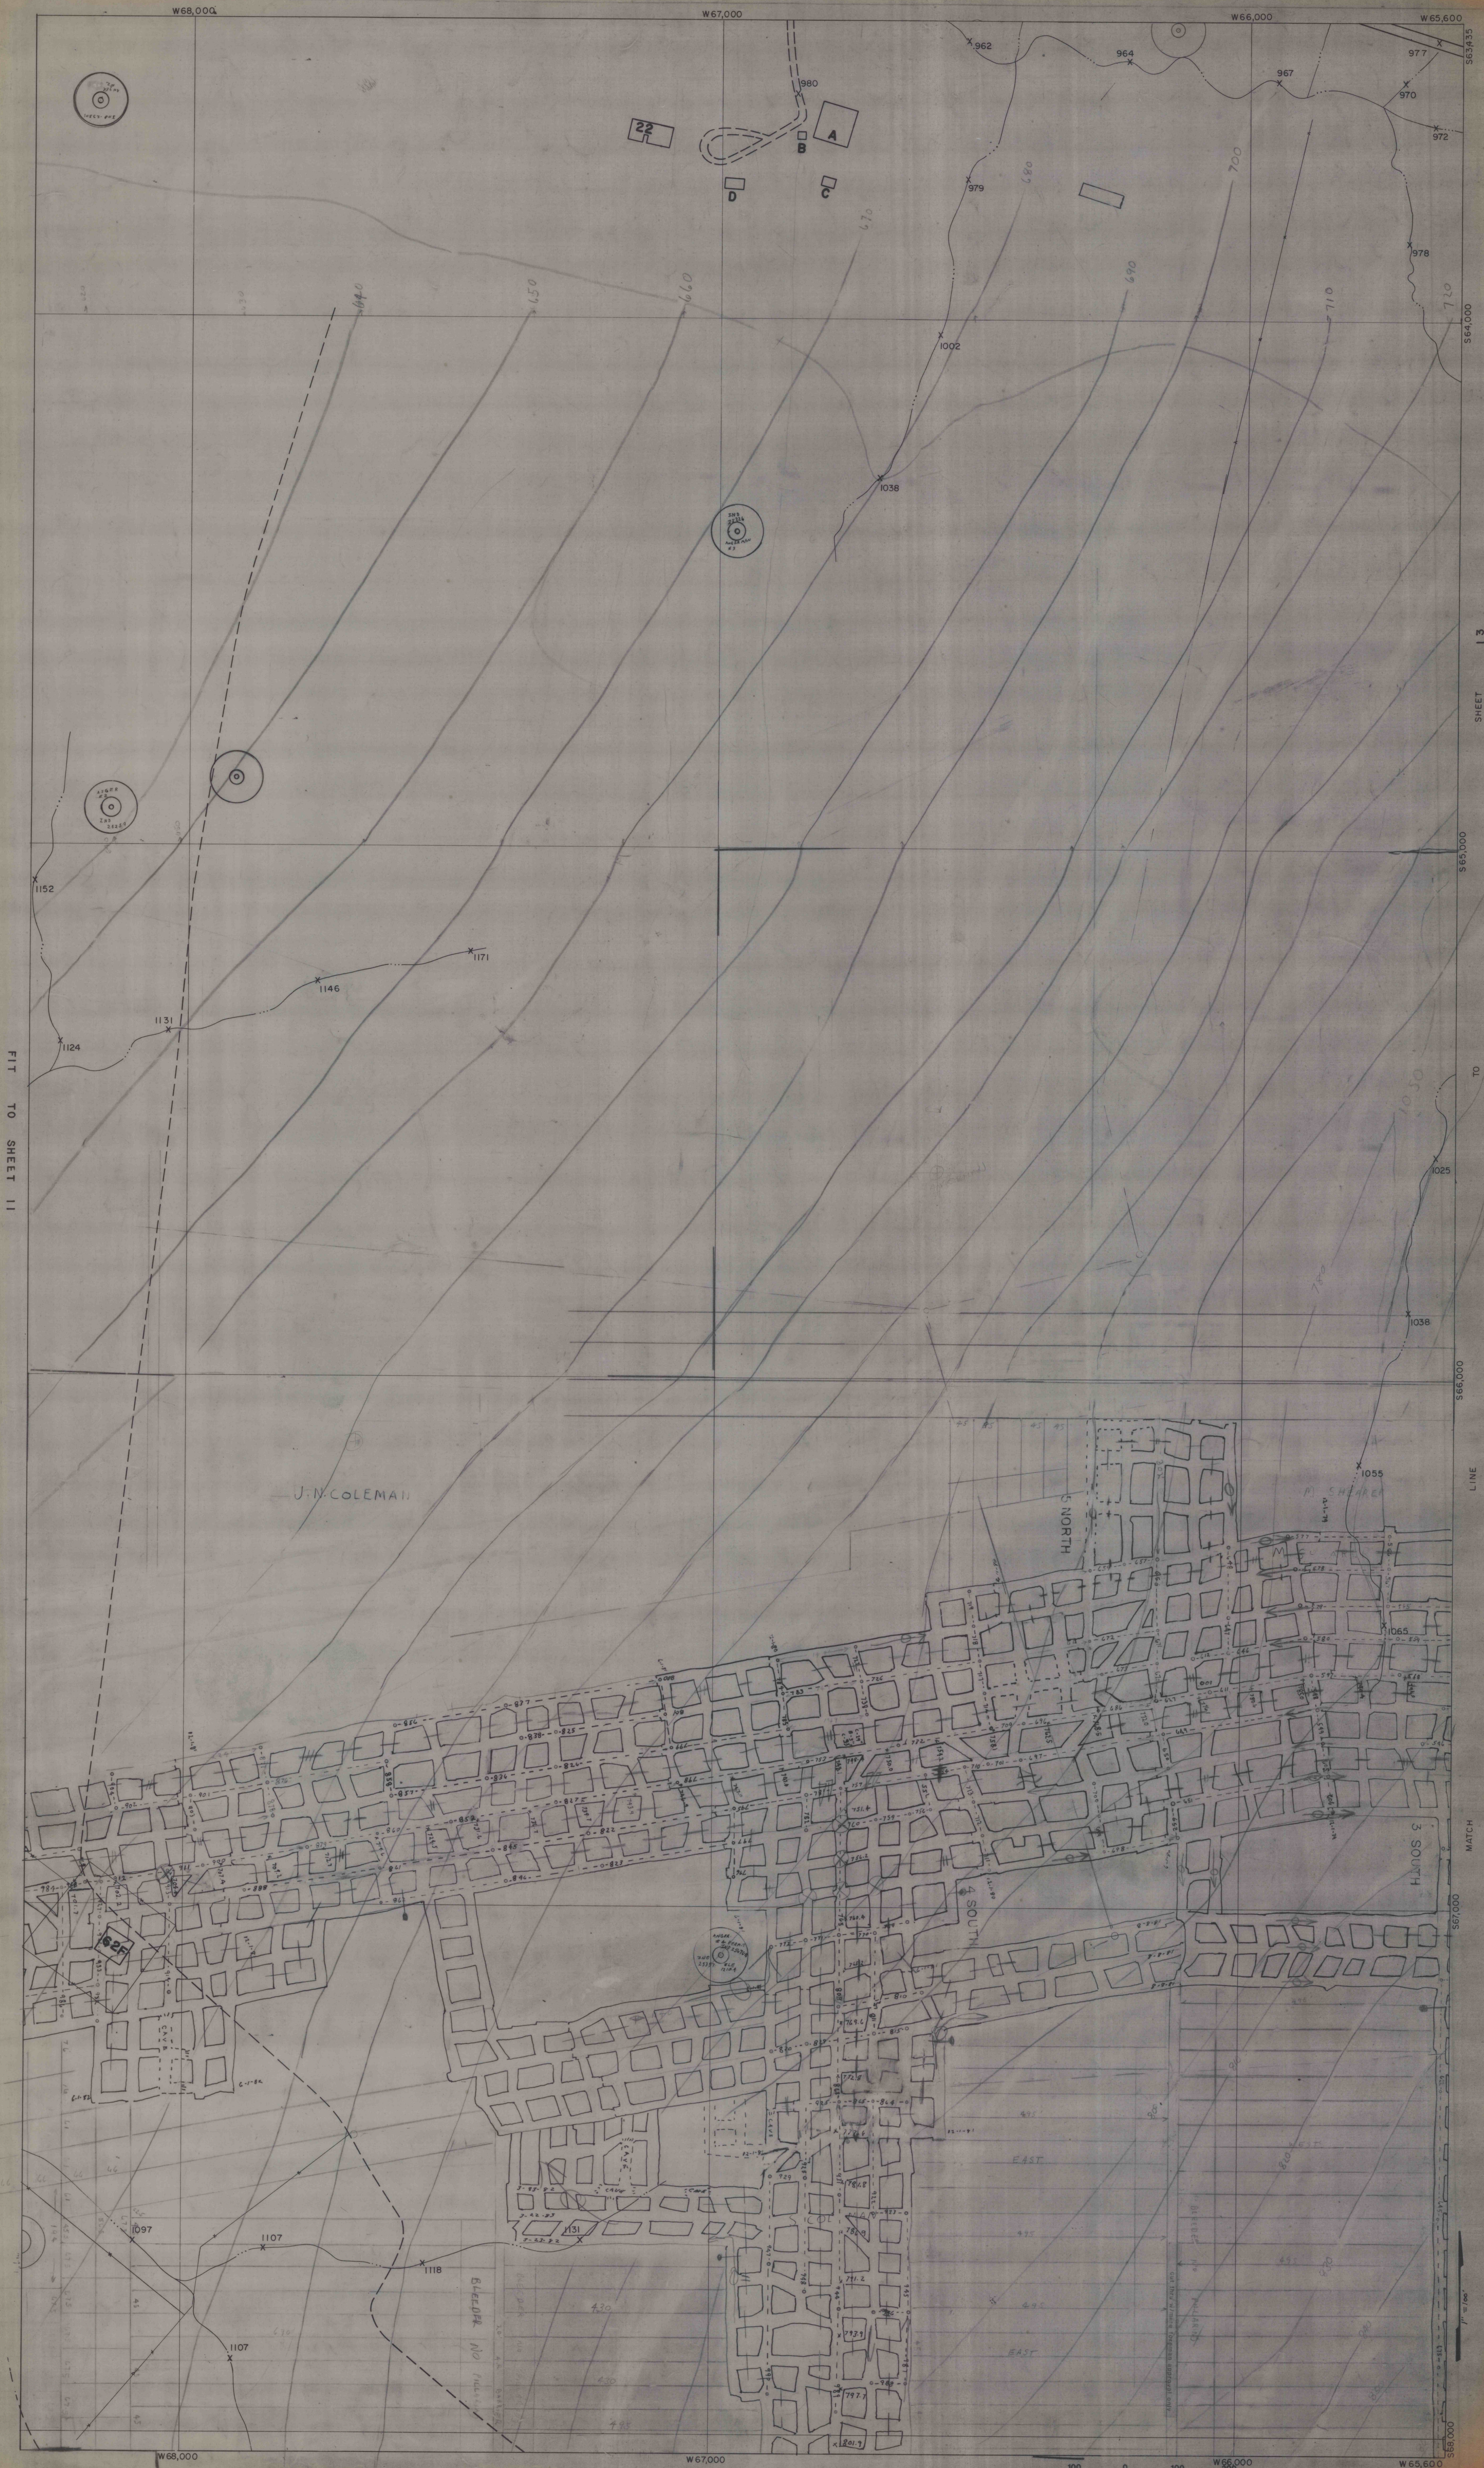

11 TO SHEET 11

13 SHEET 13 TO

LINE MATCH

1"=100' scale 0 100 200 feet

L12