


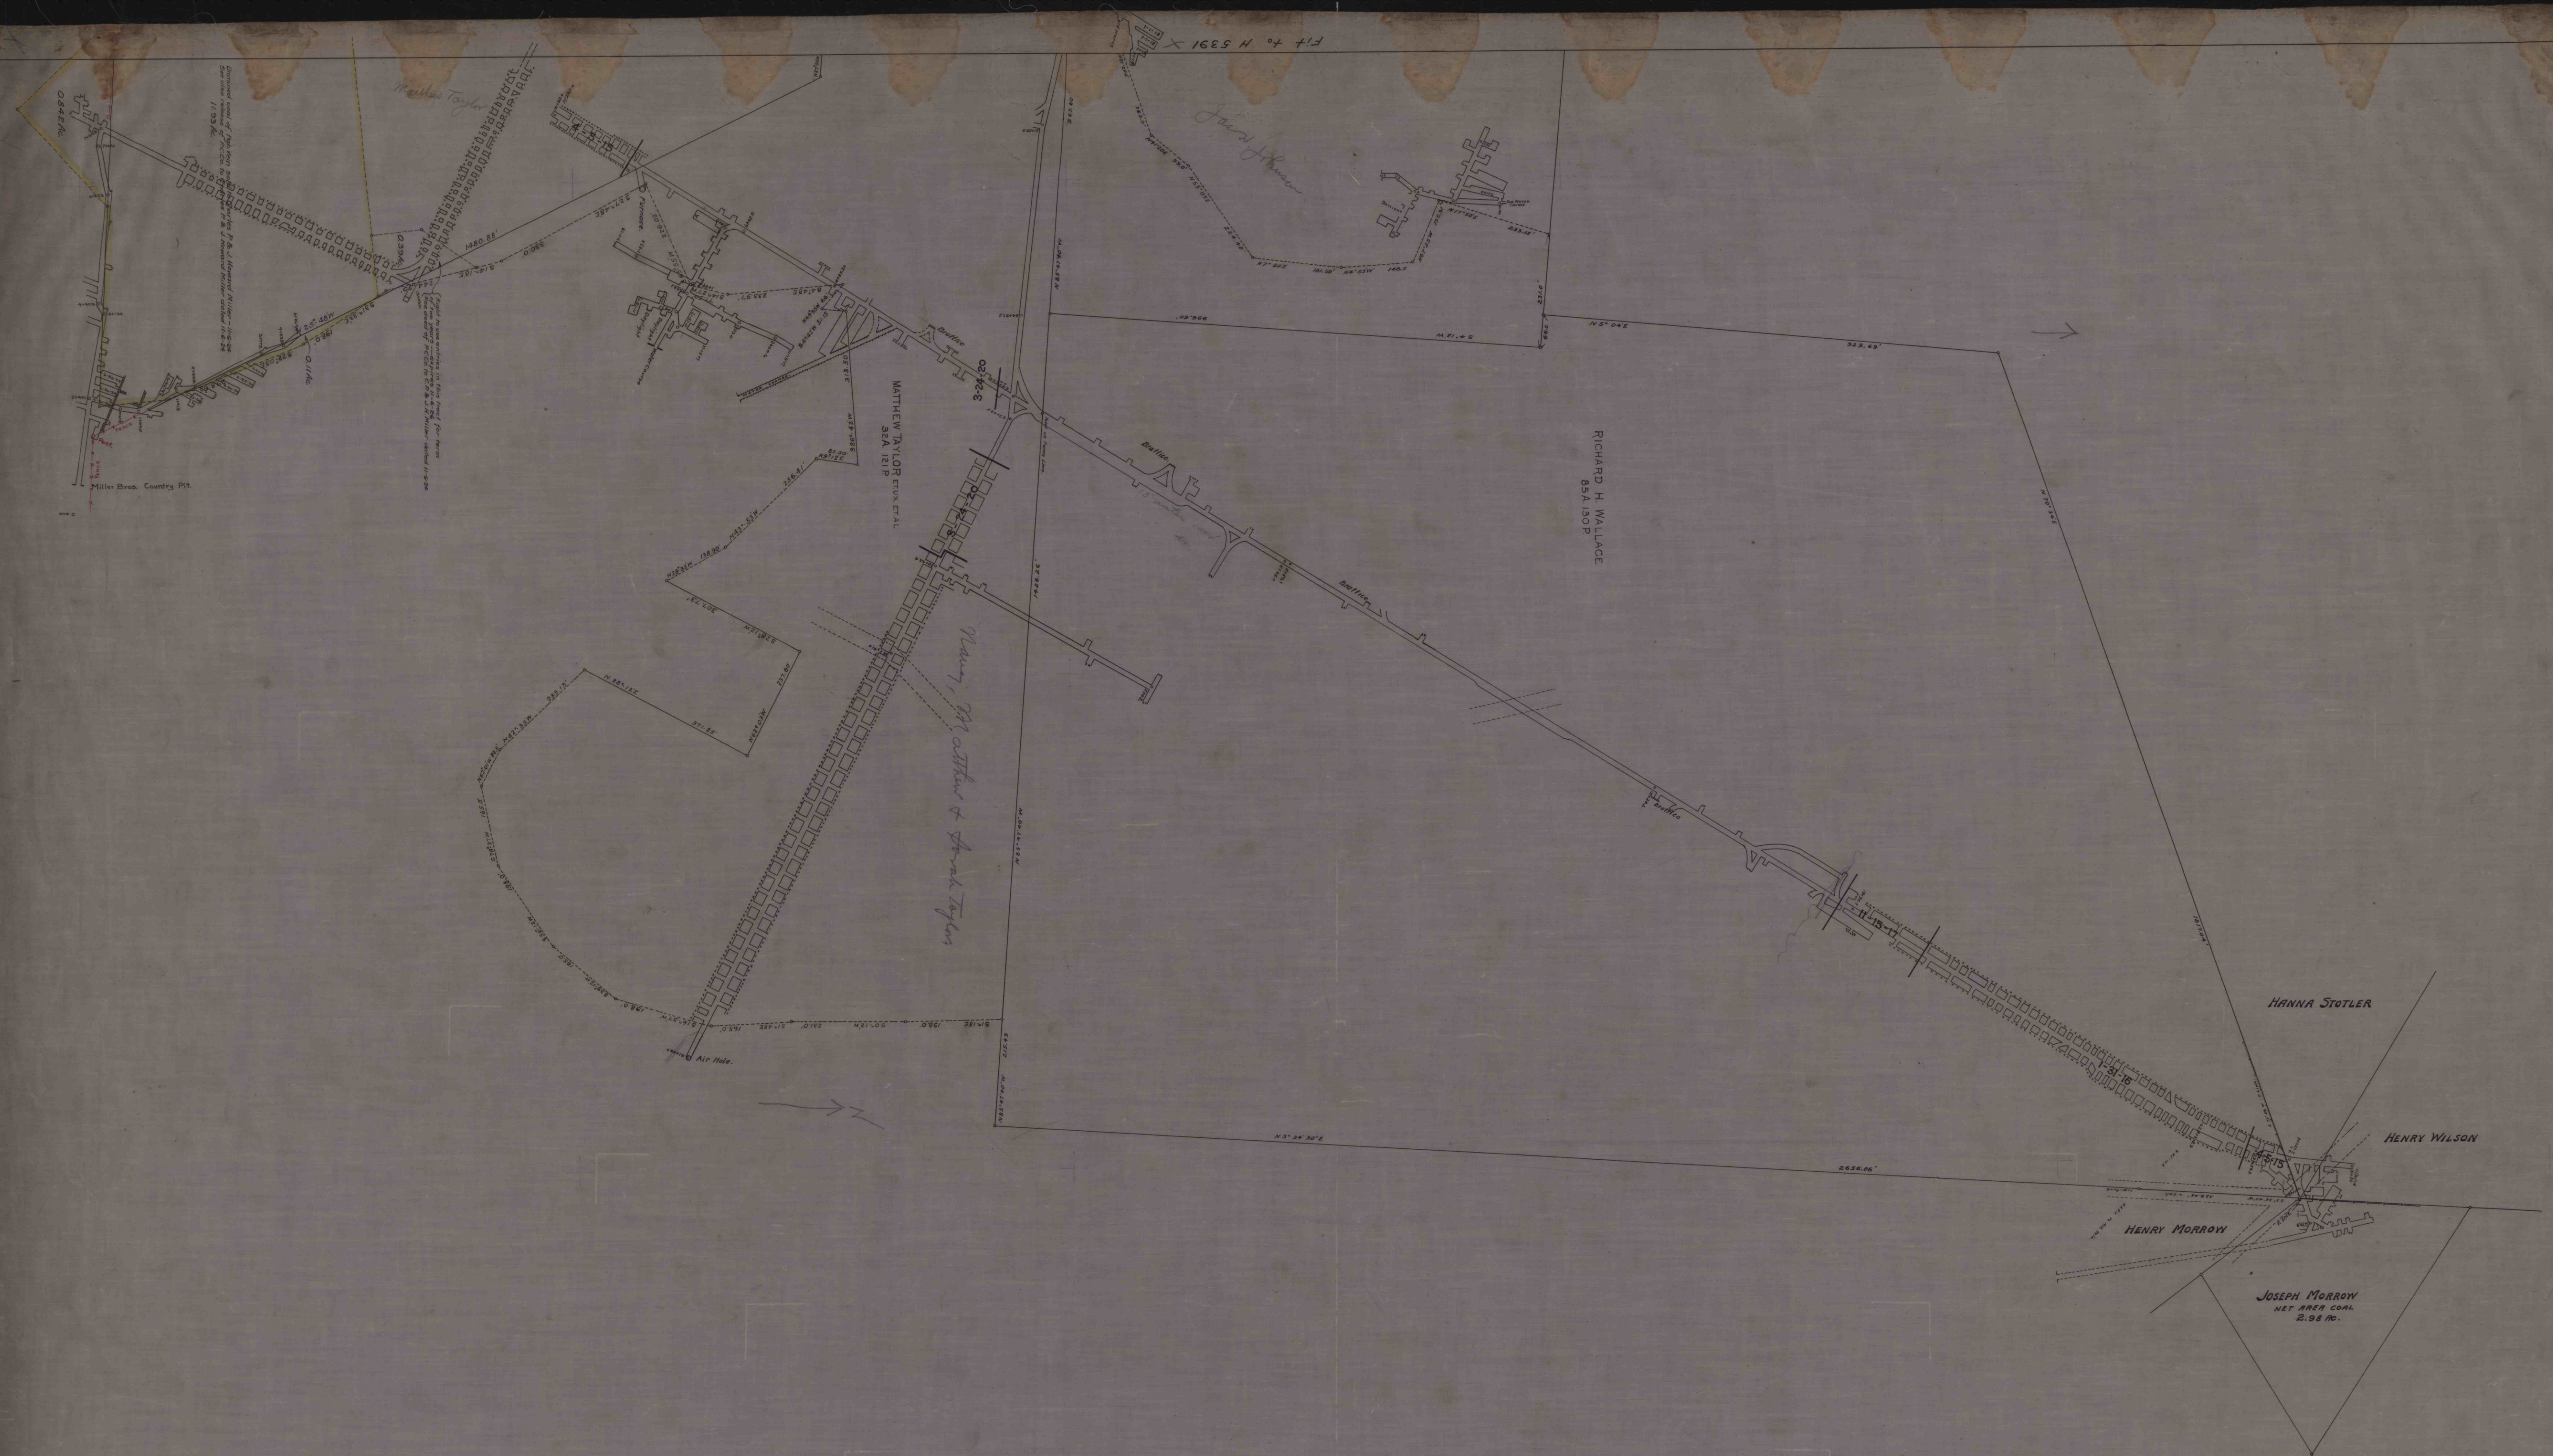

Miller Brook, Country Pitt