


7 6625 H

7 6625 H 411

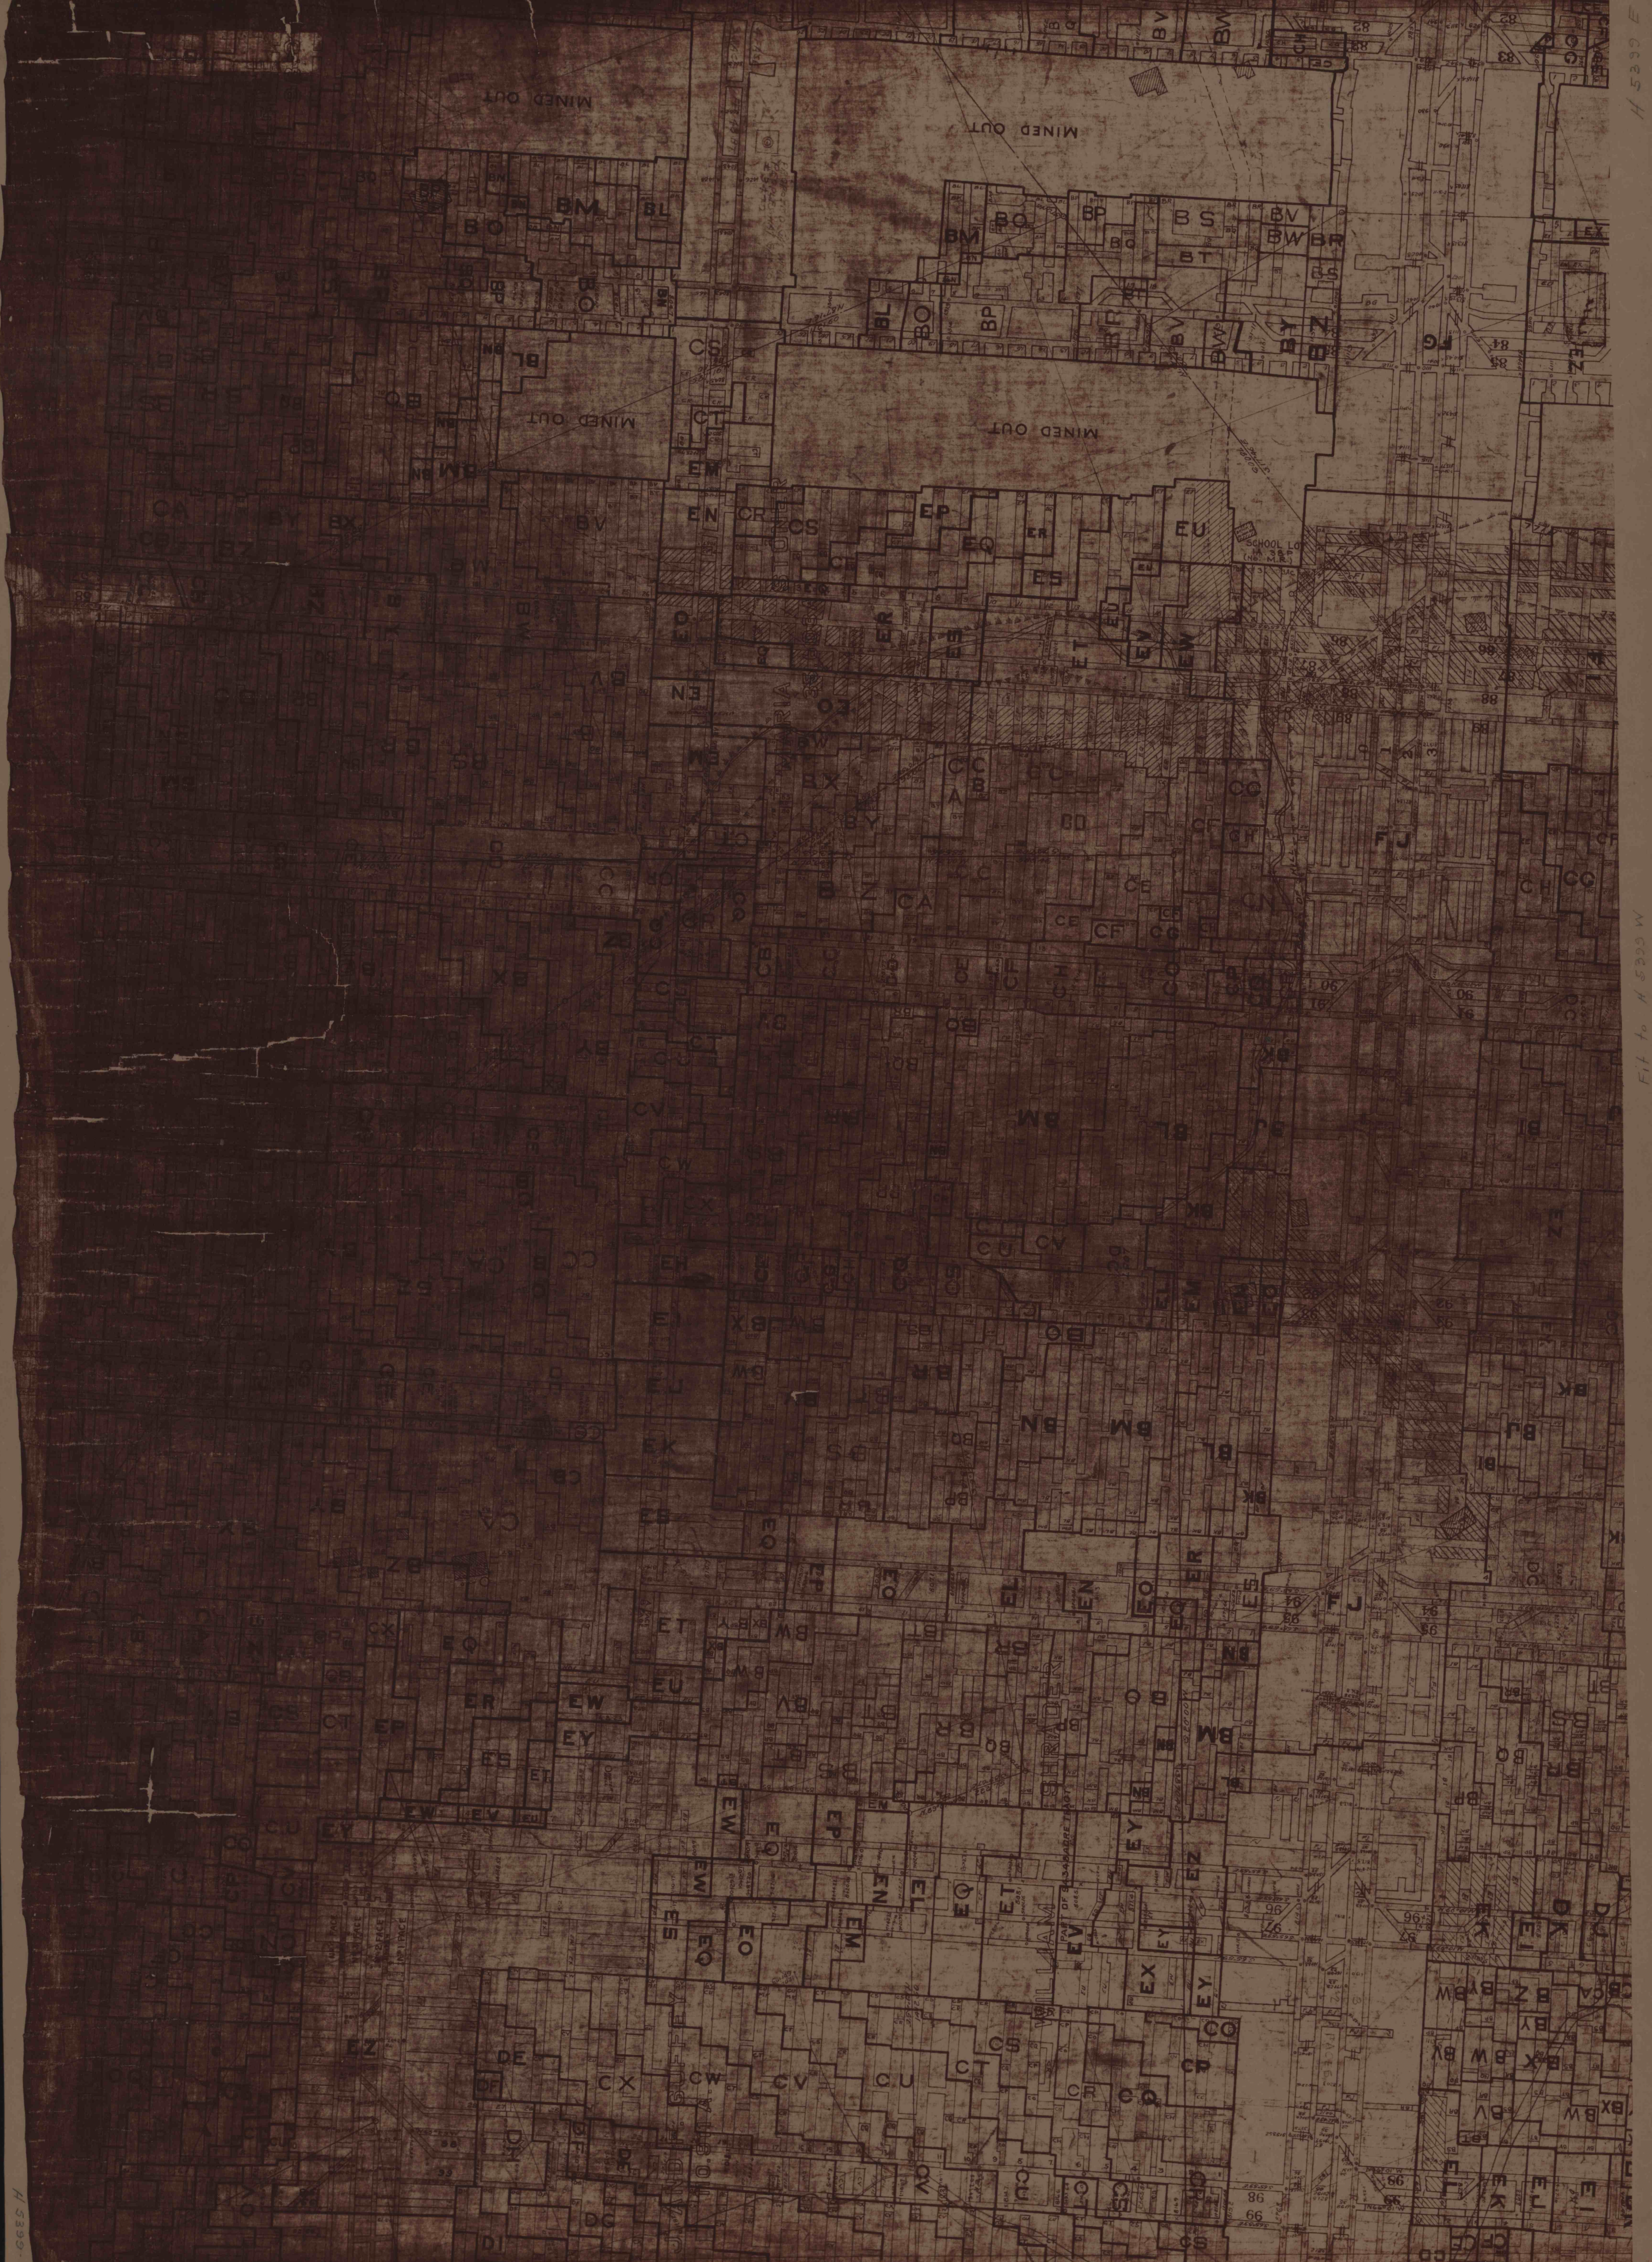

