


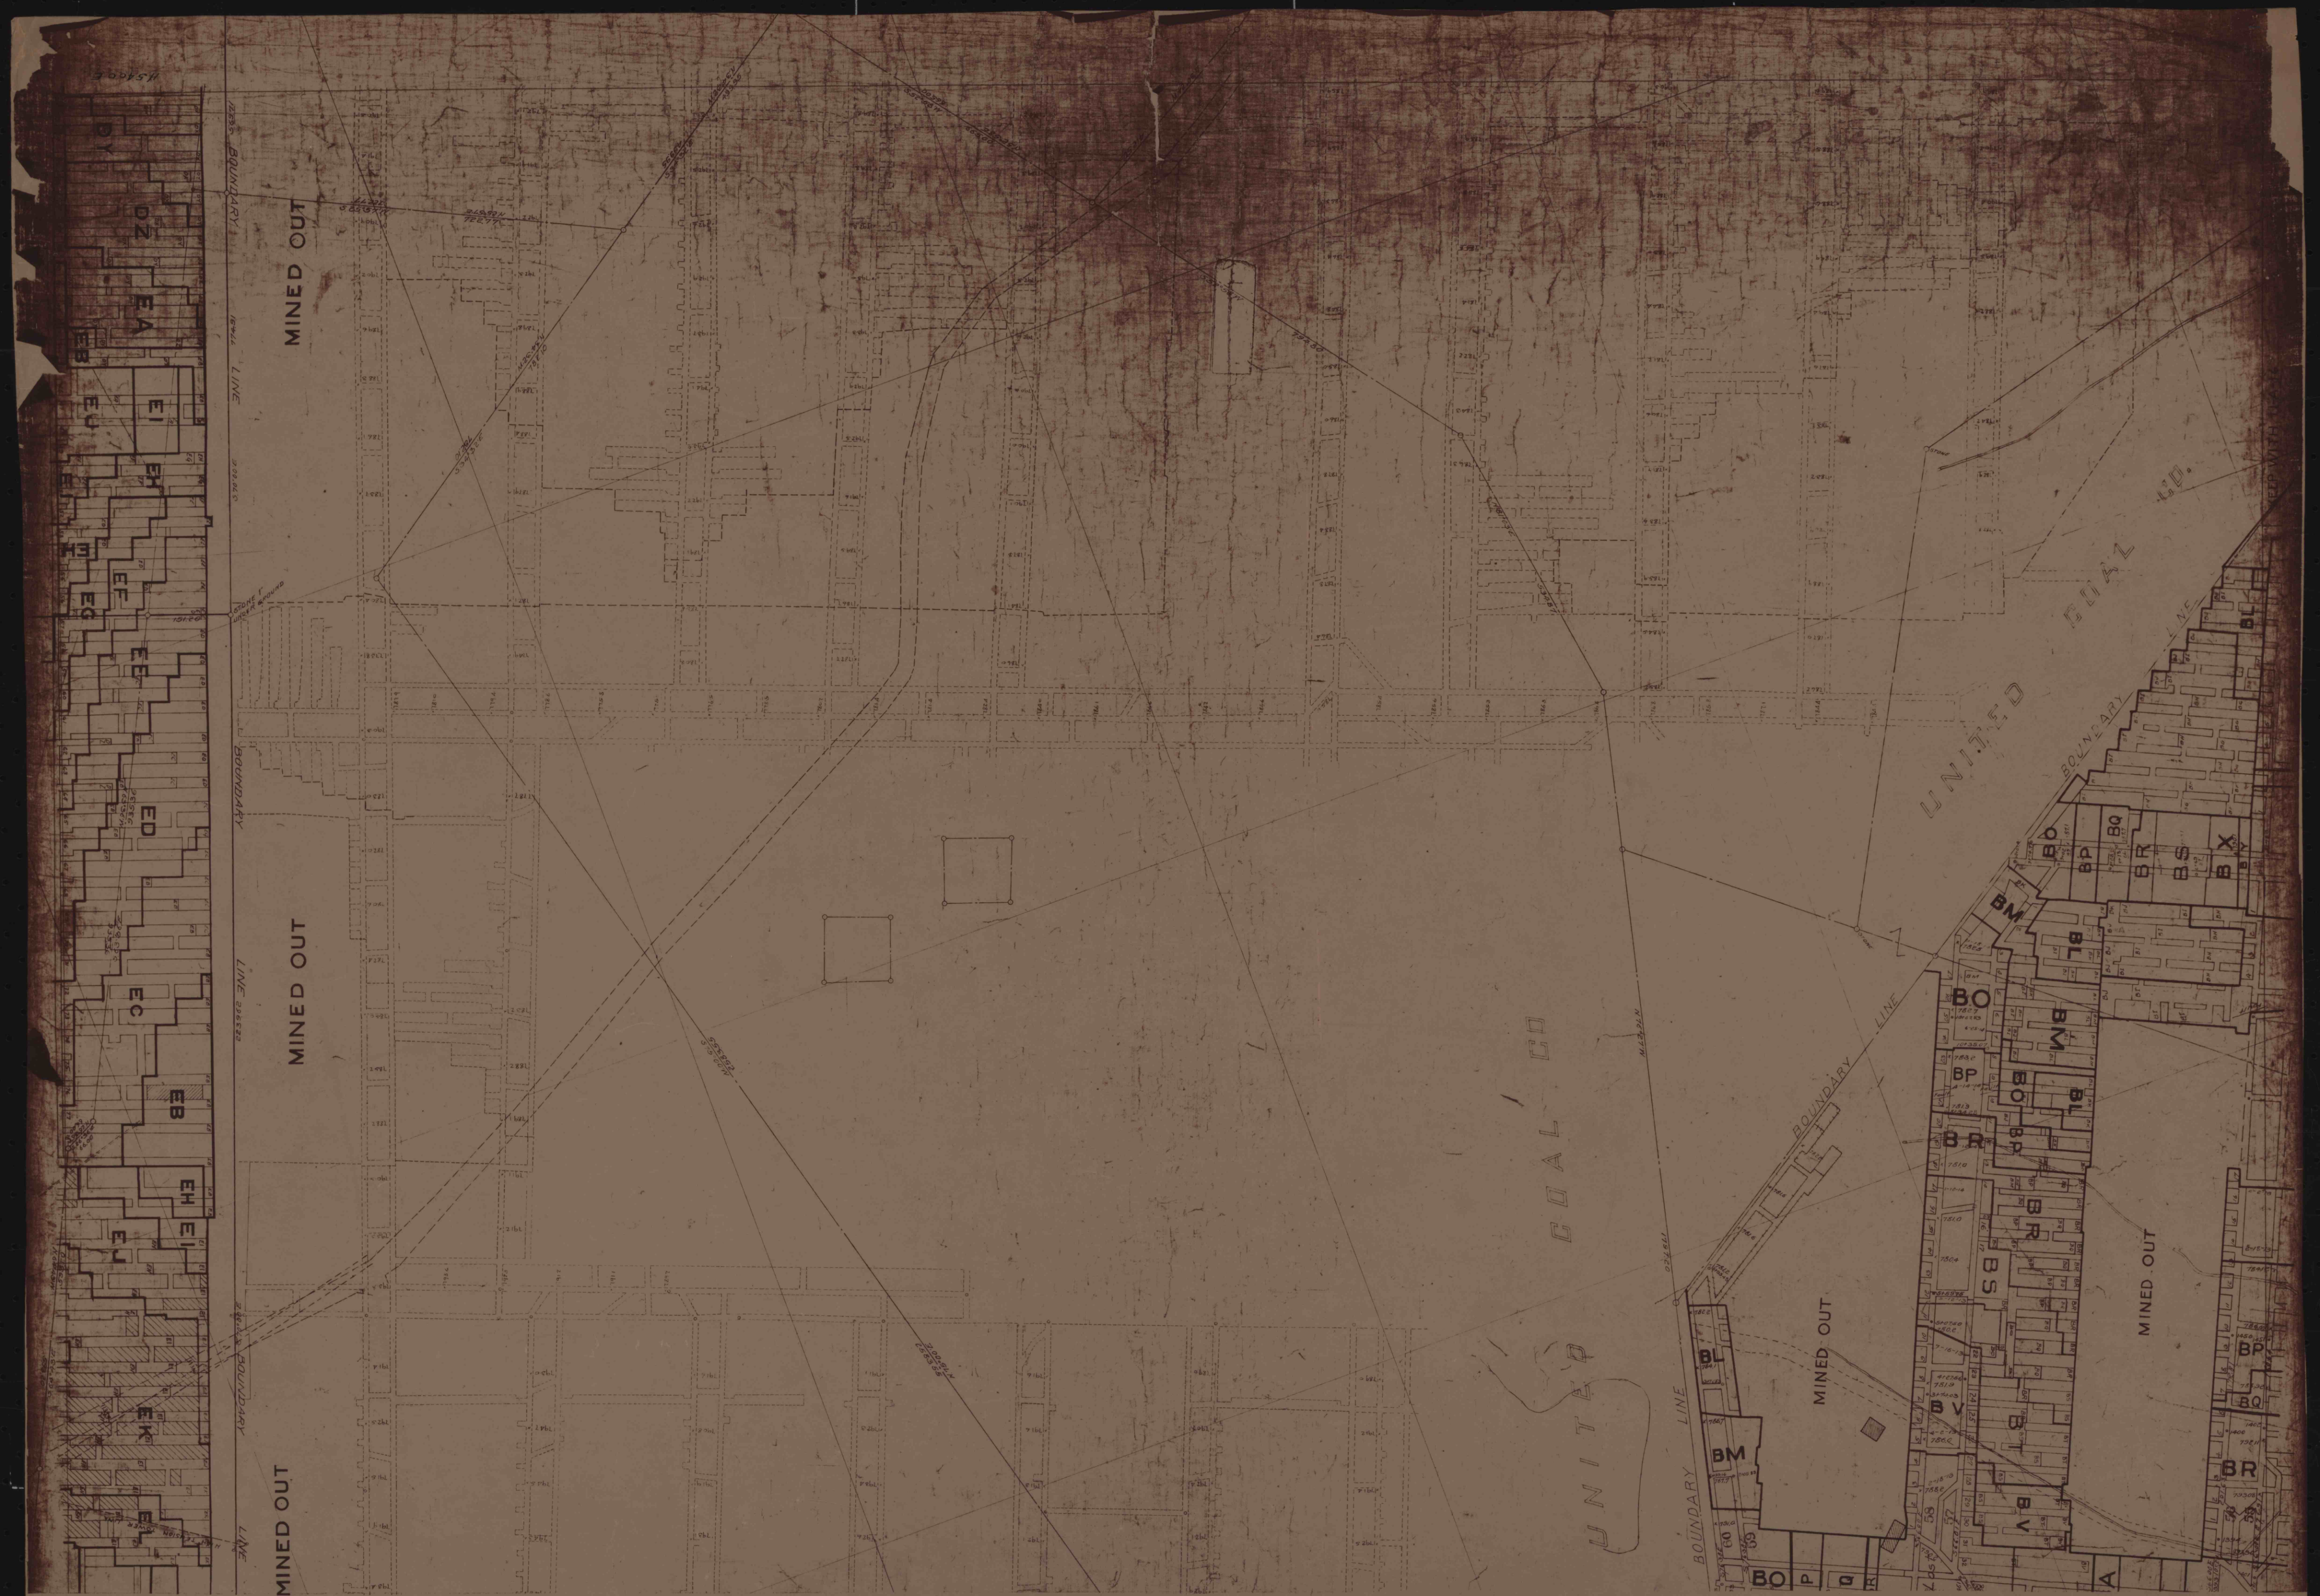

Fit to H 5400 W

H 5400 E