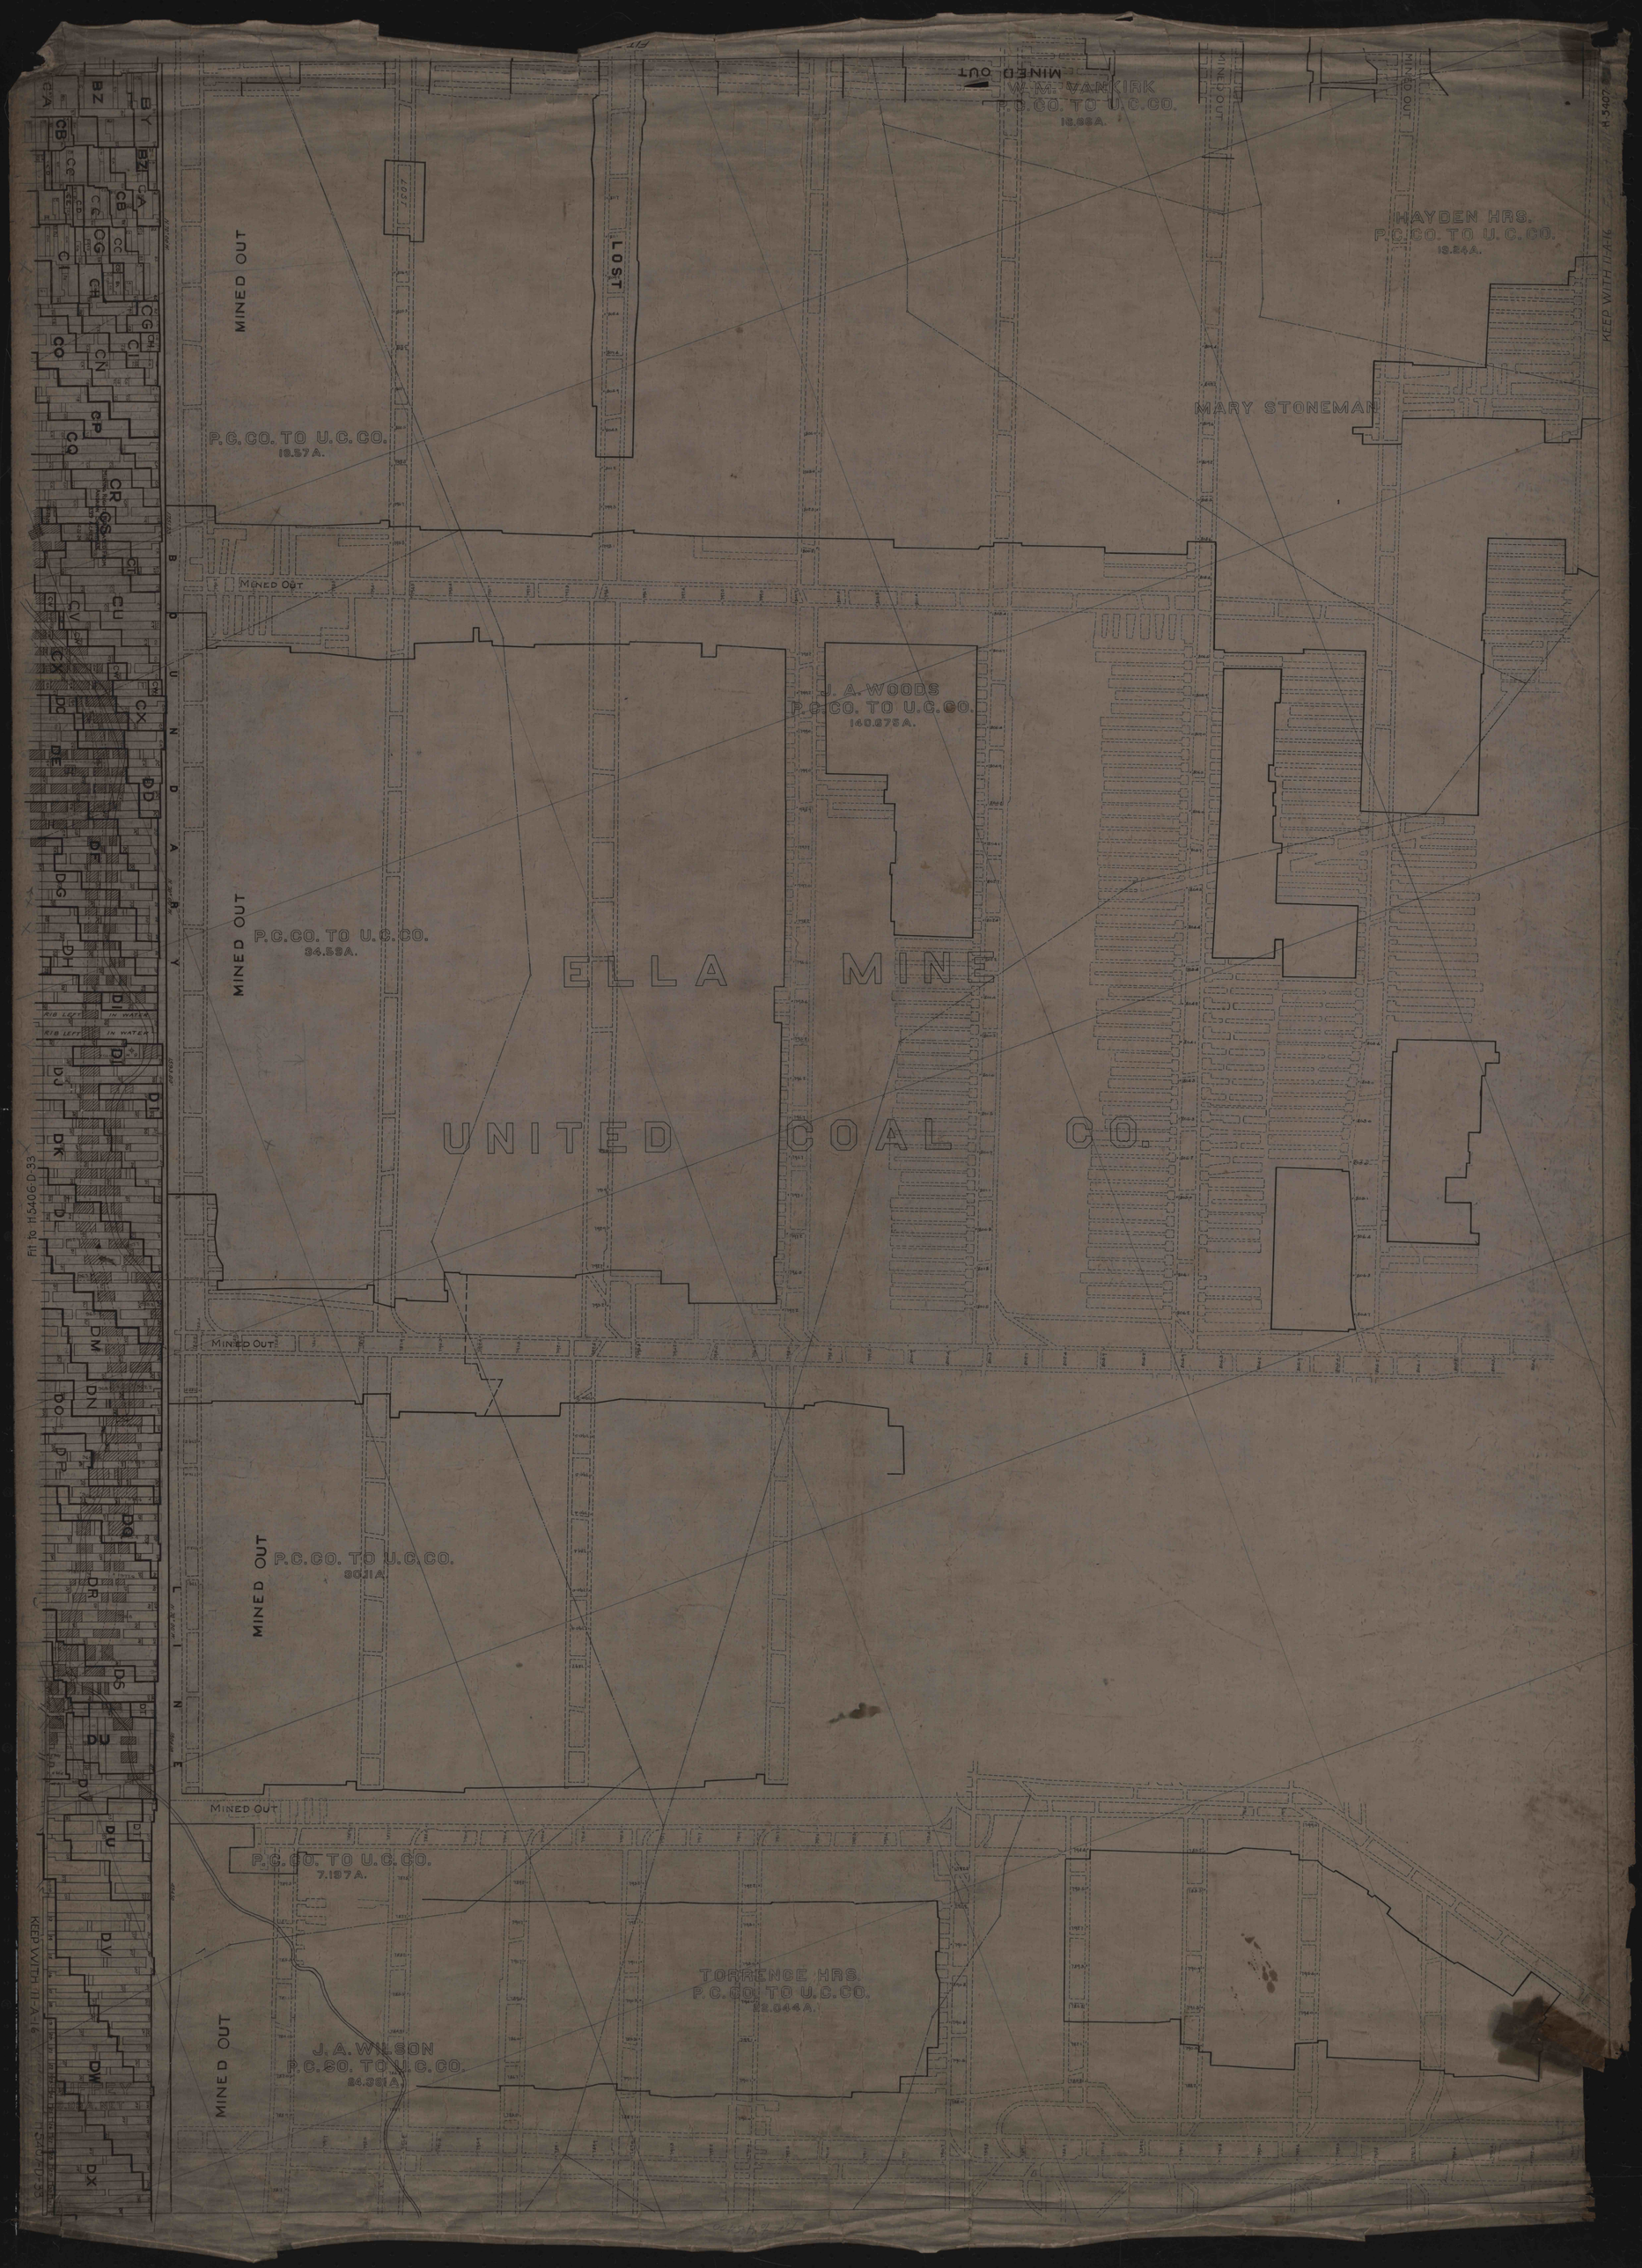
MINED OUT
W. M. VANKIRK
P.C.CO. TO U.C.CO.
18.883A.
LOCKED OUT
HAYDEN HRS.
P.C.CO. TO U.C.CO.
18.24A.
MINED OUT
P.C.CO. TO U.C.CO.
19.57A.
LOST
MARY STONEMAN
MINED OUT
J. A. WOODS
P.C.CO. TO U.C.CO.
140.875A.
MINED OUT
P.C.CO. TO U.C.CO.
34.59A.
ELLA MINE
UNITED COAL CO.
MINED OUT
MINED OUT
P.C.CO. TO U.C.CO.
30.31A.
MINED OUT
P.C.CO. TO U.C.CO.
7.197A.
TORRENCE HRS.
P.C.CO. TO U.C.CO.
22.044A.
J. A. WILSON
P.C.CO. TO U.C.CO.
24.381A.
MINED OUT
KEEP WITH H-3407
KEEP WITH H-3406
Fit to H.5406-D-33