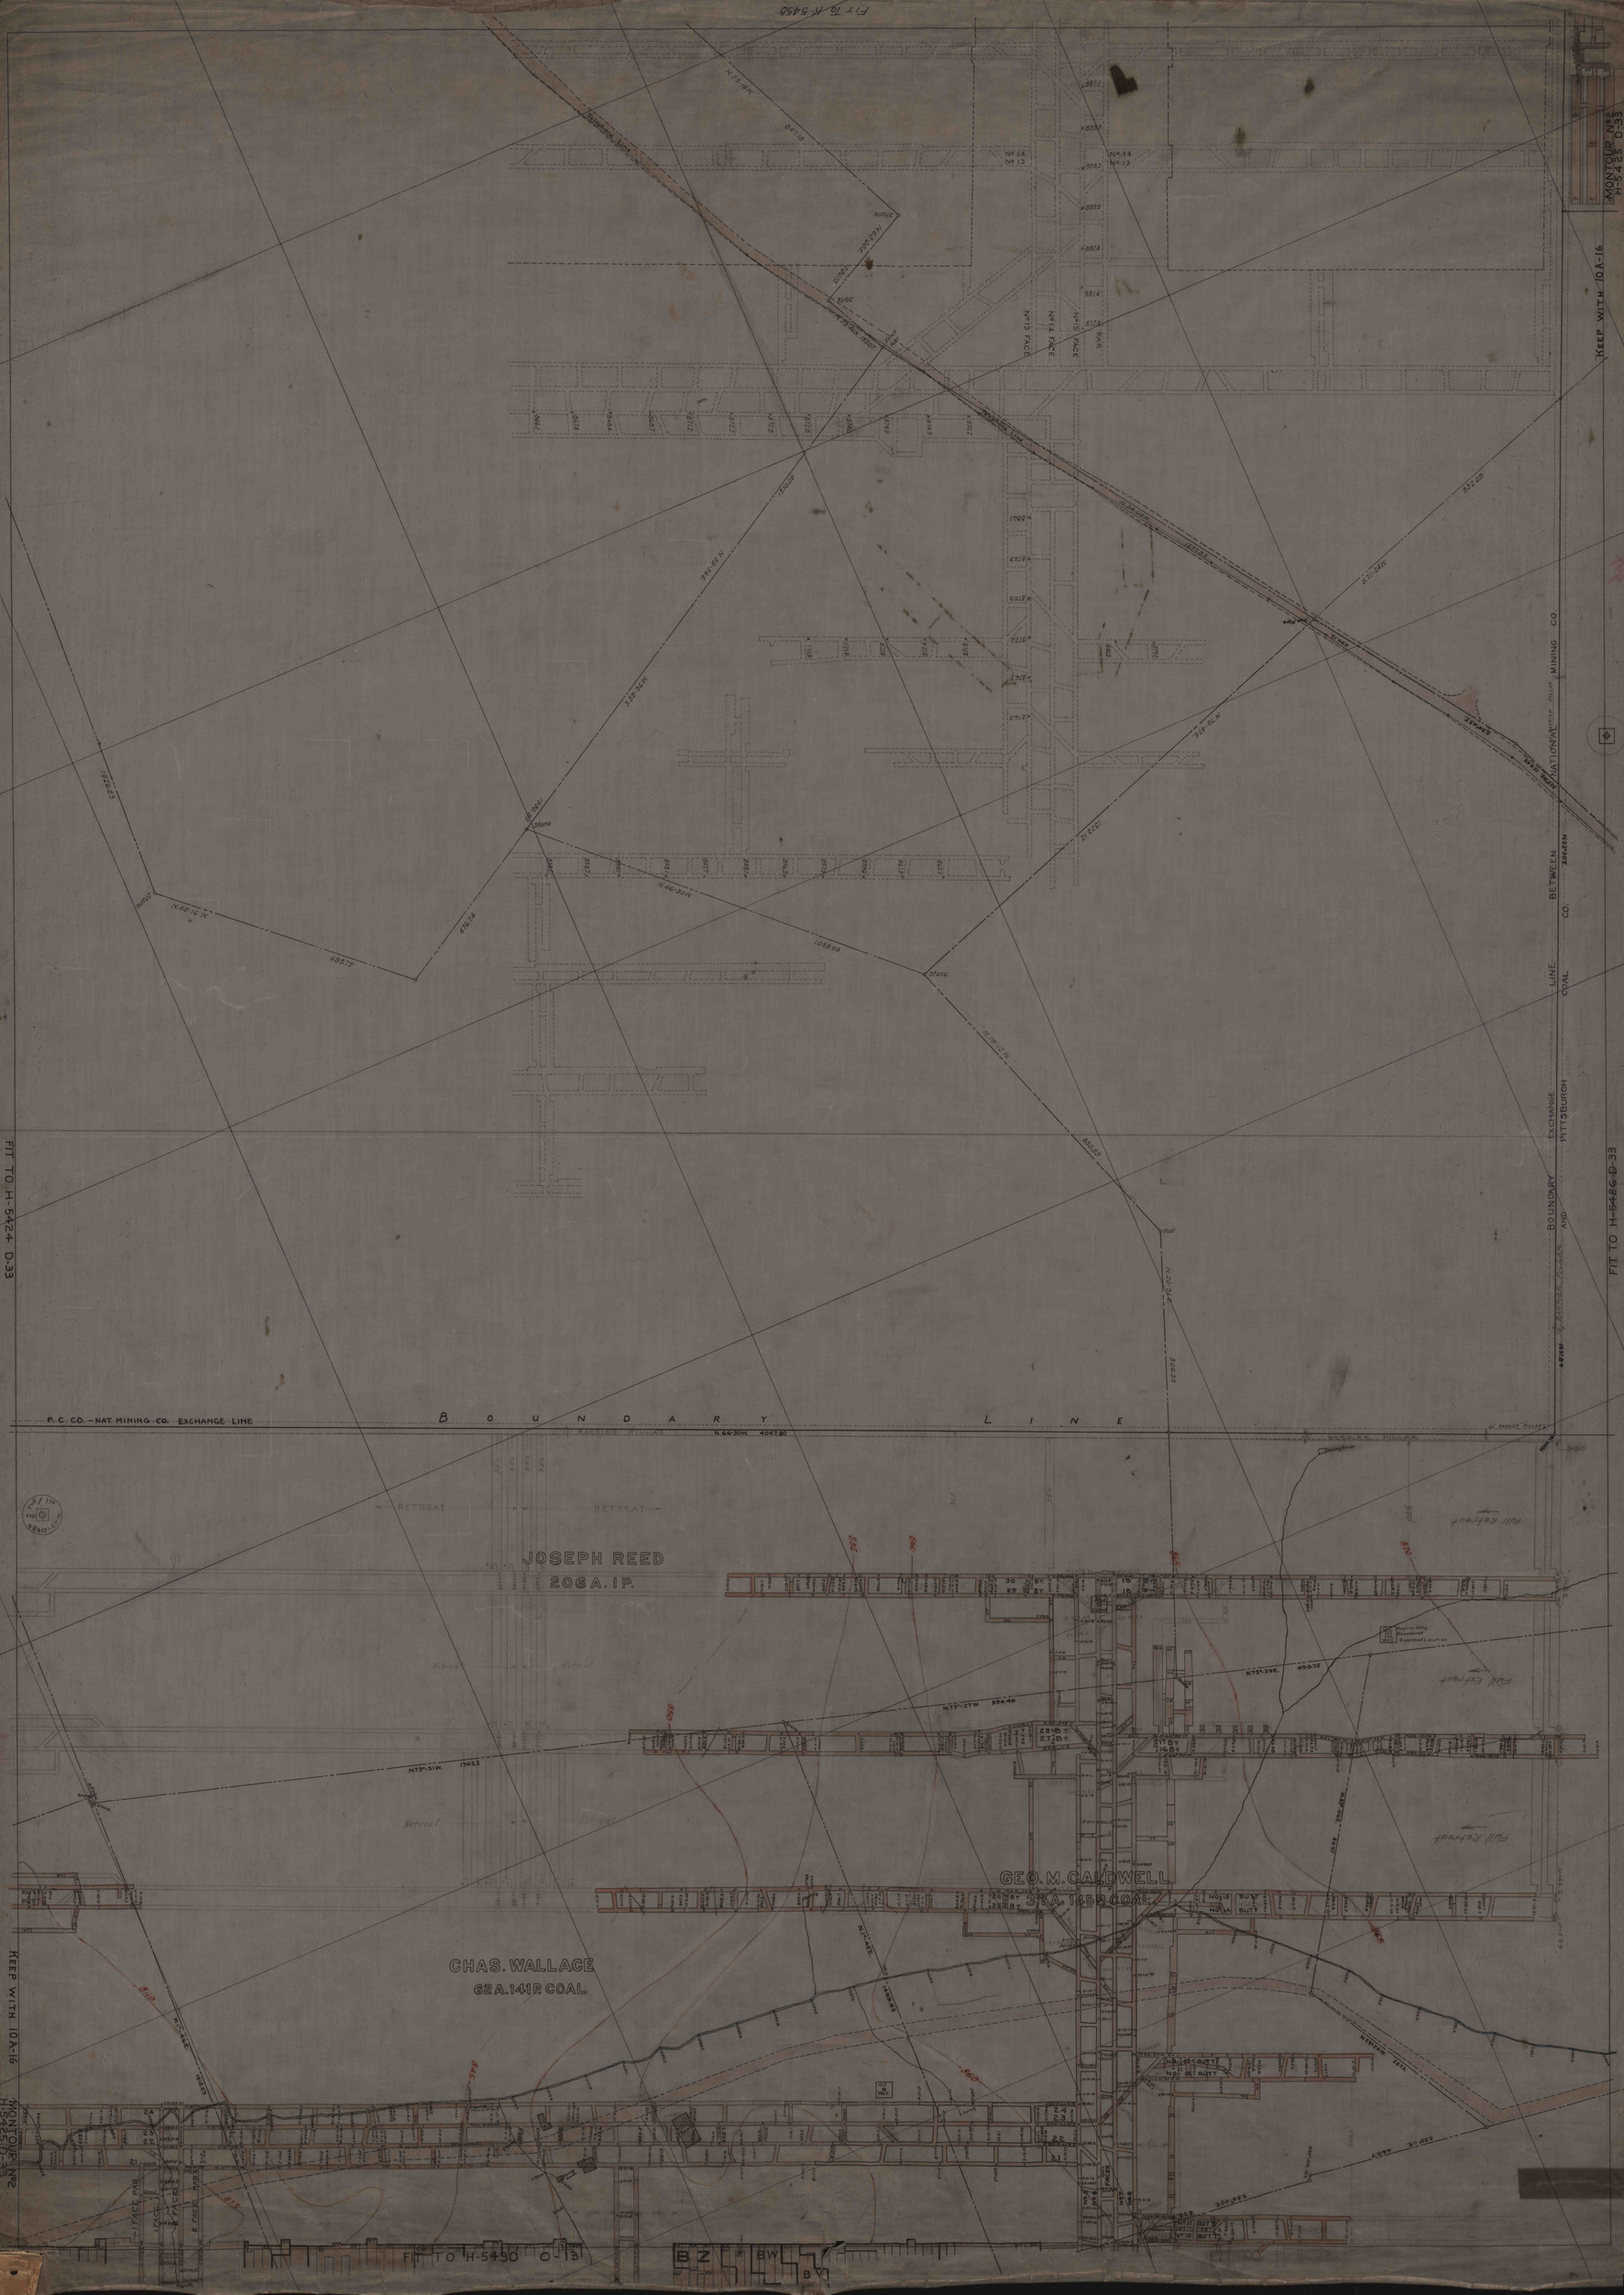
FIT TO H-5458
MONTOUR No2
H-5425 D-33
KEEP WITH 10A-16
BOUNDARY LINE BETWEEN PITTSBURGH COAL CO. AND NATIONAL MINING CO.
EXCHANGE LINE
P. C. CO. — NAT. MINING CO. EXCHANGE LINE
B O U N D A R Y L I N E
FIT TO H-5424 D-33
FIT TO H-5426 D-33
FIT TO H-5450 D-13
JOSEPH REED
206 A. 1P.
GEO. M. CALDWELL
37 A. 145 P. COAL
CHAS. WALLACE
62 A. 141 P. COAL
RETREAT
Nº 13 FACE
Nº 14 FACE
Nº 15 FACE
Nº 16 FACE
Nº 14 BAR
Nº 16
Nº 13
Nº 14
Nº 13
N 66-30 W 4247.80
N 73-27 W 294.46
N 73-51 W 174.55
N 73-39 E 490.75
N 46-30 W
N 46-12 W
N 72-34 E
N 73-12 E
N 73-12 W
