


Fit To A-2-1

H-5437-1

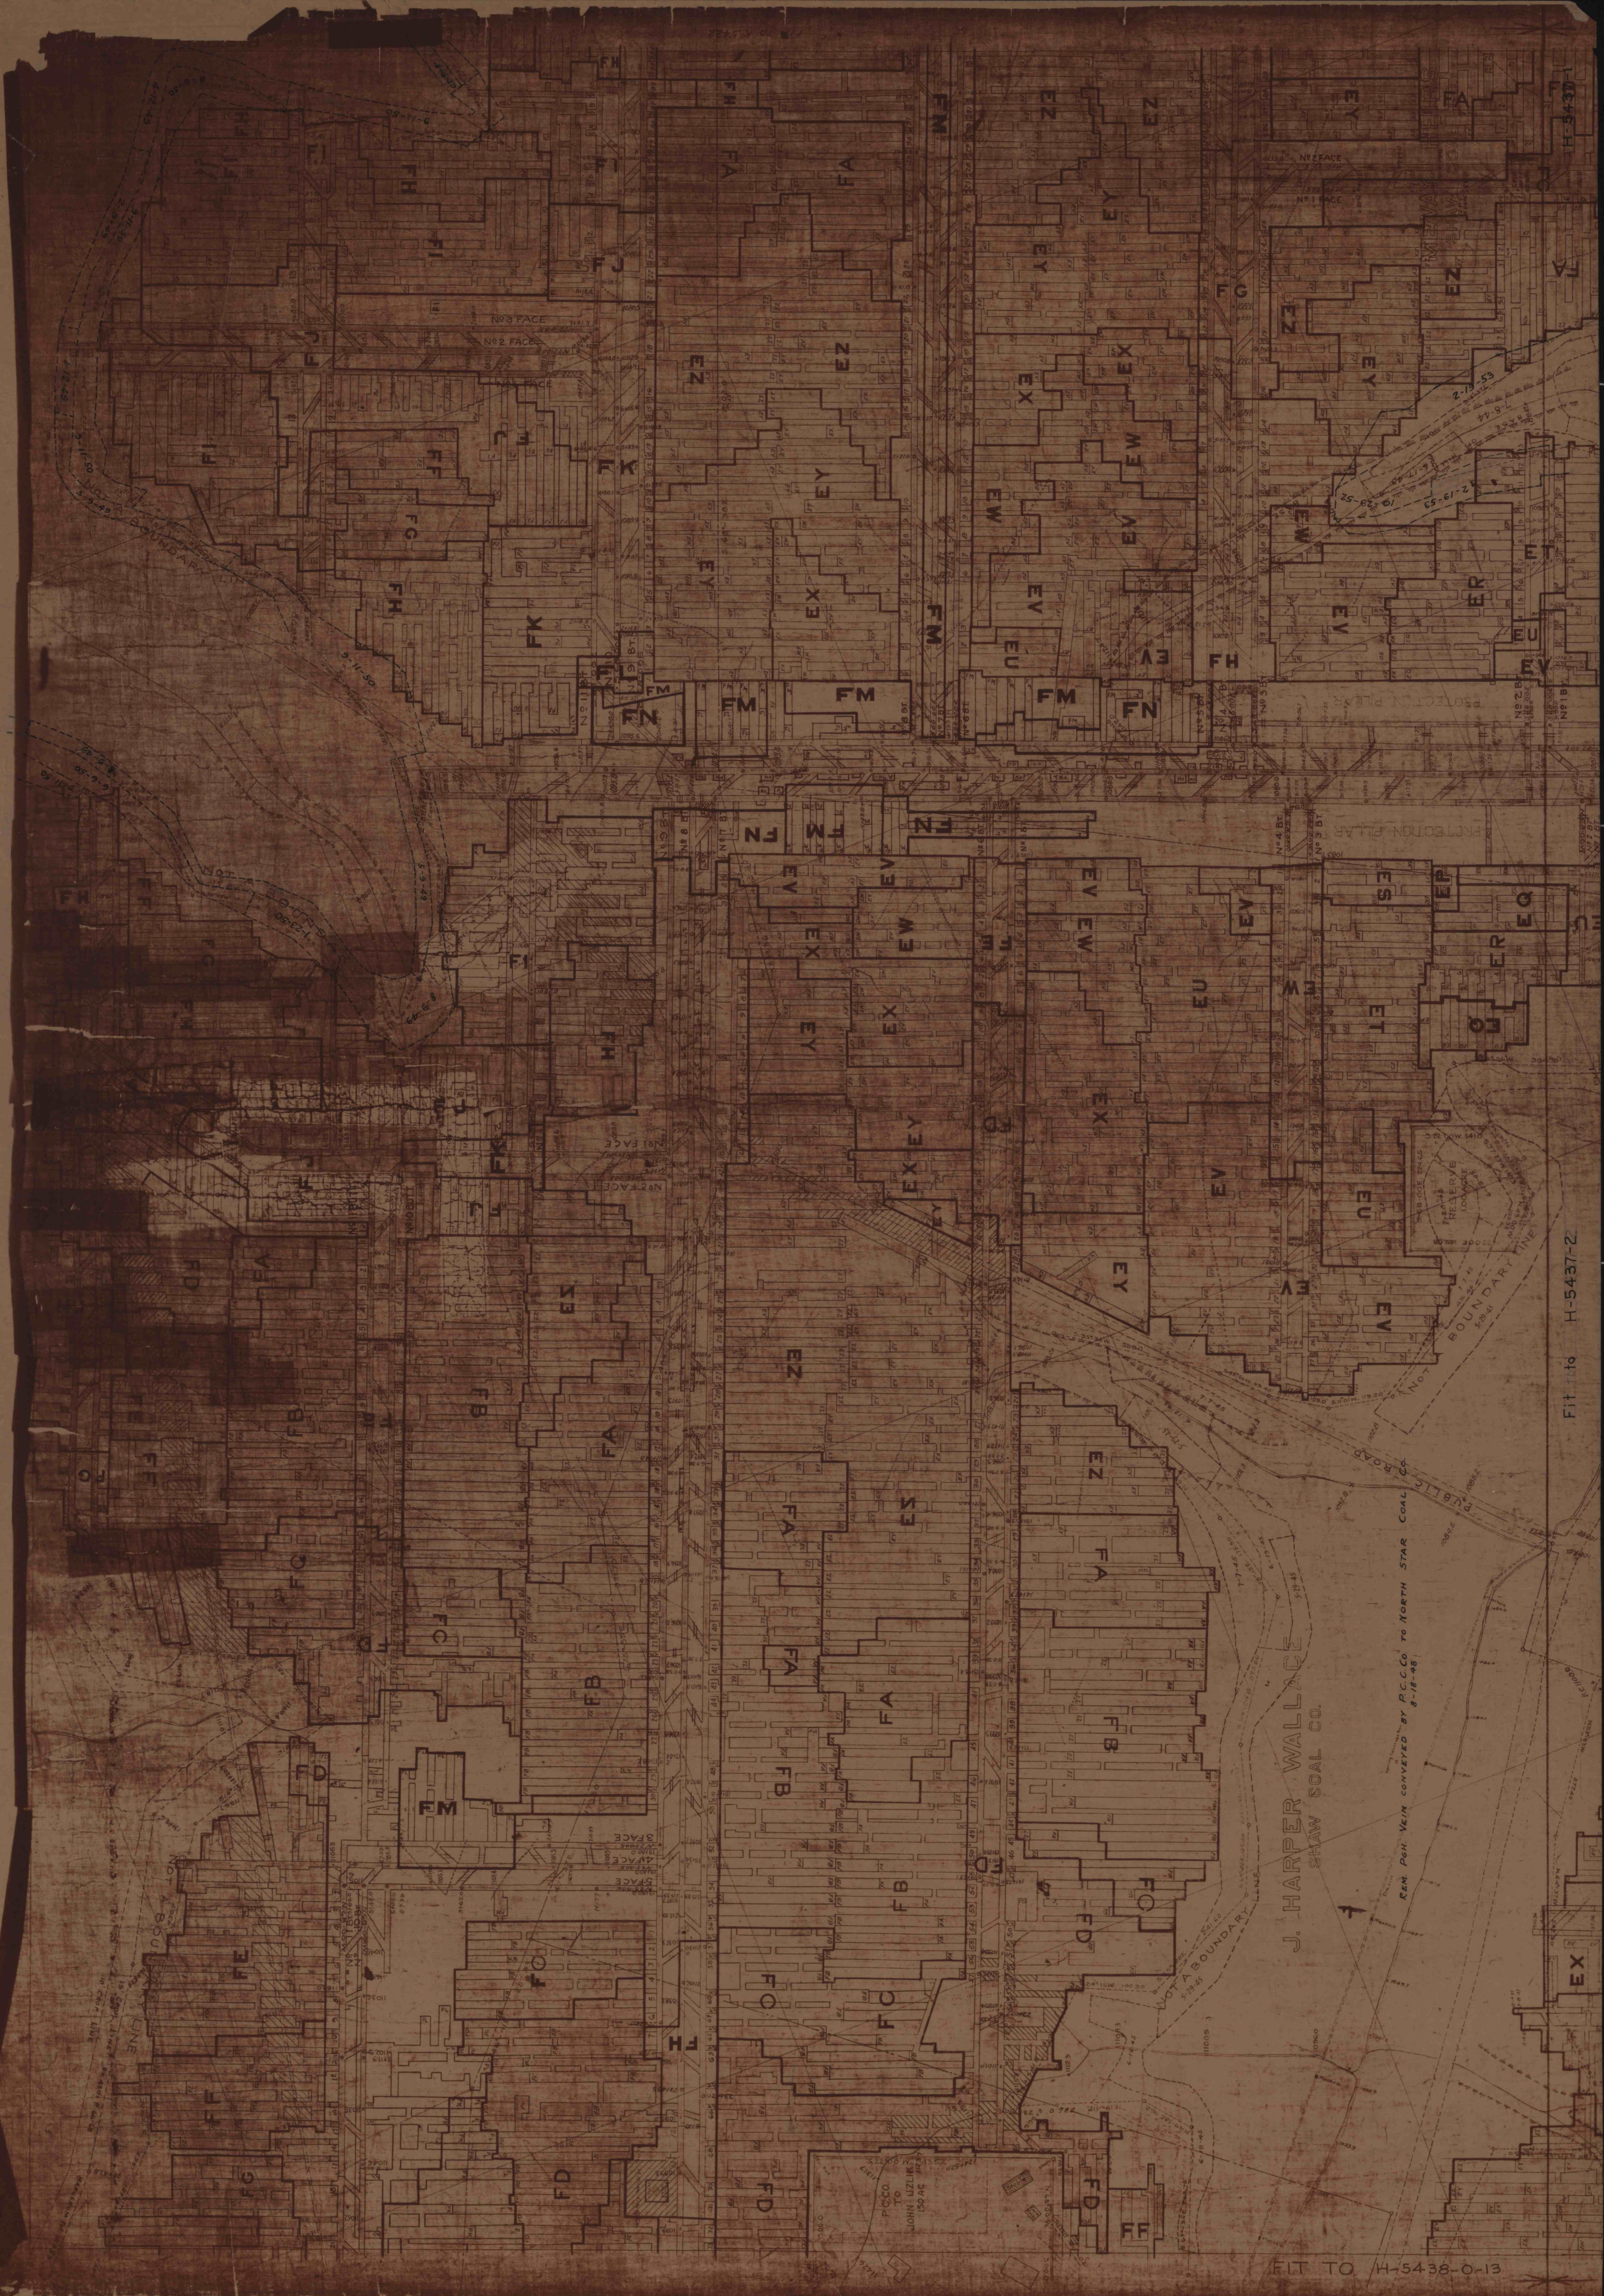

Fit To H-5437-2

J. HARPER WALLACE
SHAW COAL CO.
REM. PEN. VEIN CONVEYED BY P.C.C.O. TO NORTH STAR COAL CO.
8-18-48

FIT TO H-5438-0-13