


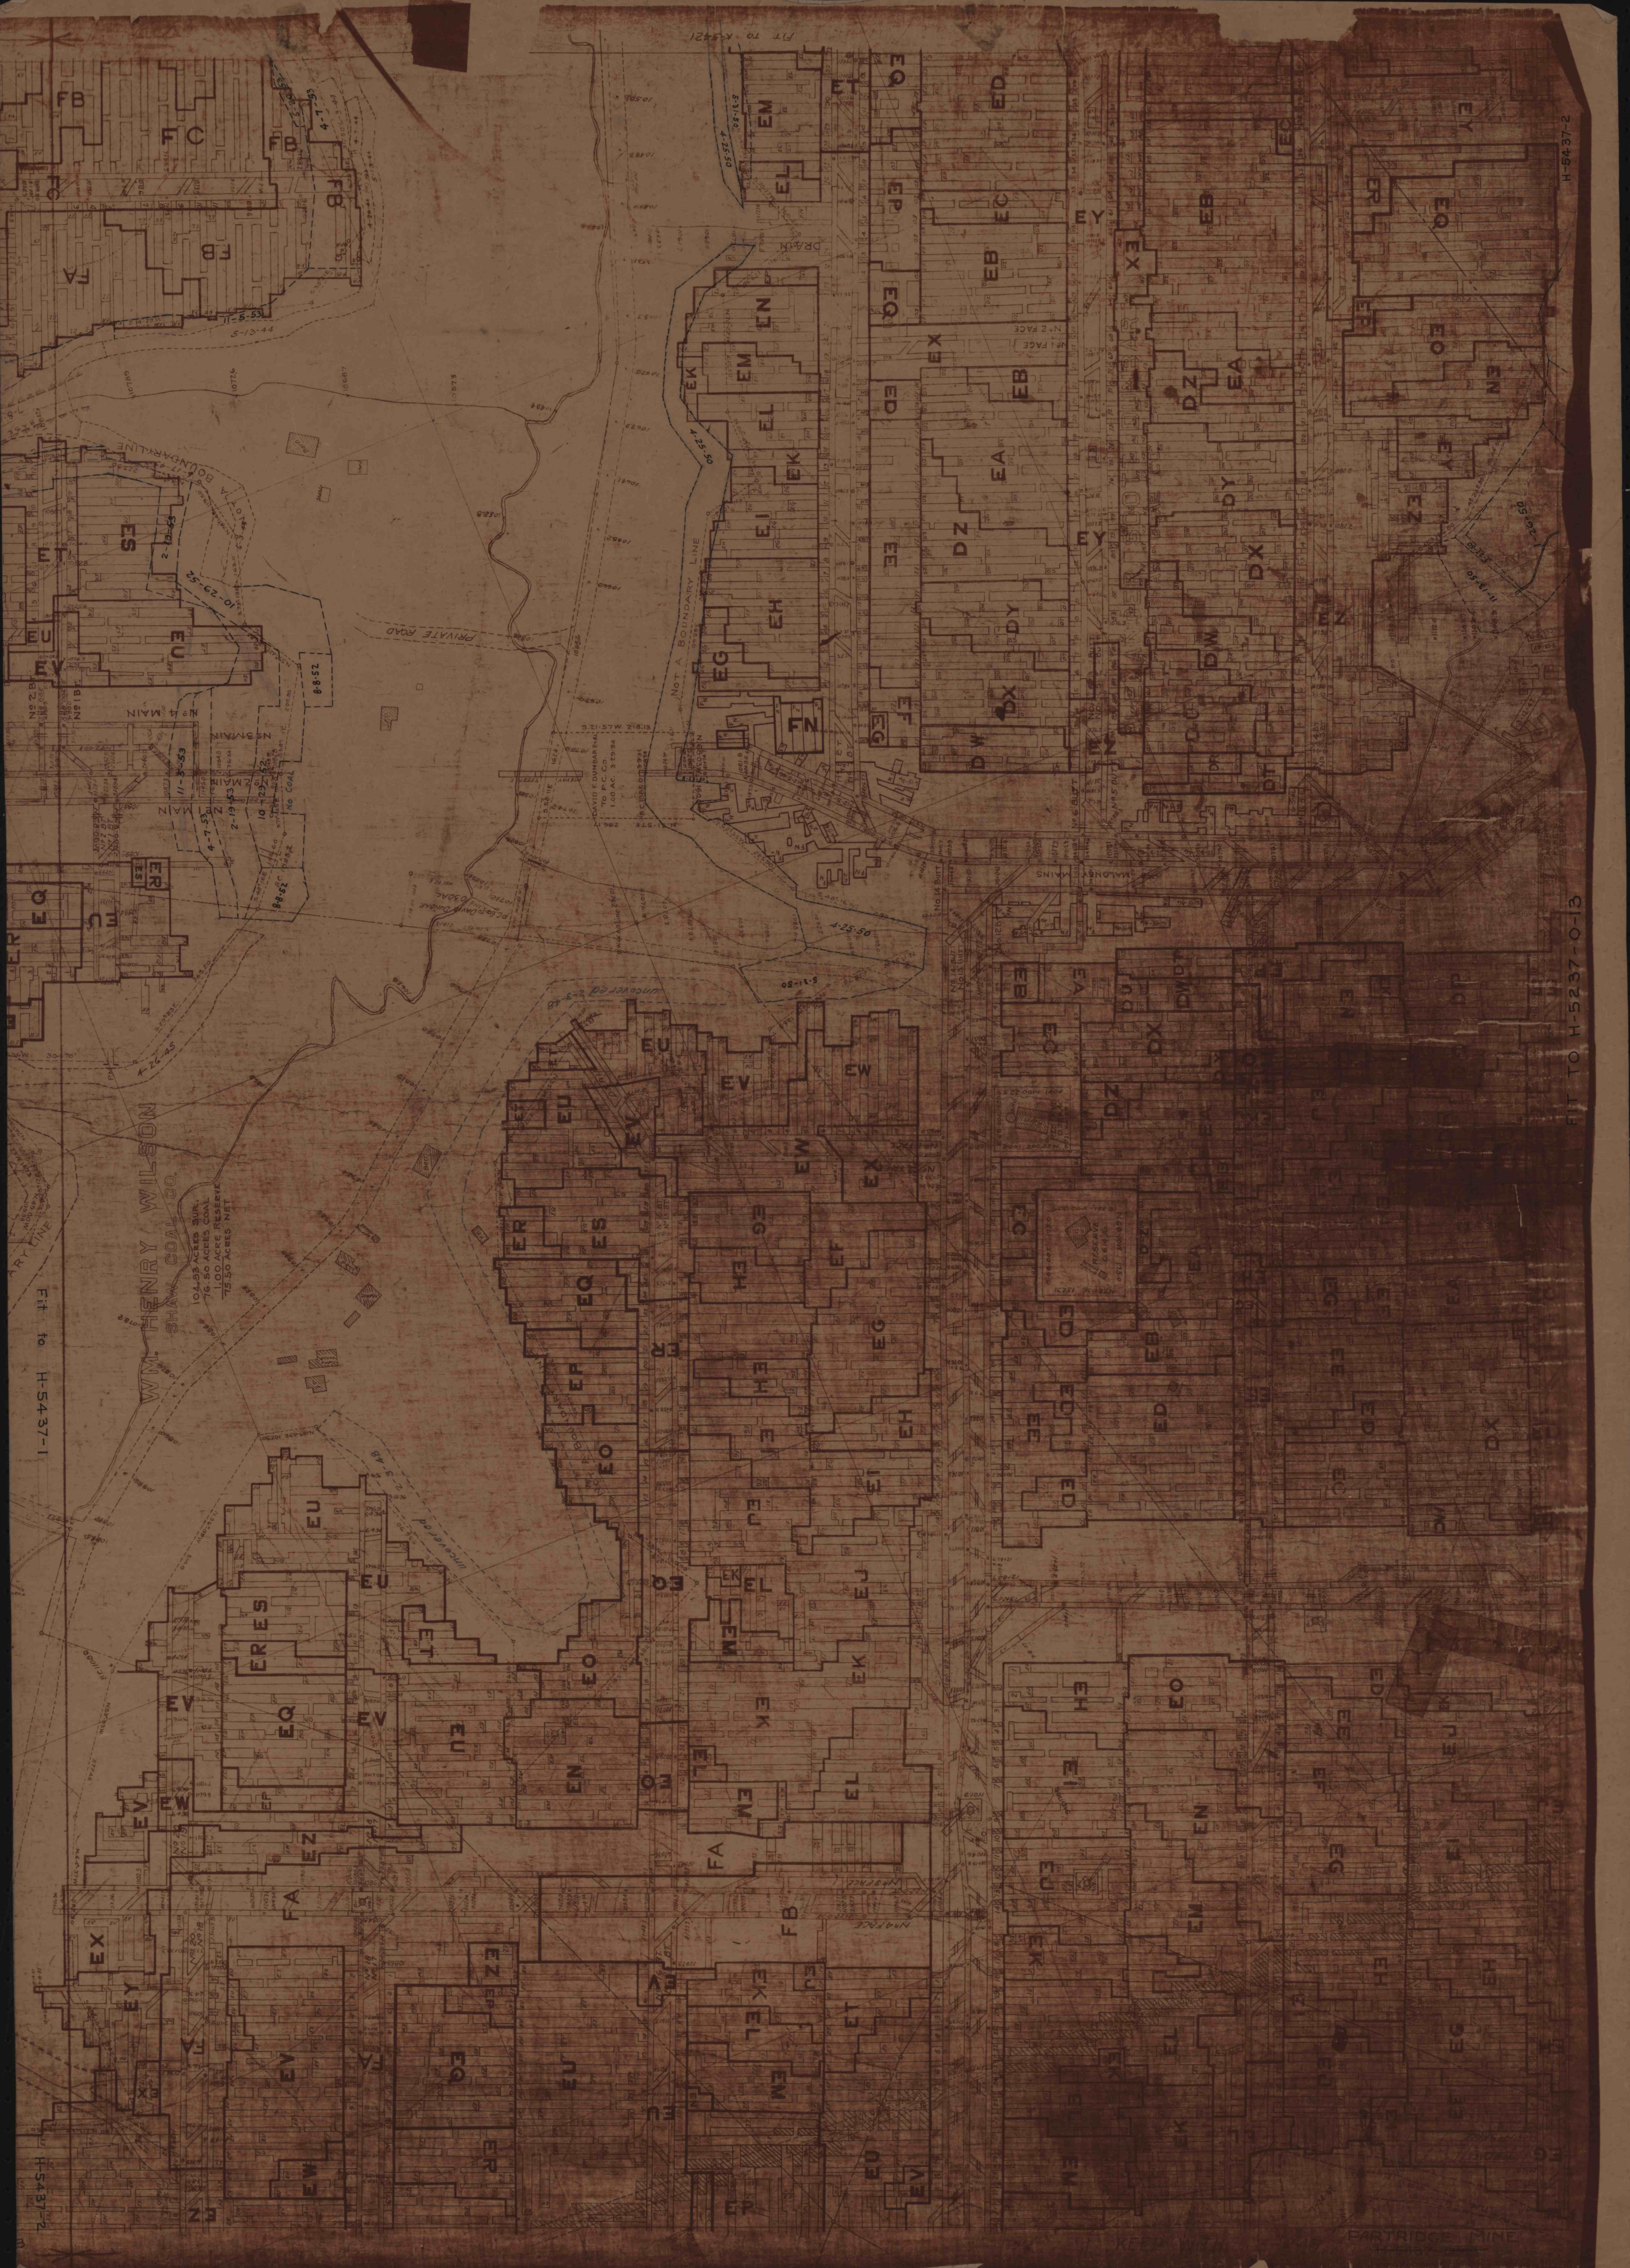

Fit to H-5437-1

FIT TO H-5437-2

H-5437-2