


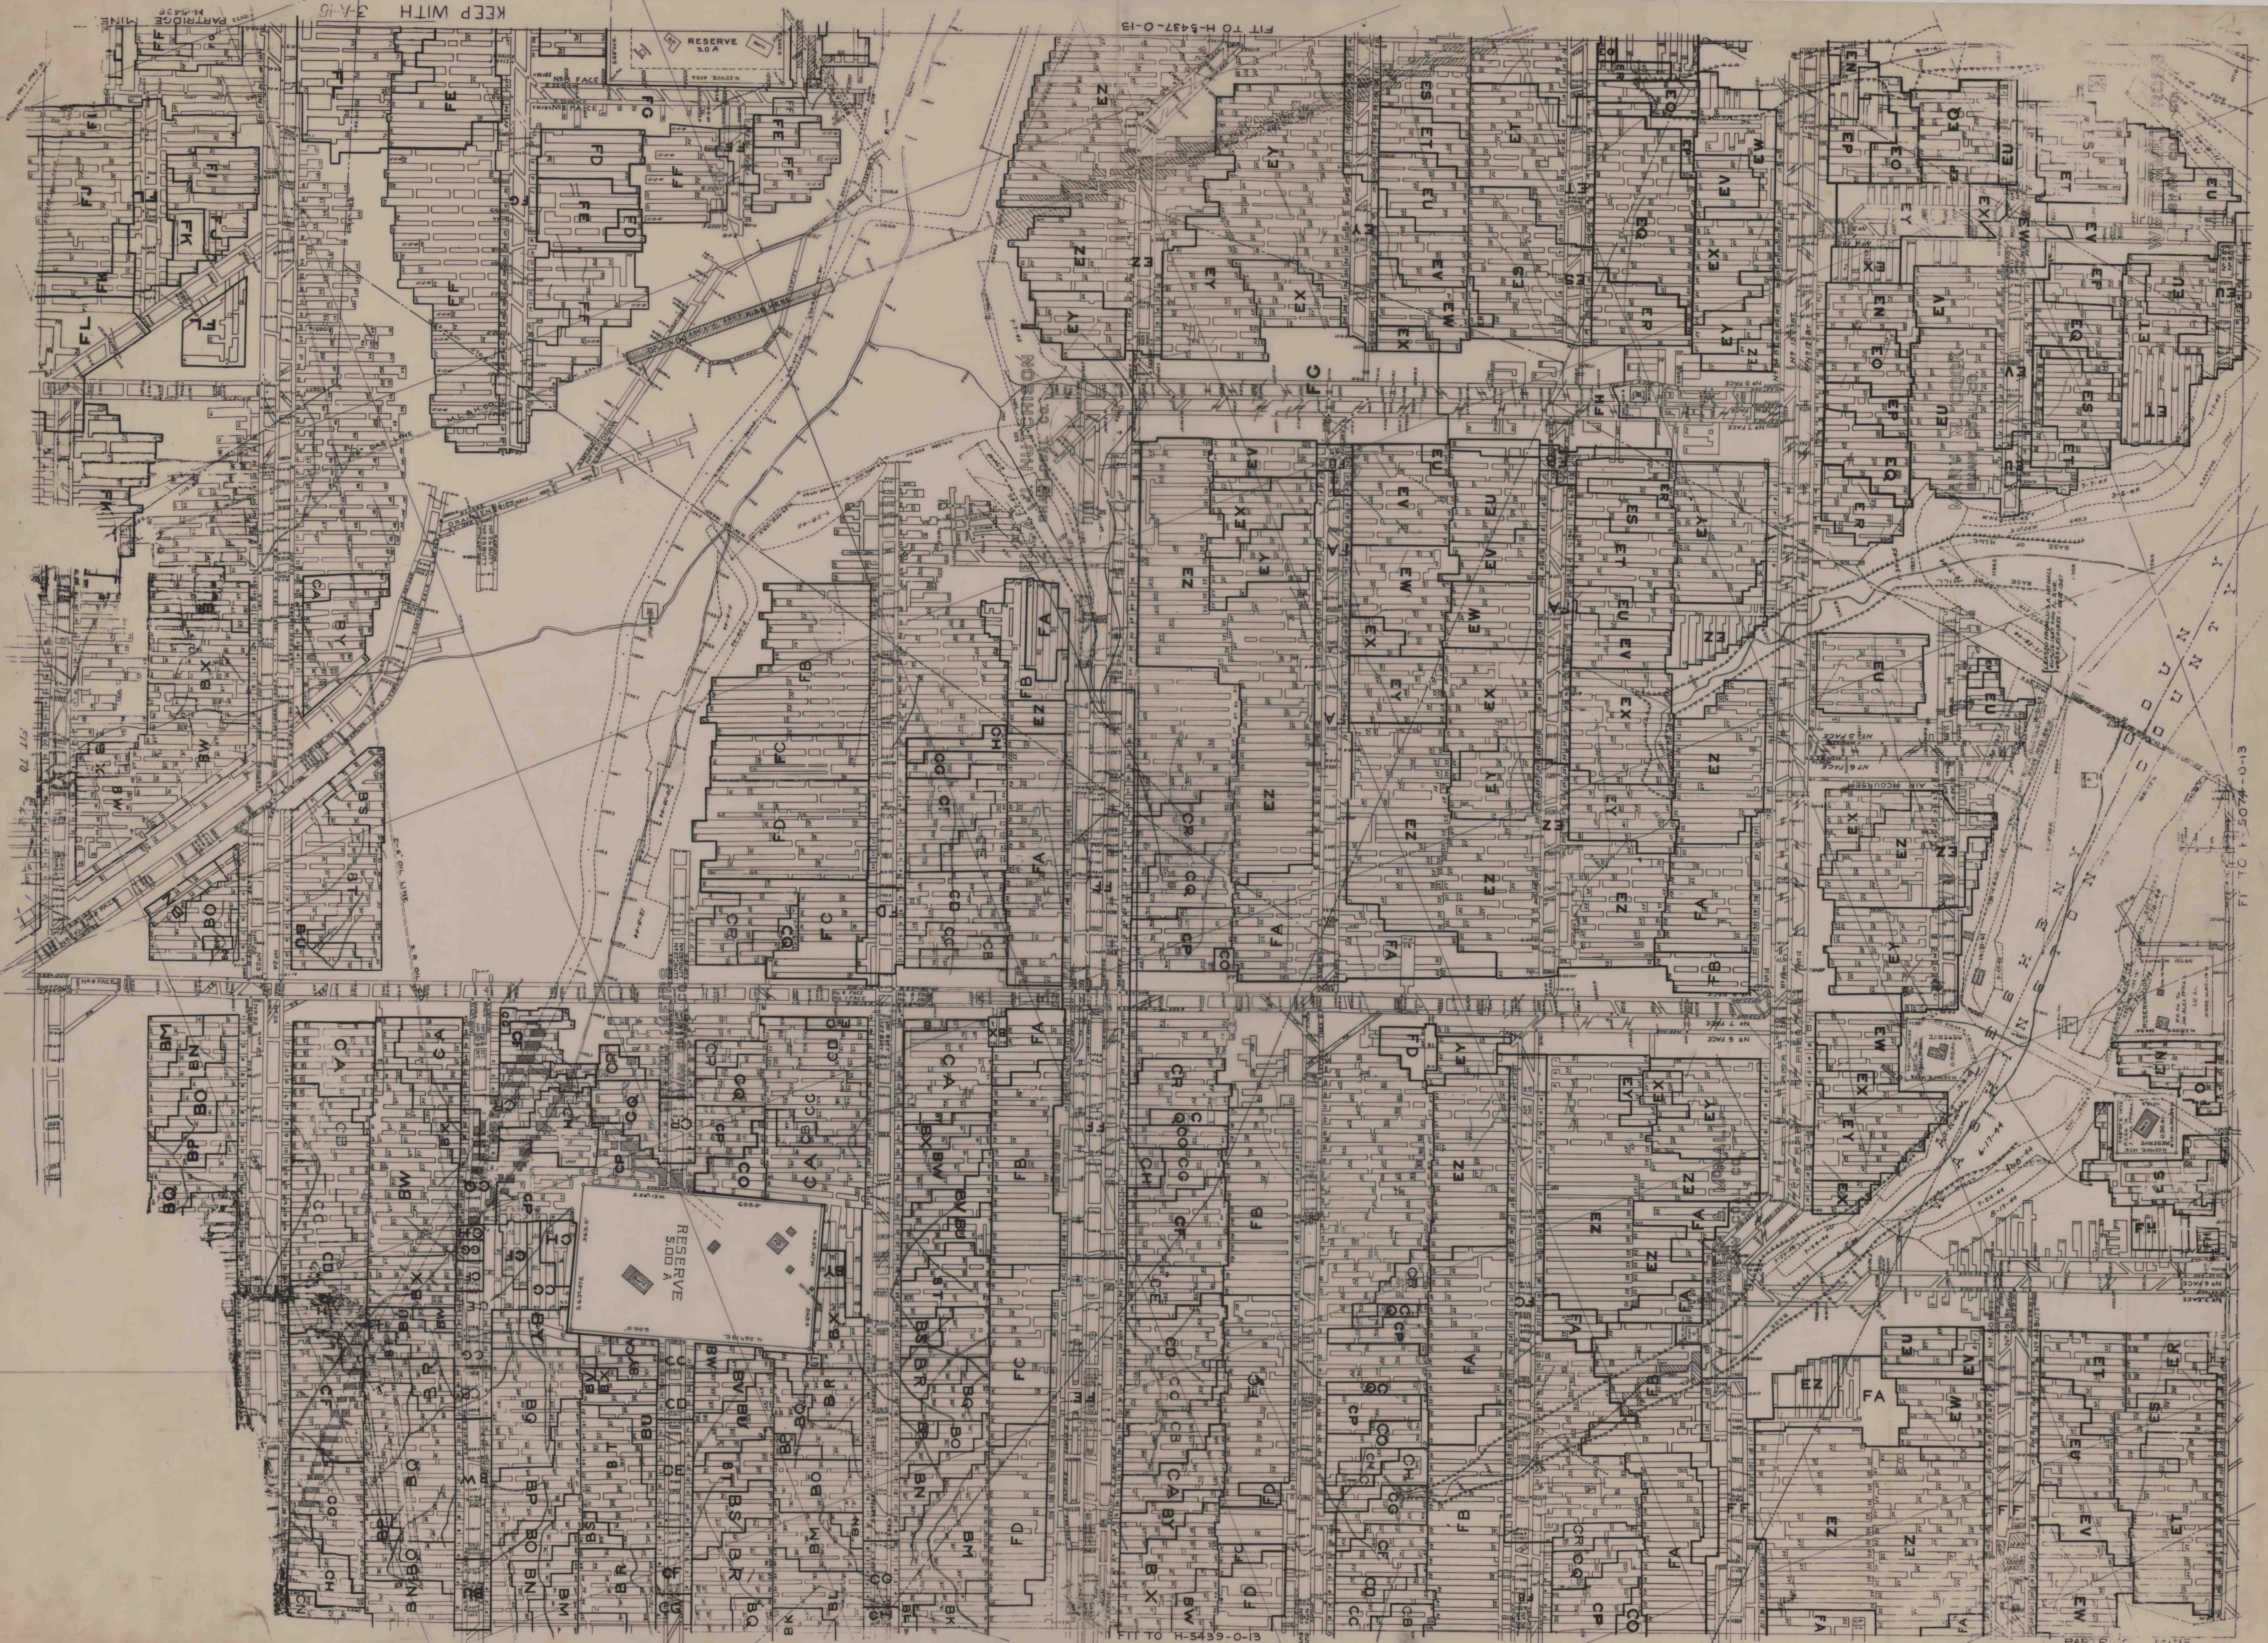

KEEP WITH 3-A-15

FIT TO H-5437-0-13

FIT TO H-5439-0-13

KEEP WITH 3-A-15

FIT TO 1-5074-0-13