


KEEP WITH 11-A-16

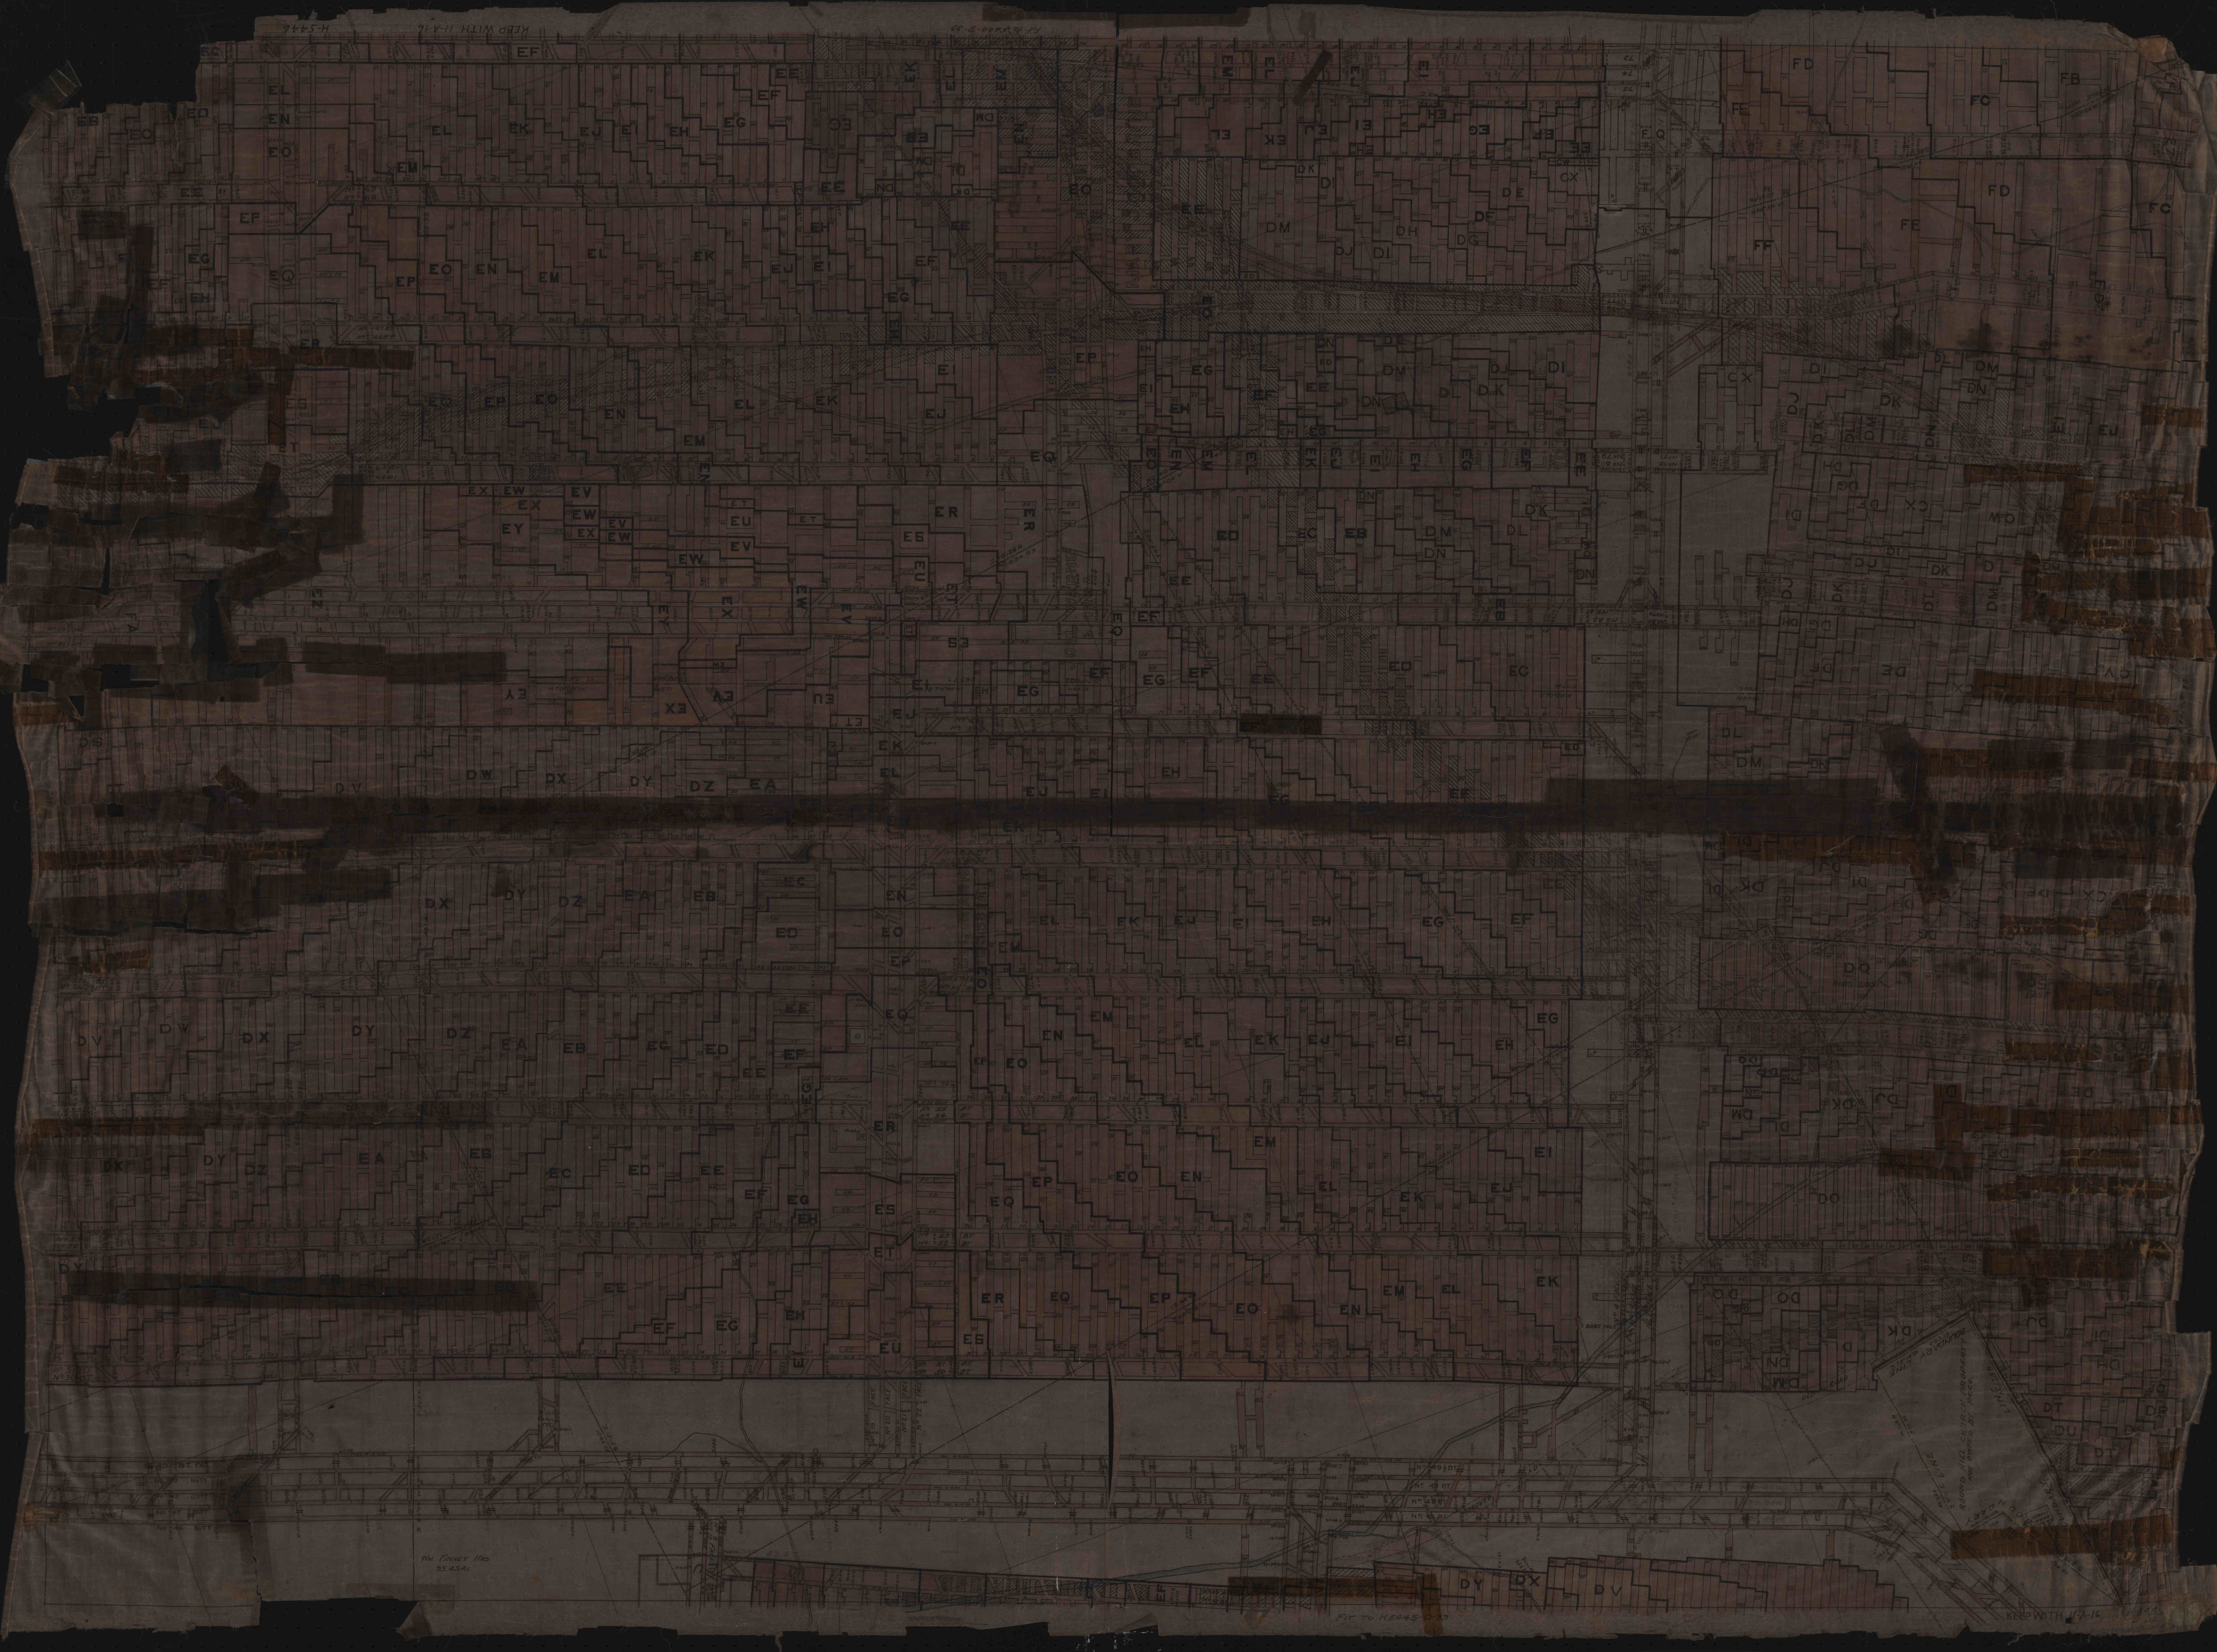

100 CORREY 1165
35-4546

Fit to H645 003

KEEP WITH 11-A-16