


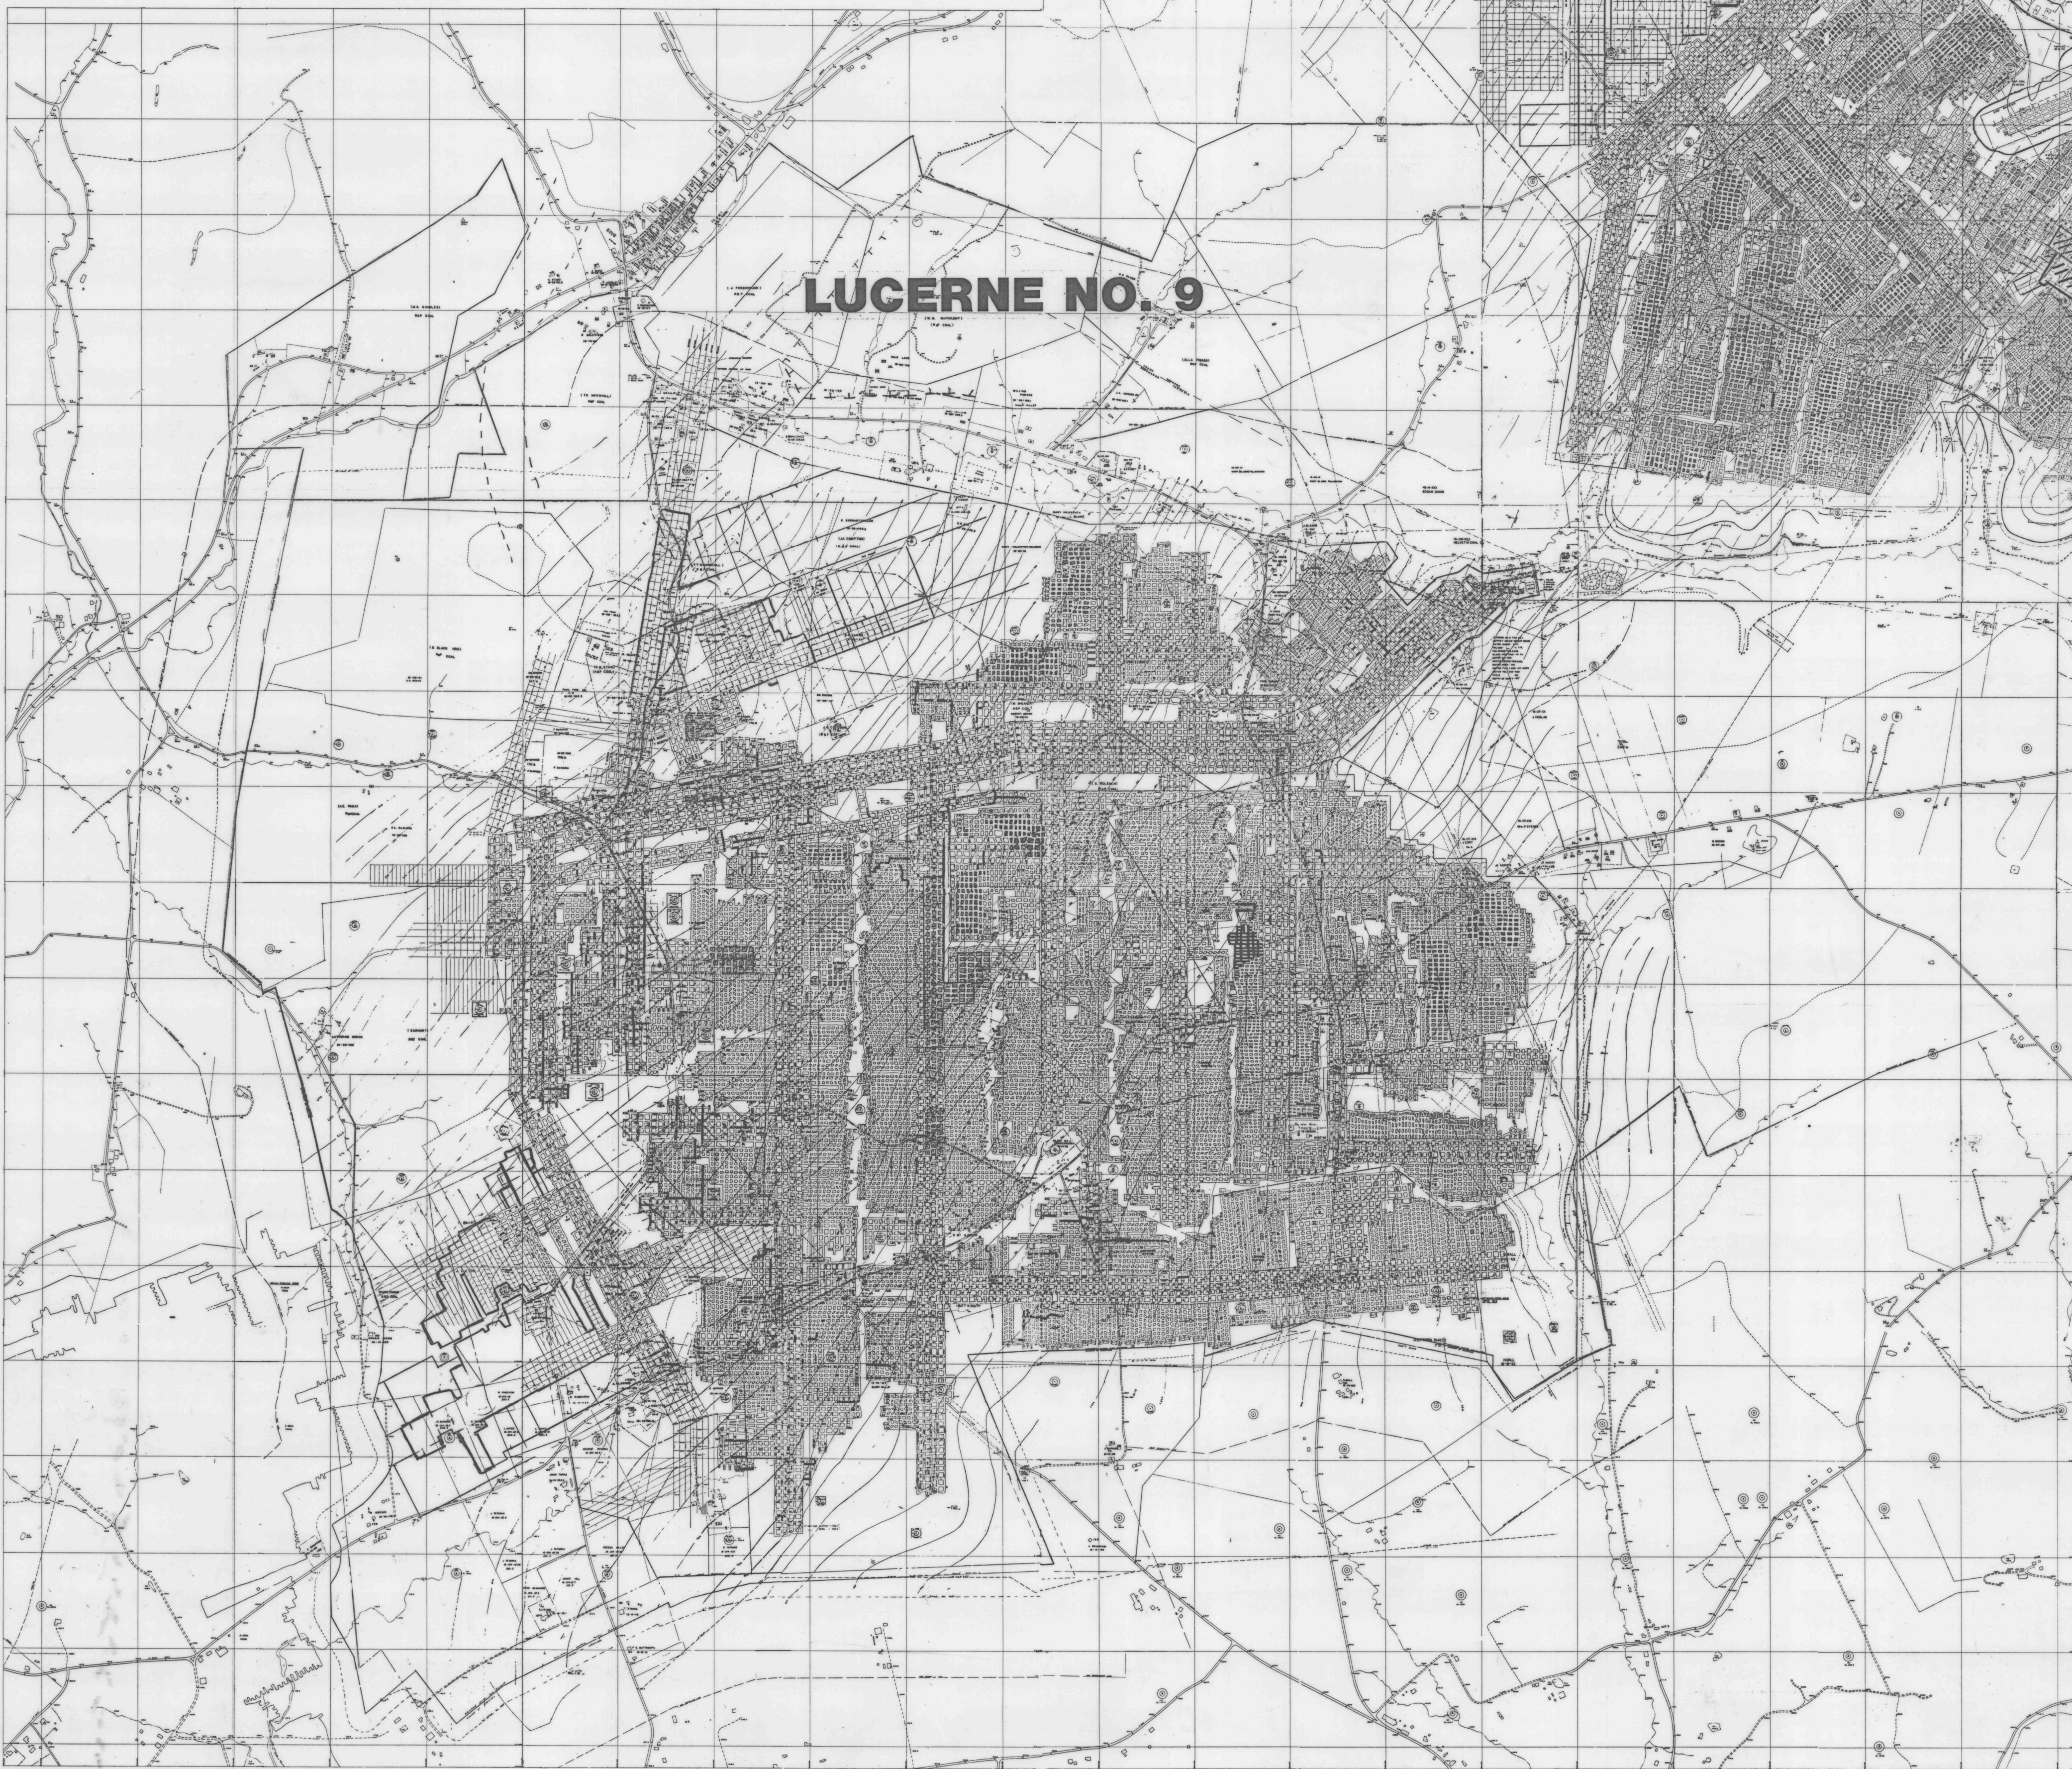

LUCERNE NO. 8 MINE - HELVETIA COAL CO.
YOUNG TWP. - INDIANA CO. PA.
12-1-30