


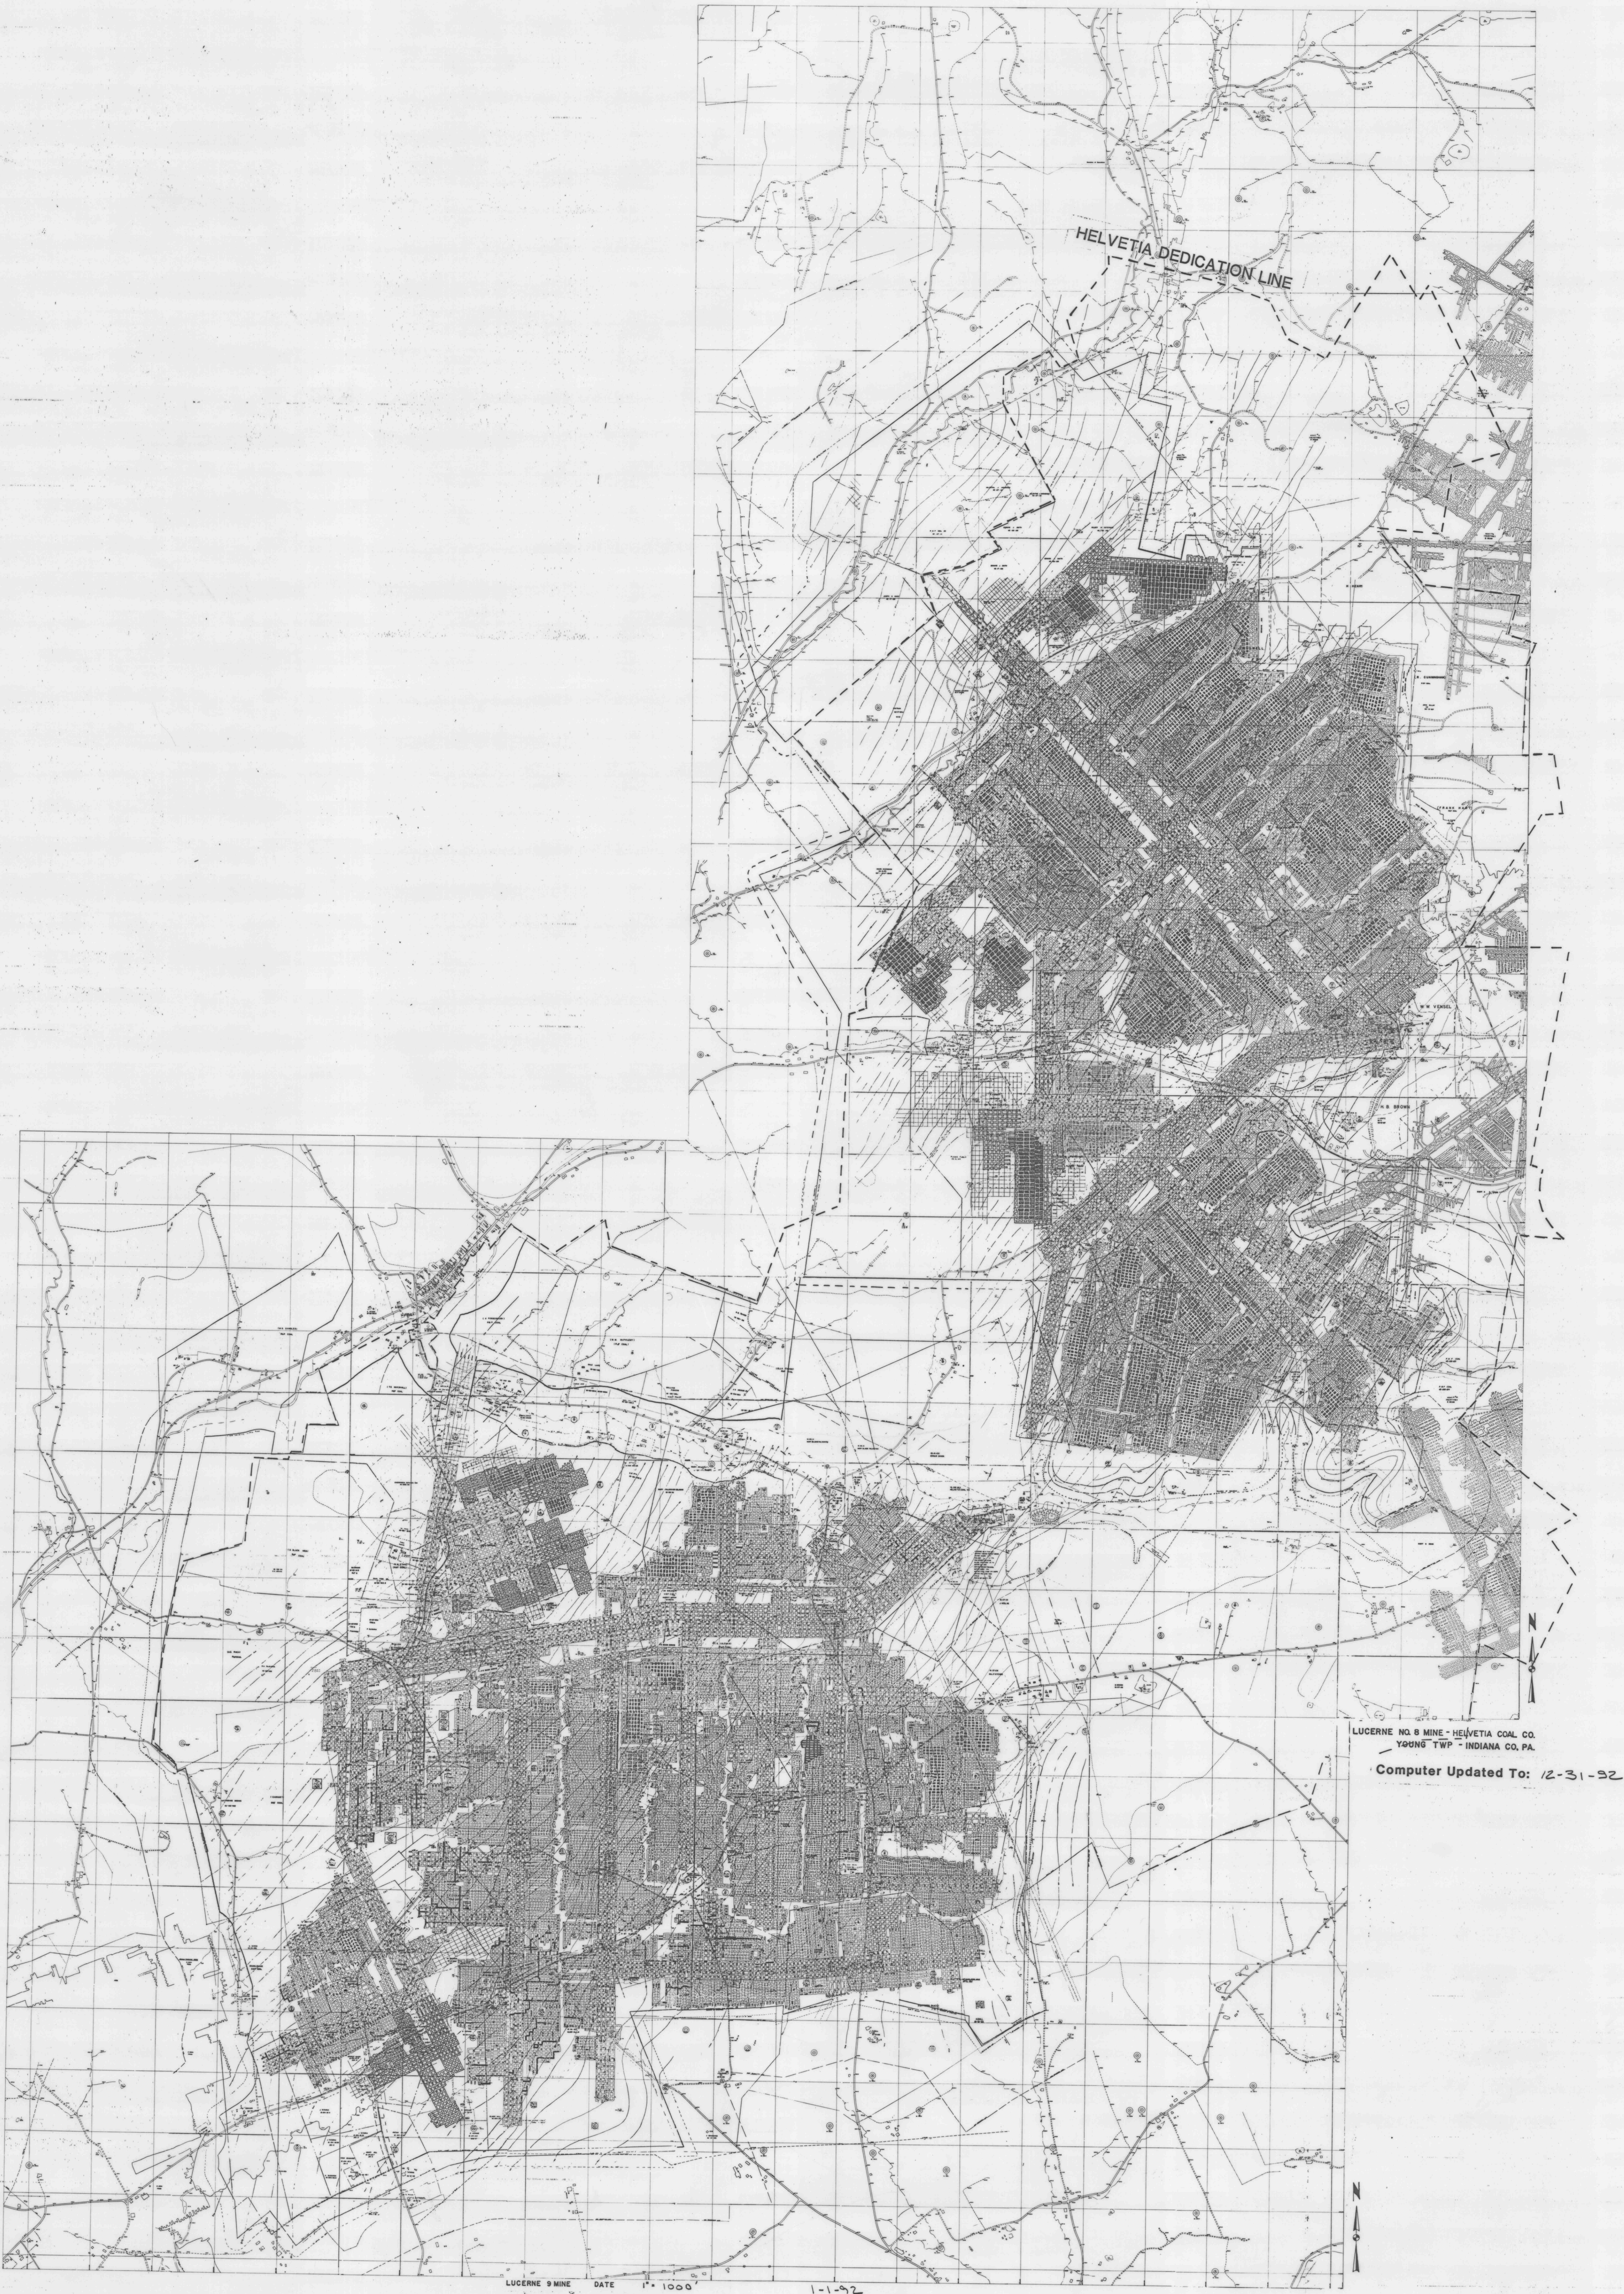

LUCERNE 8 MINE DATE 1-1-92
Computer Updated To: 12-31-92