


K-12

LUCERNE 8 - E SEAM

K-12

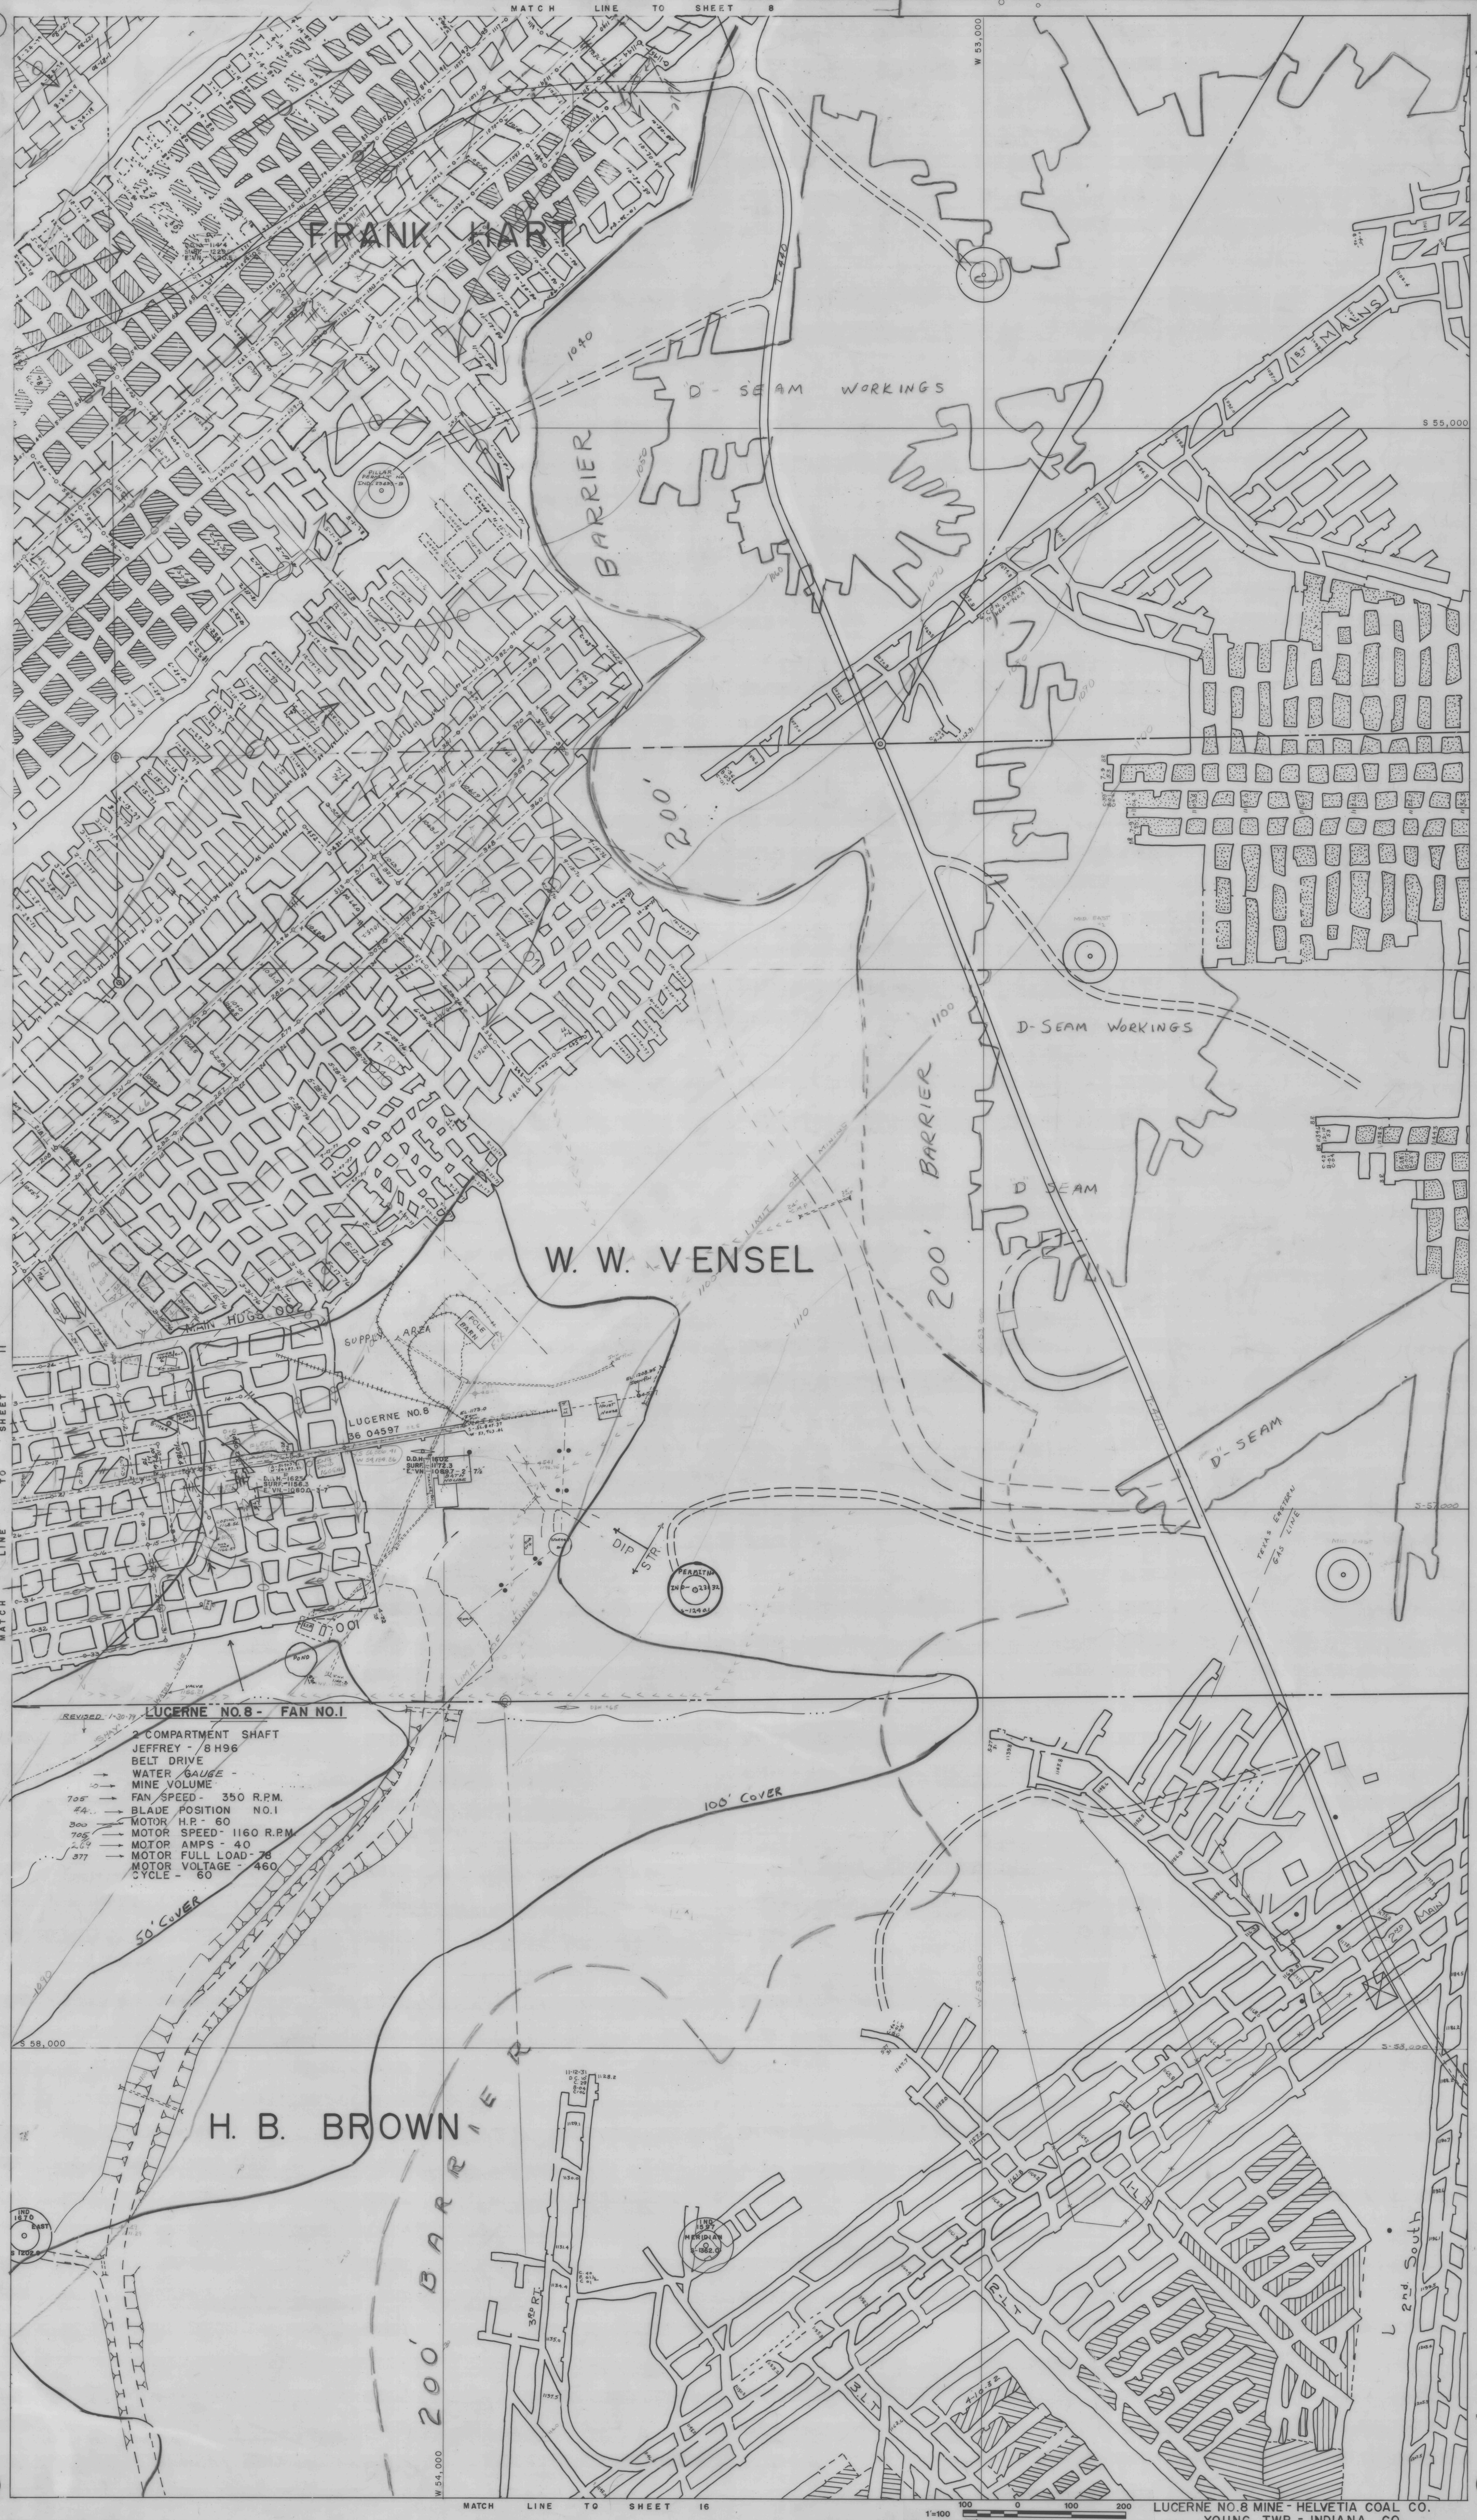

K-12

LUCERNE 8 - E SEAM

K-12

LUCERNE NO. 8 MINE - HELVETIA COAL CO.
YOUNG TWP. - INDIANA CO.