




LUCERNE #9

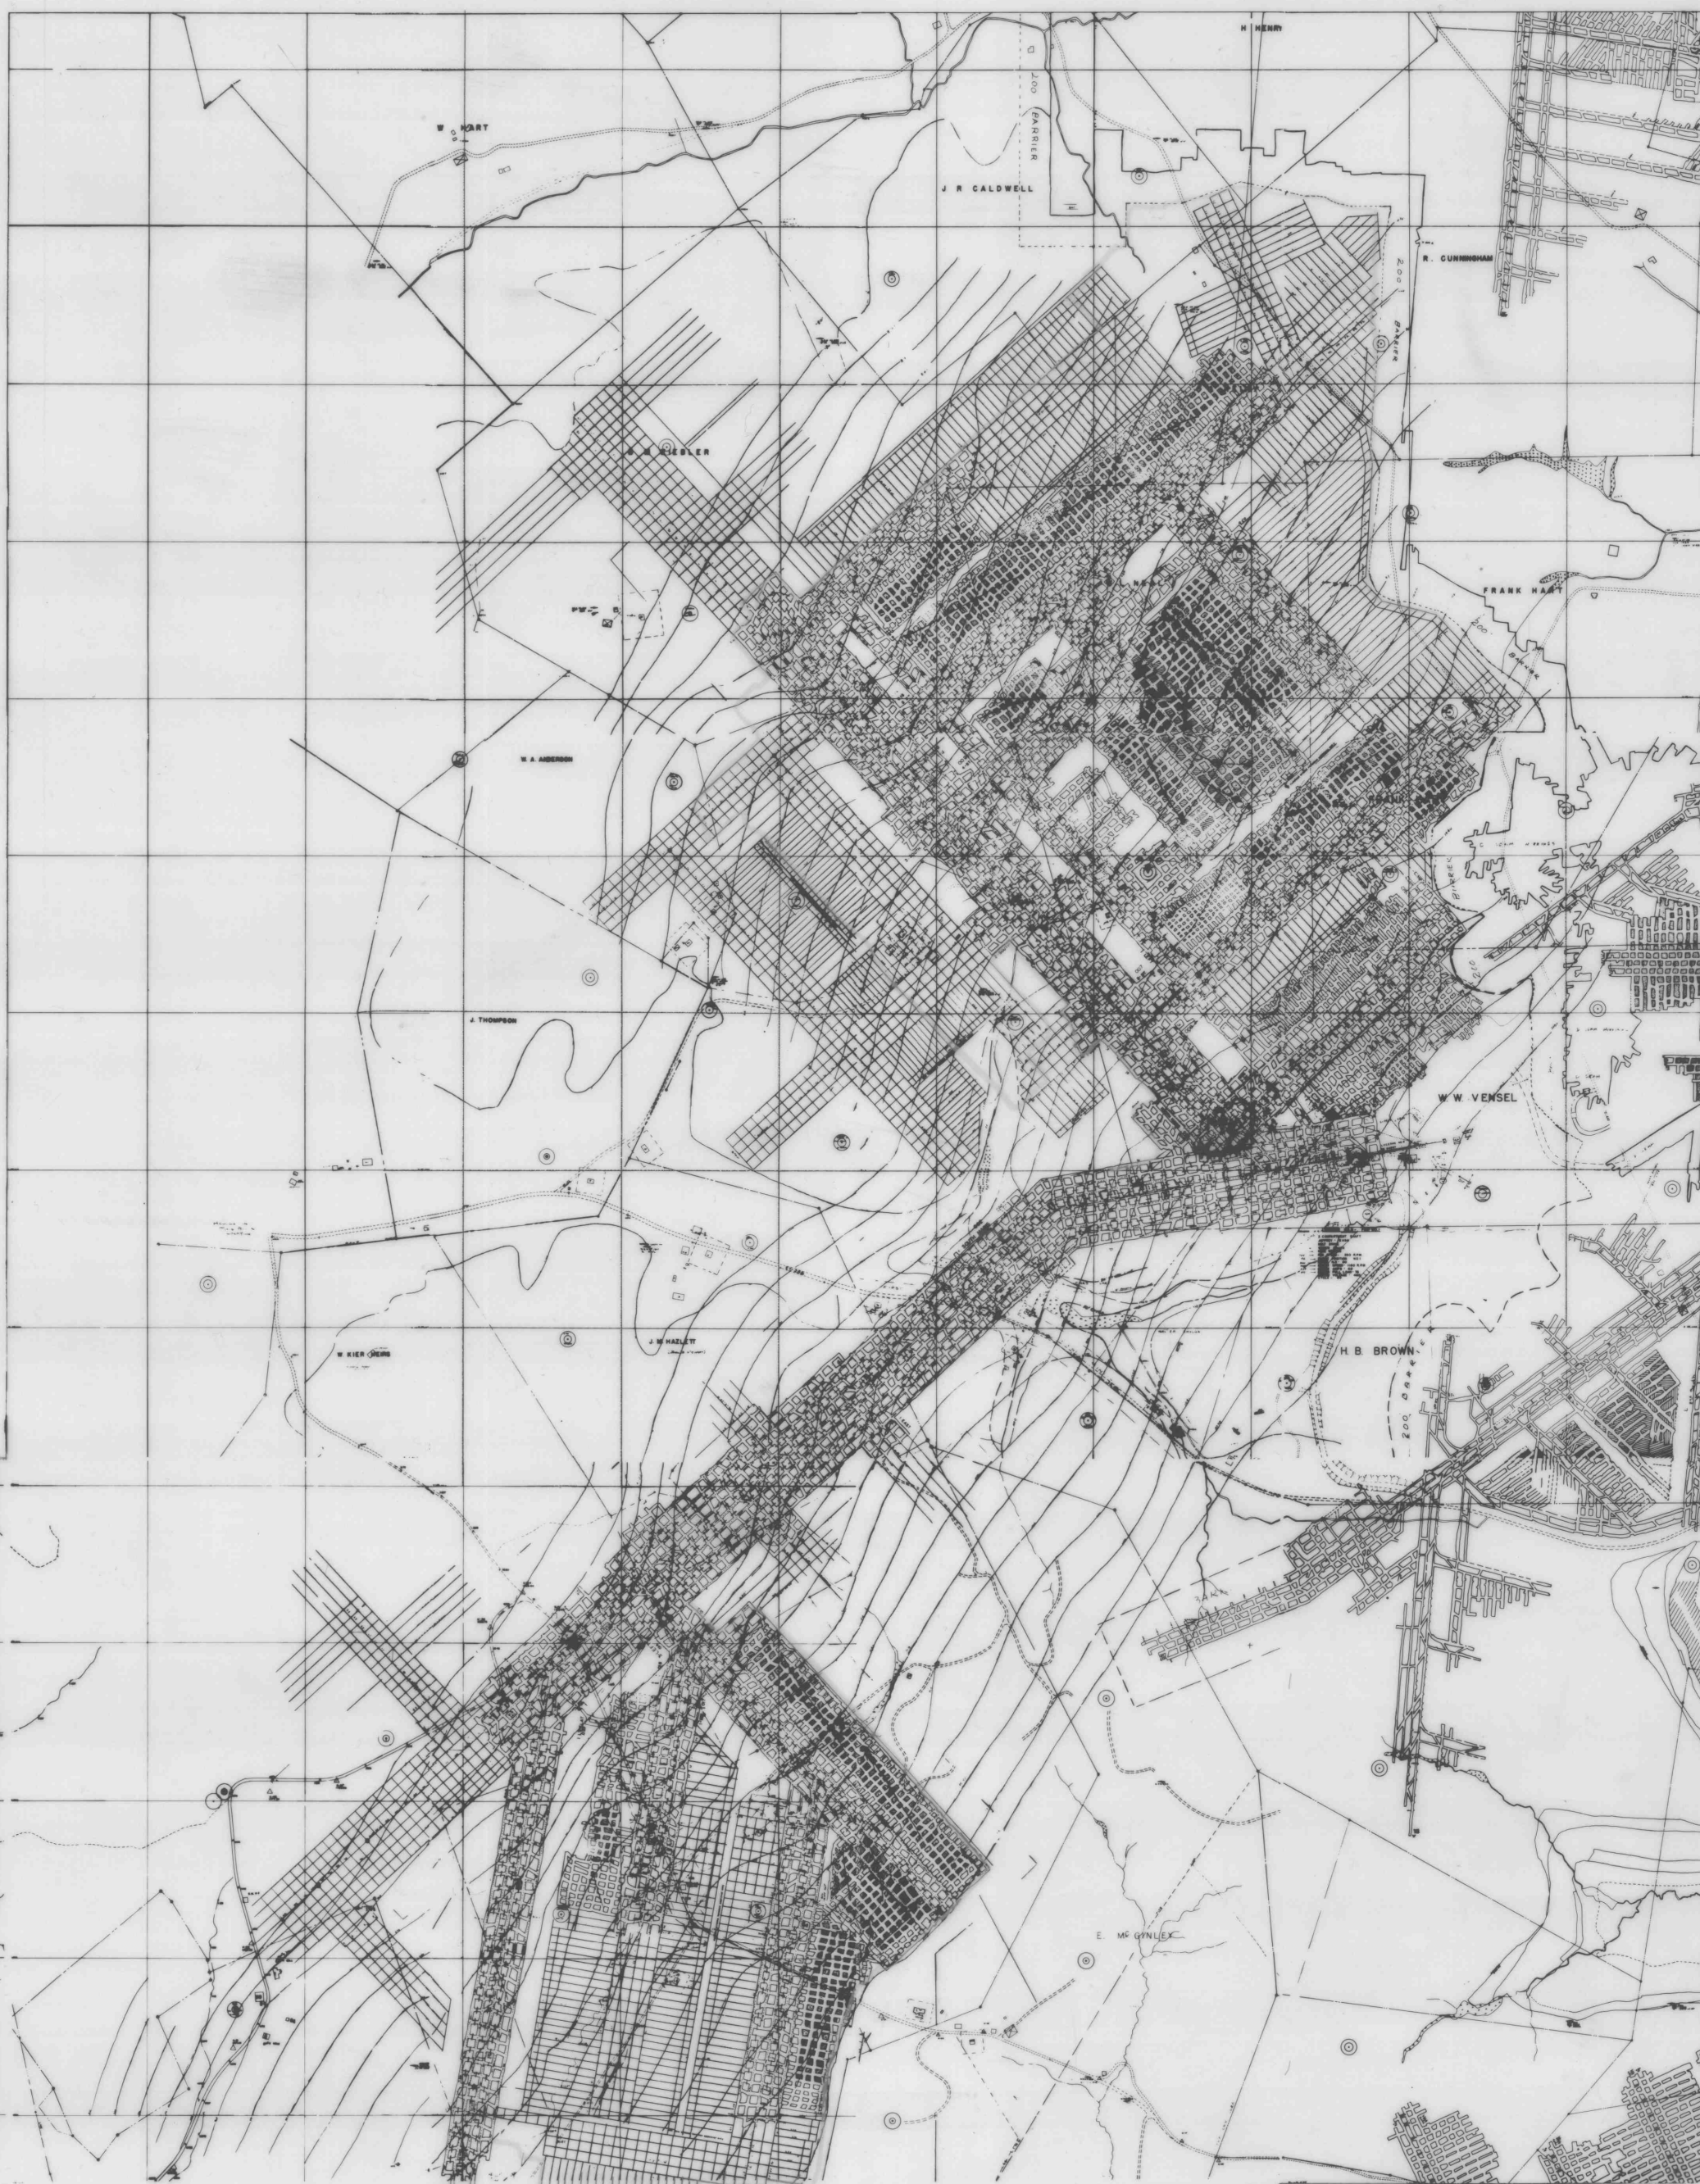

LUCERNE #8

1-1-81 1"-1000
UPDATED POSTING 20TH MINZS (1-1-81)

