


B-39-42

42

VALIER NO. 8 DRAWER 69

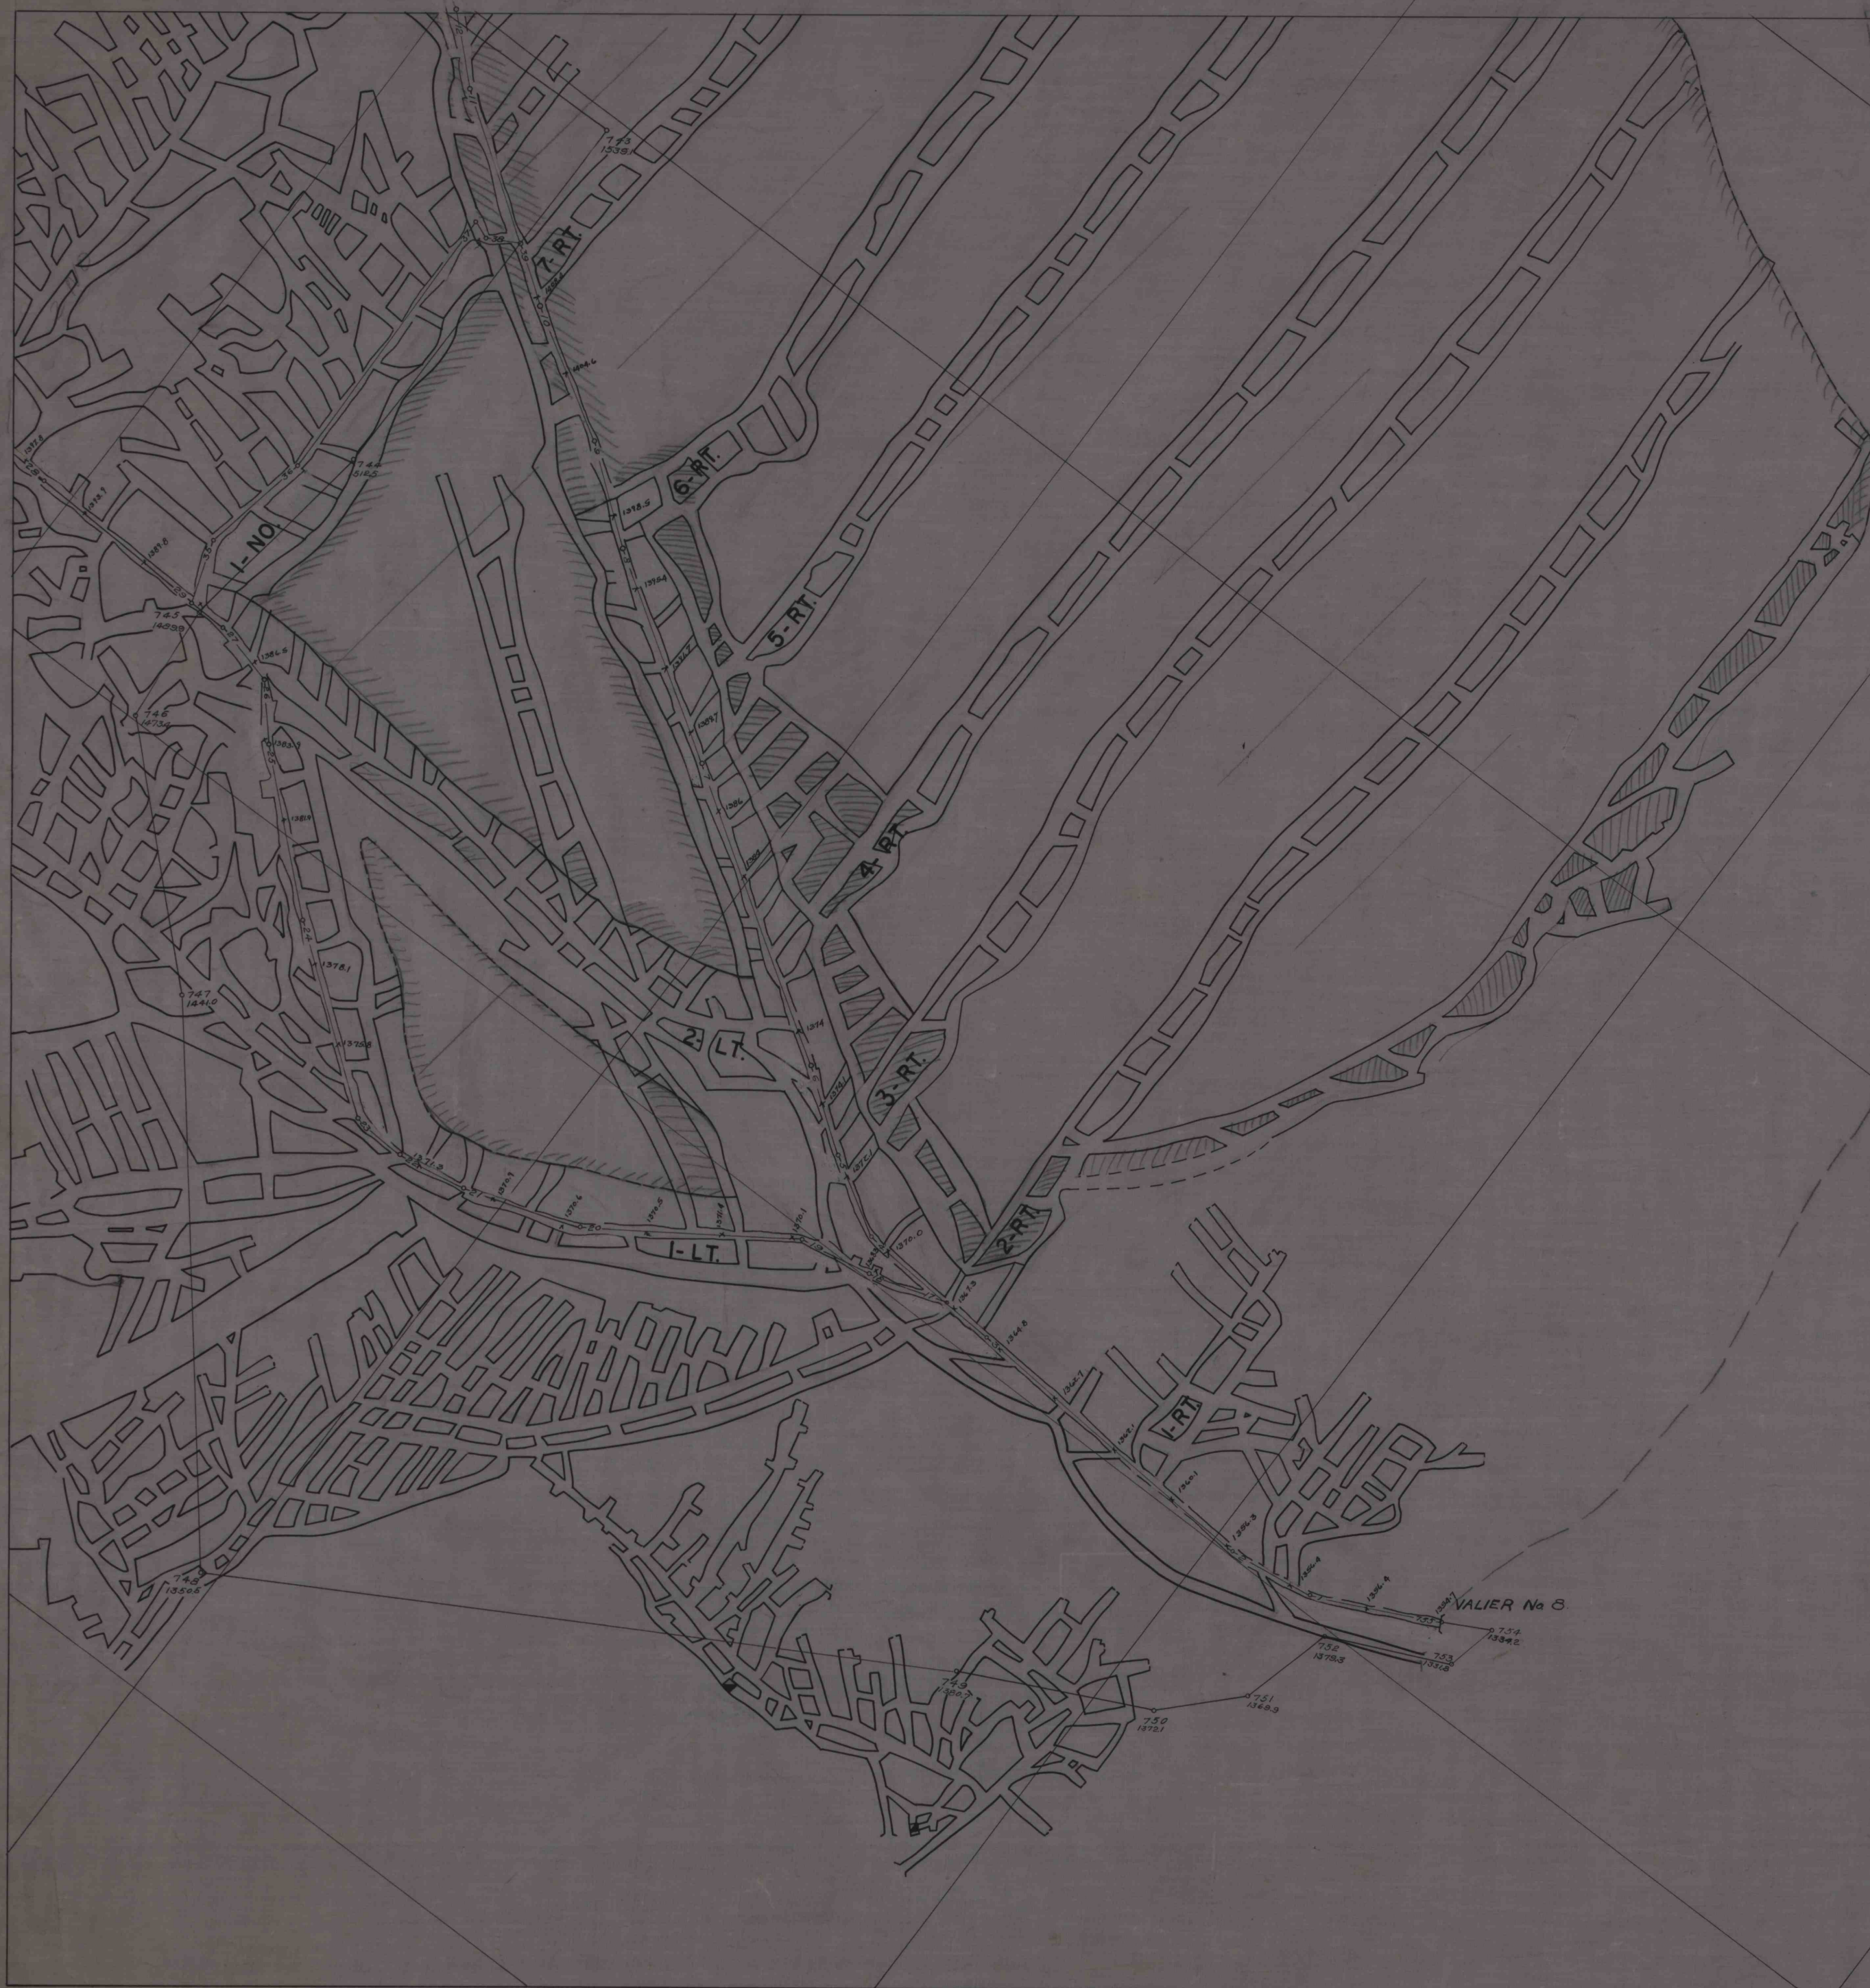

VALIER NO. 8 DRAWER 69 B-39-42

42