


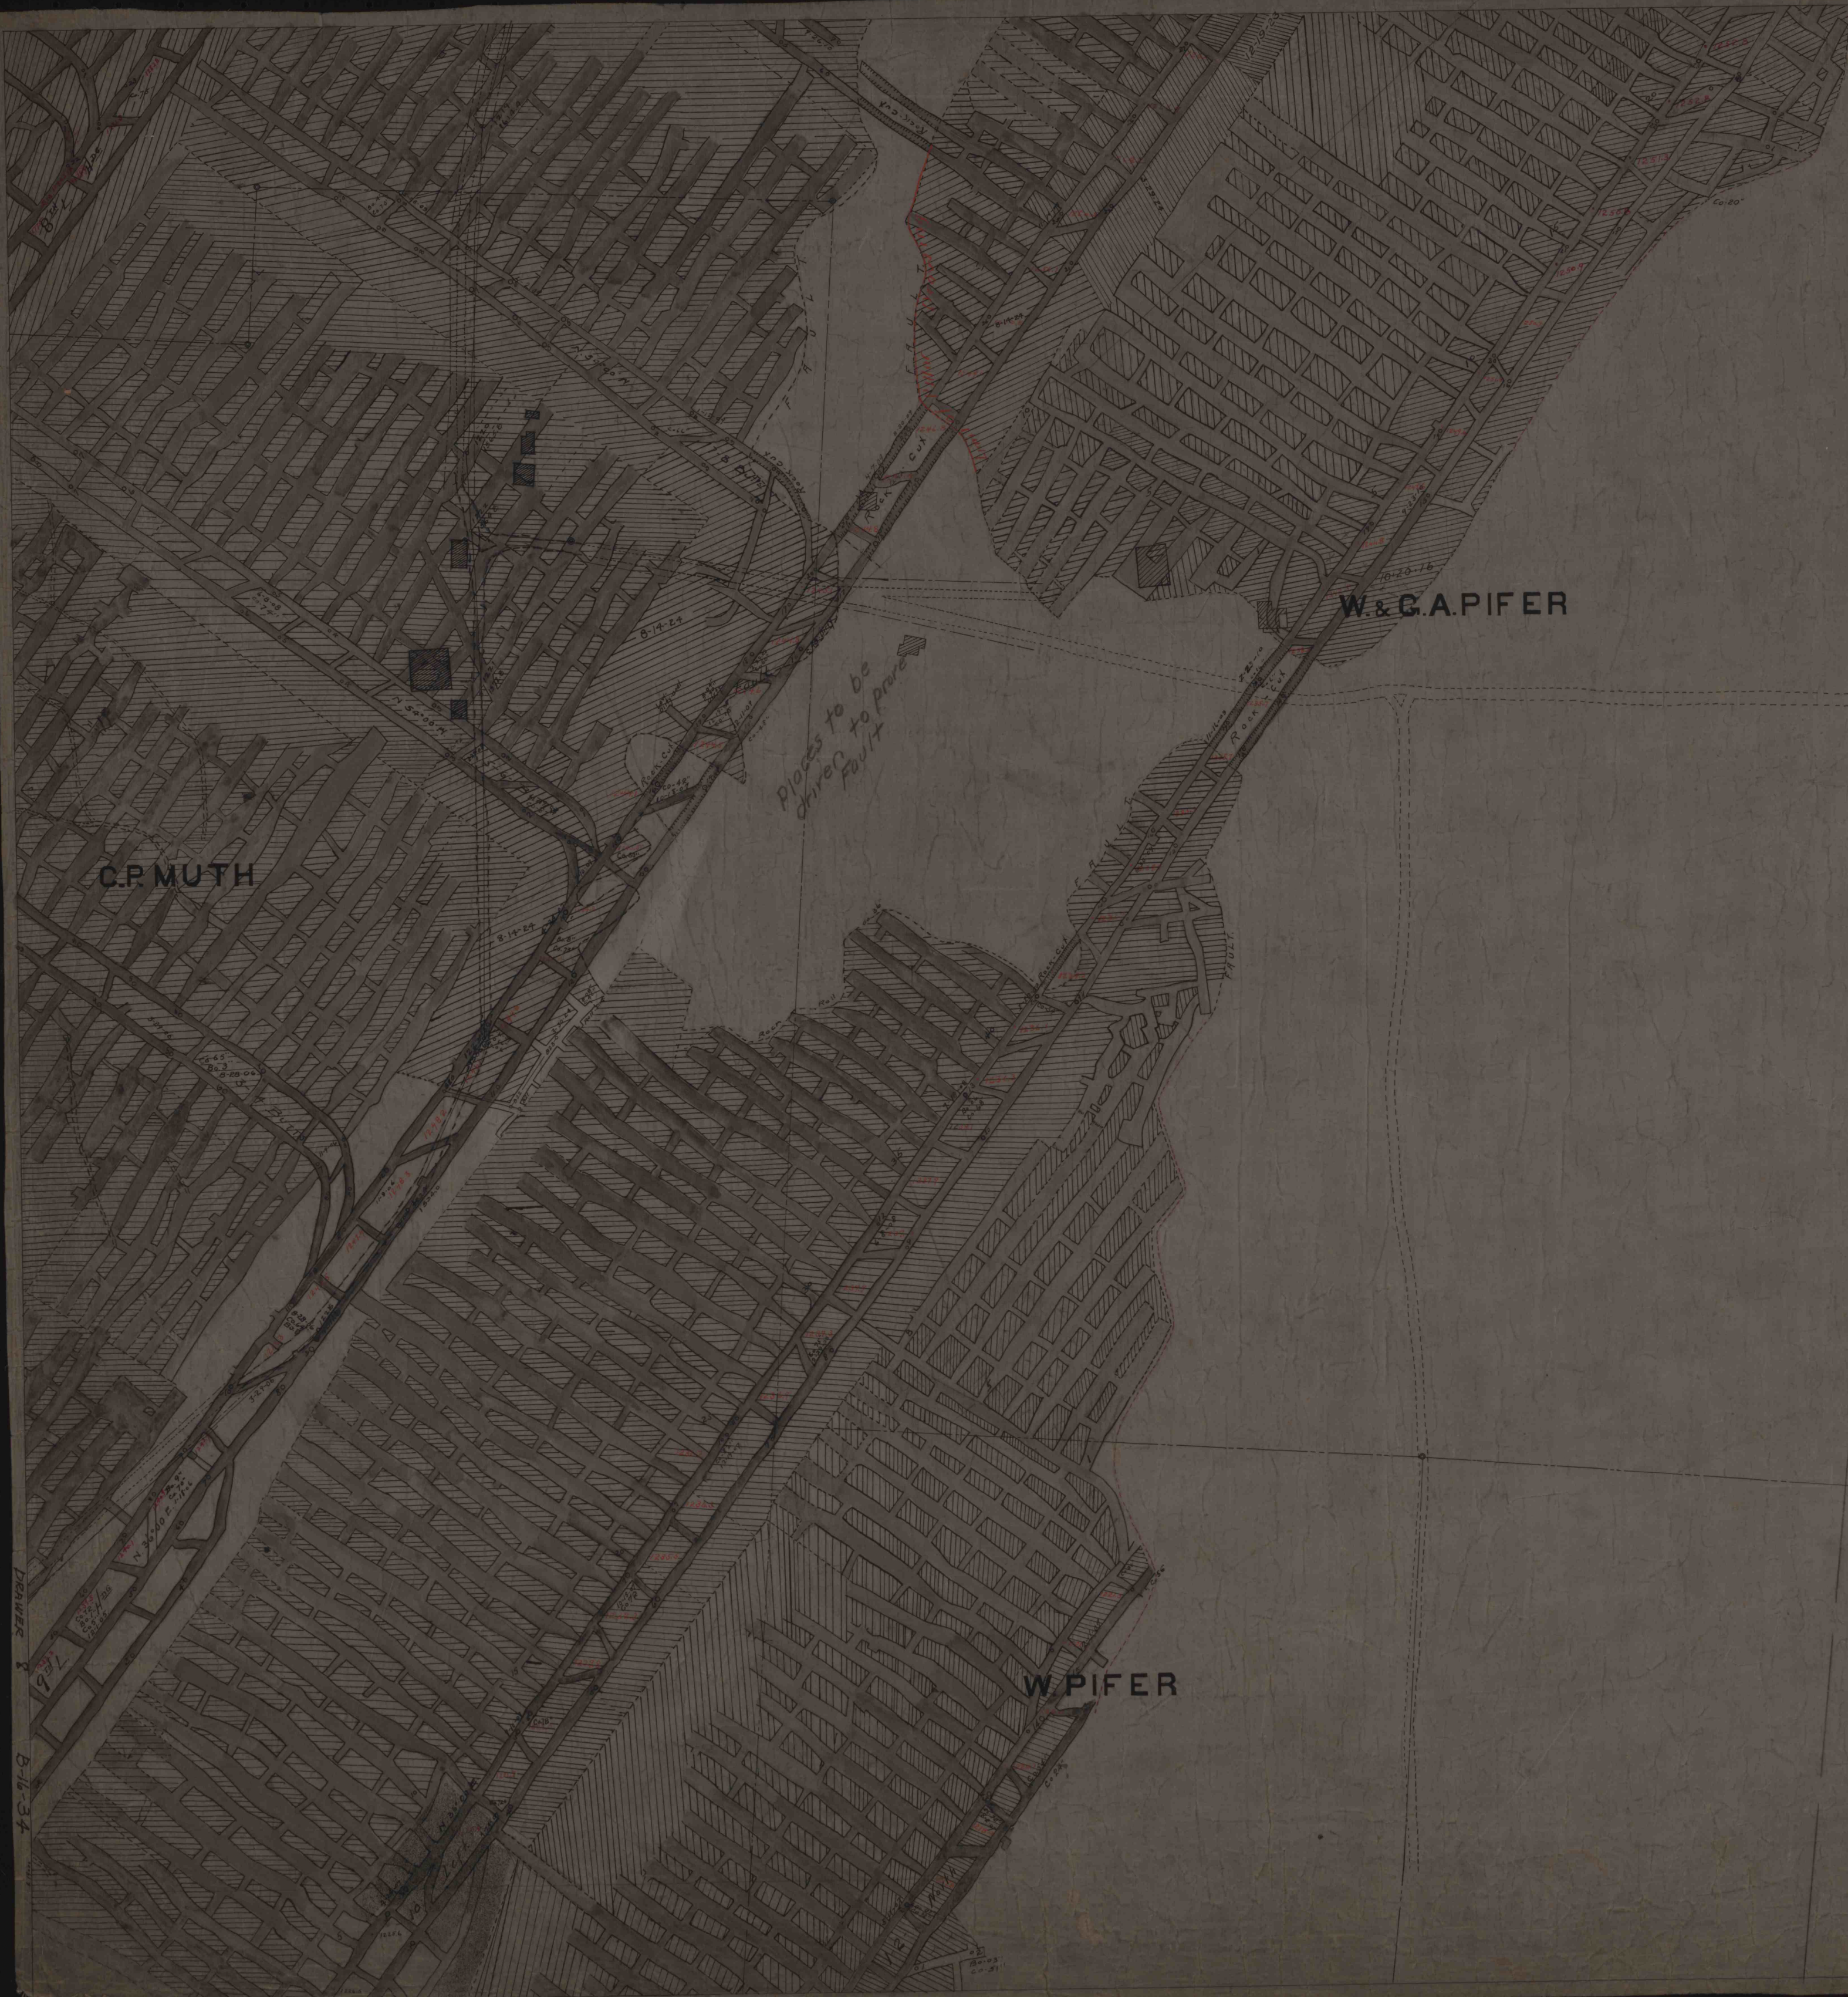

W. & G.A. PIFER

C.P. MUTH

W. PIFER



Places to be
driven to prove
fault