


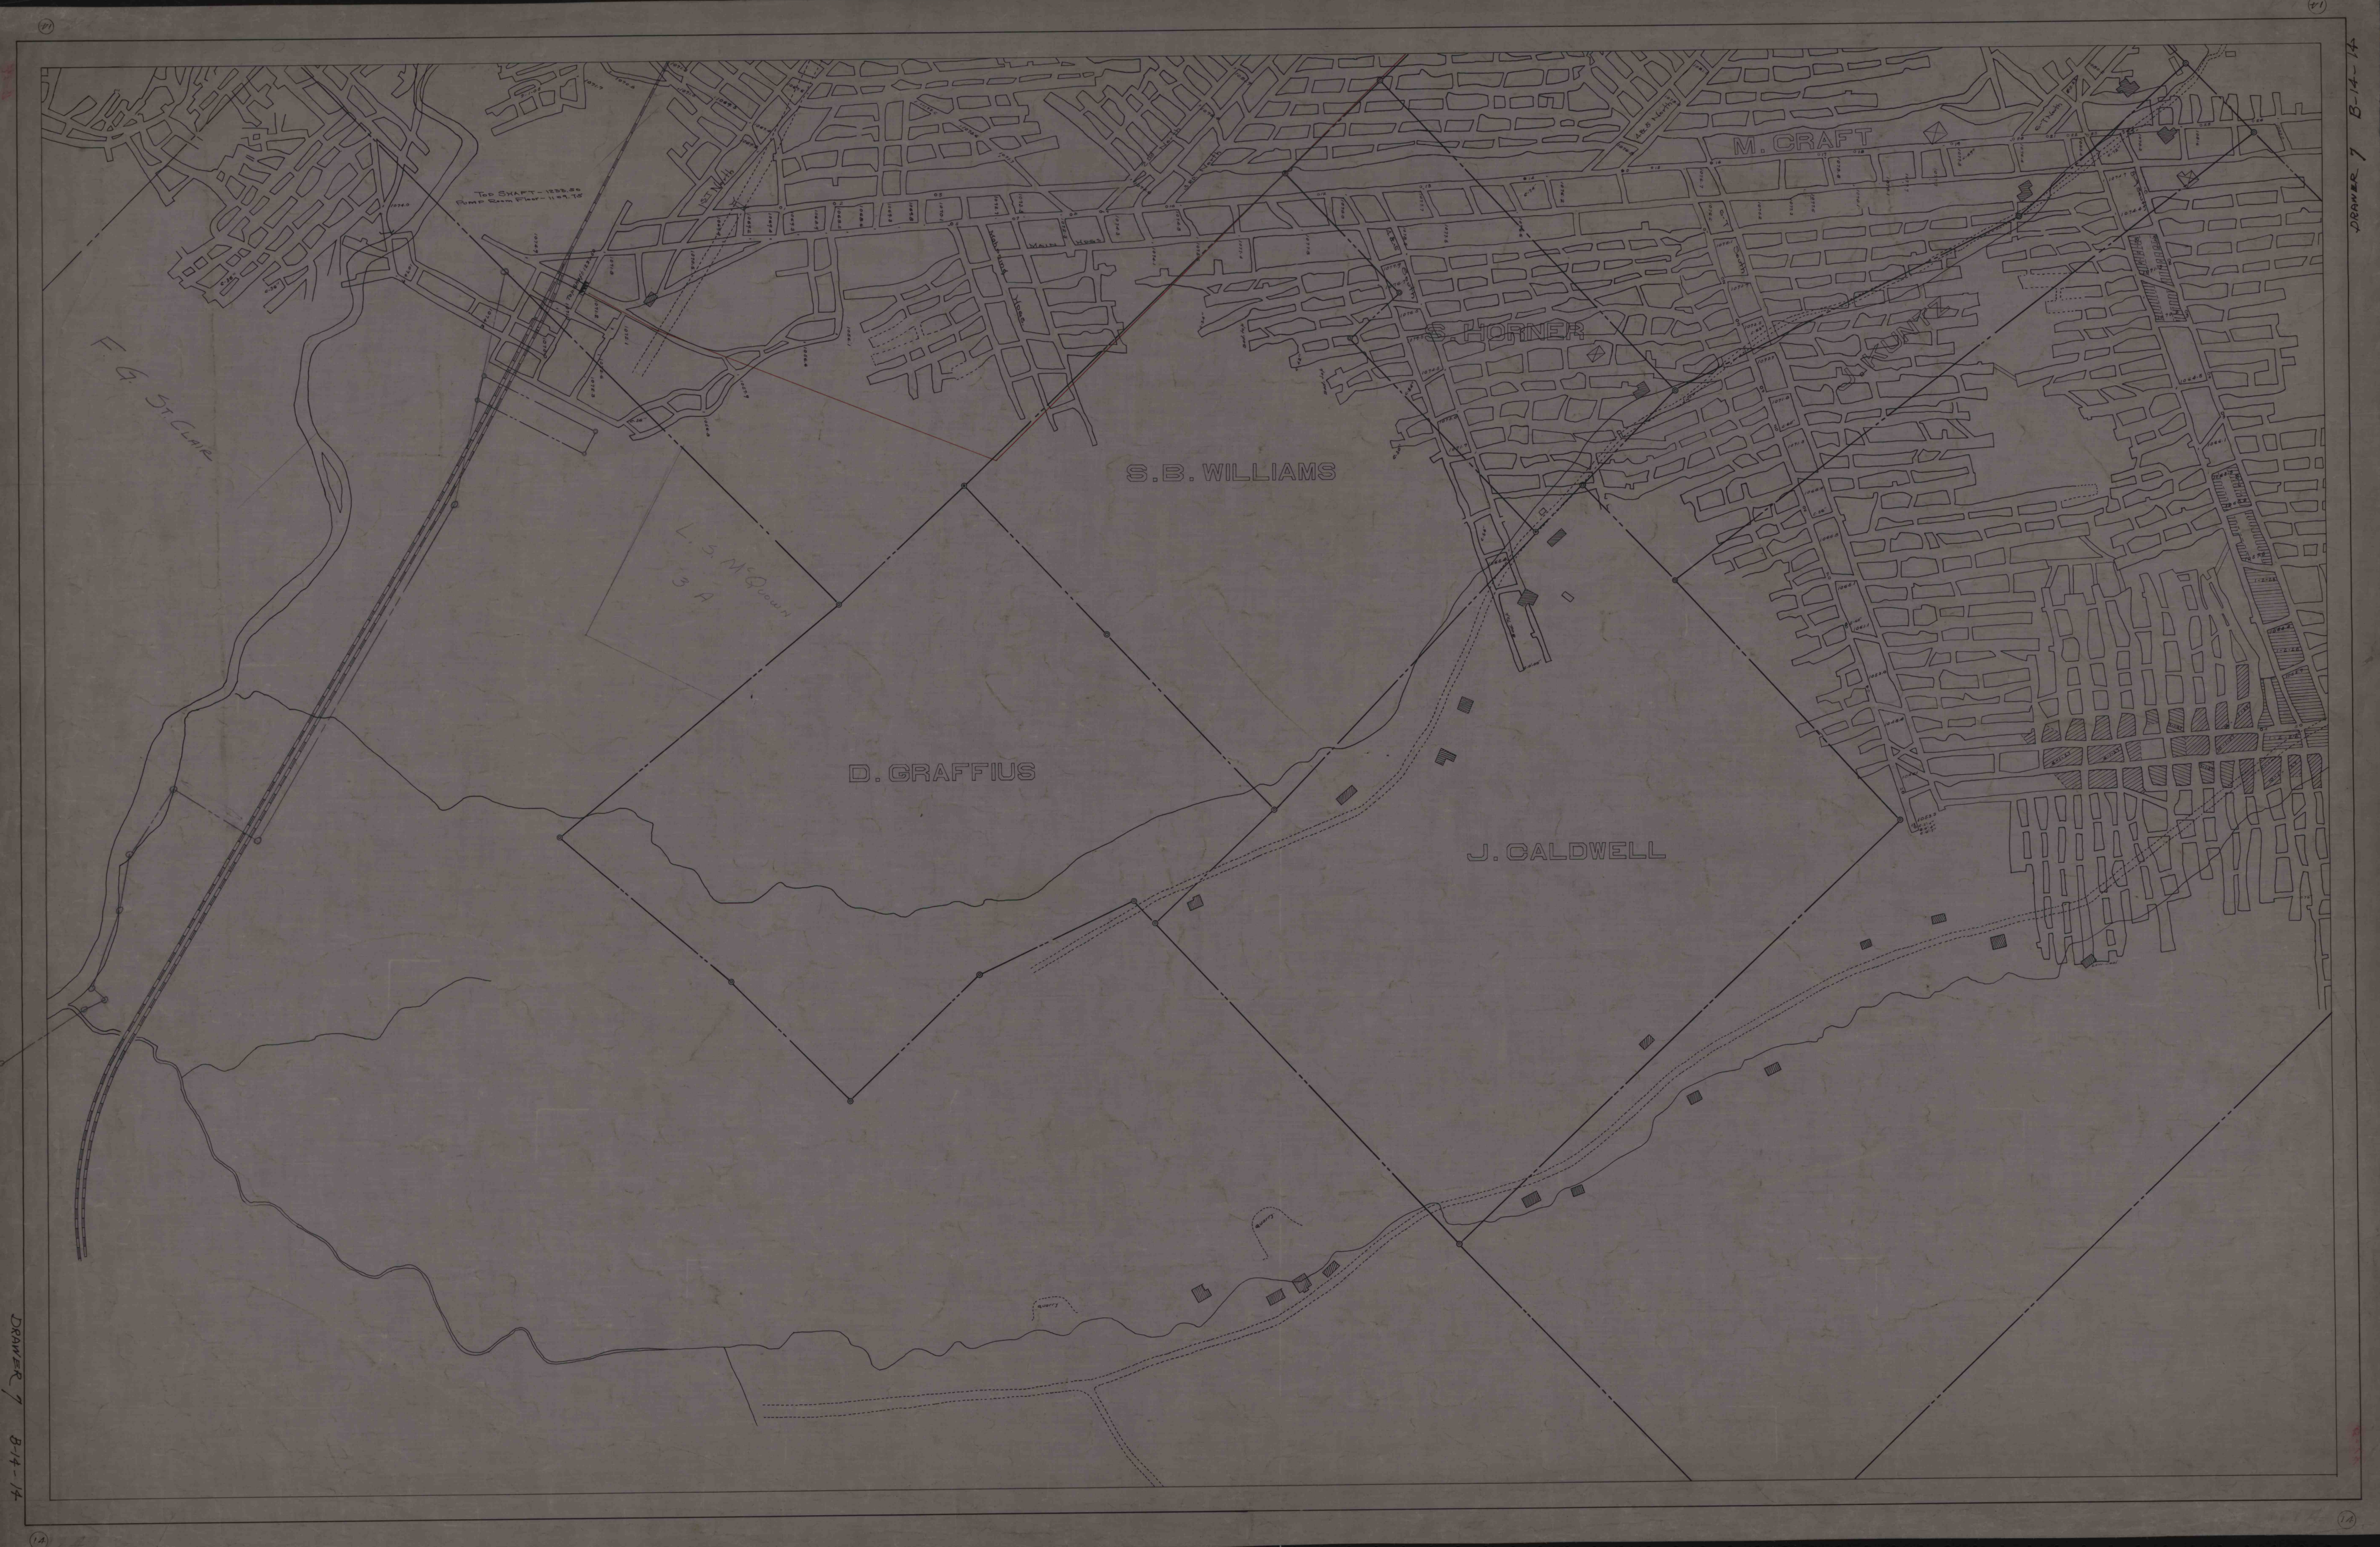

DRAWER 7 B-14-14

DRAWER 7 B-14-14