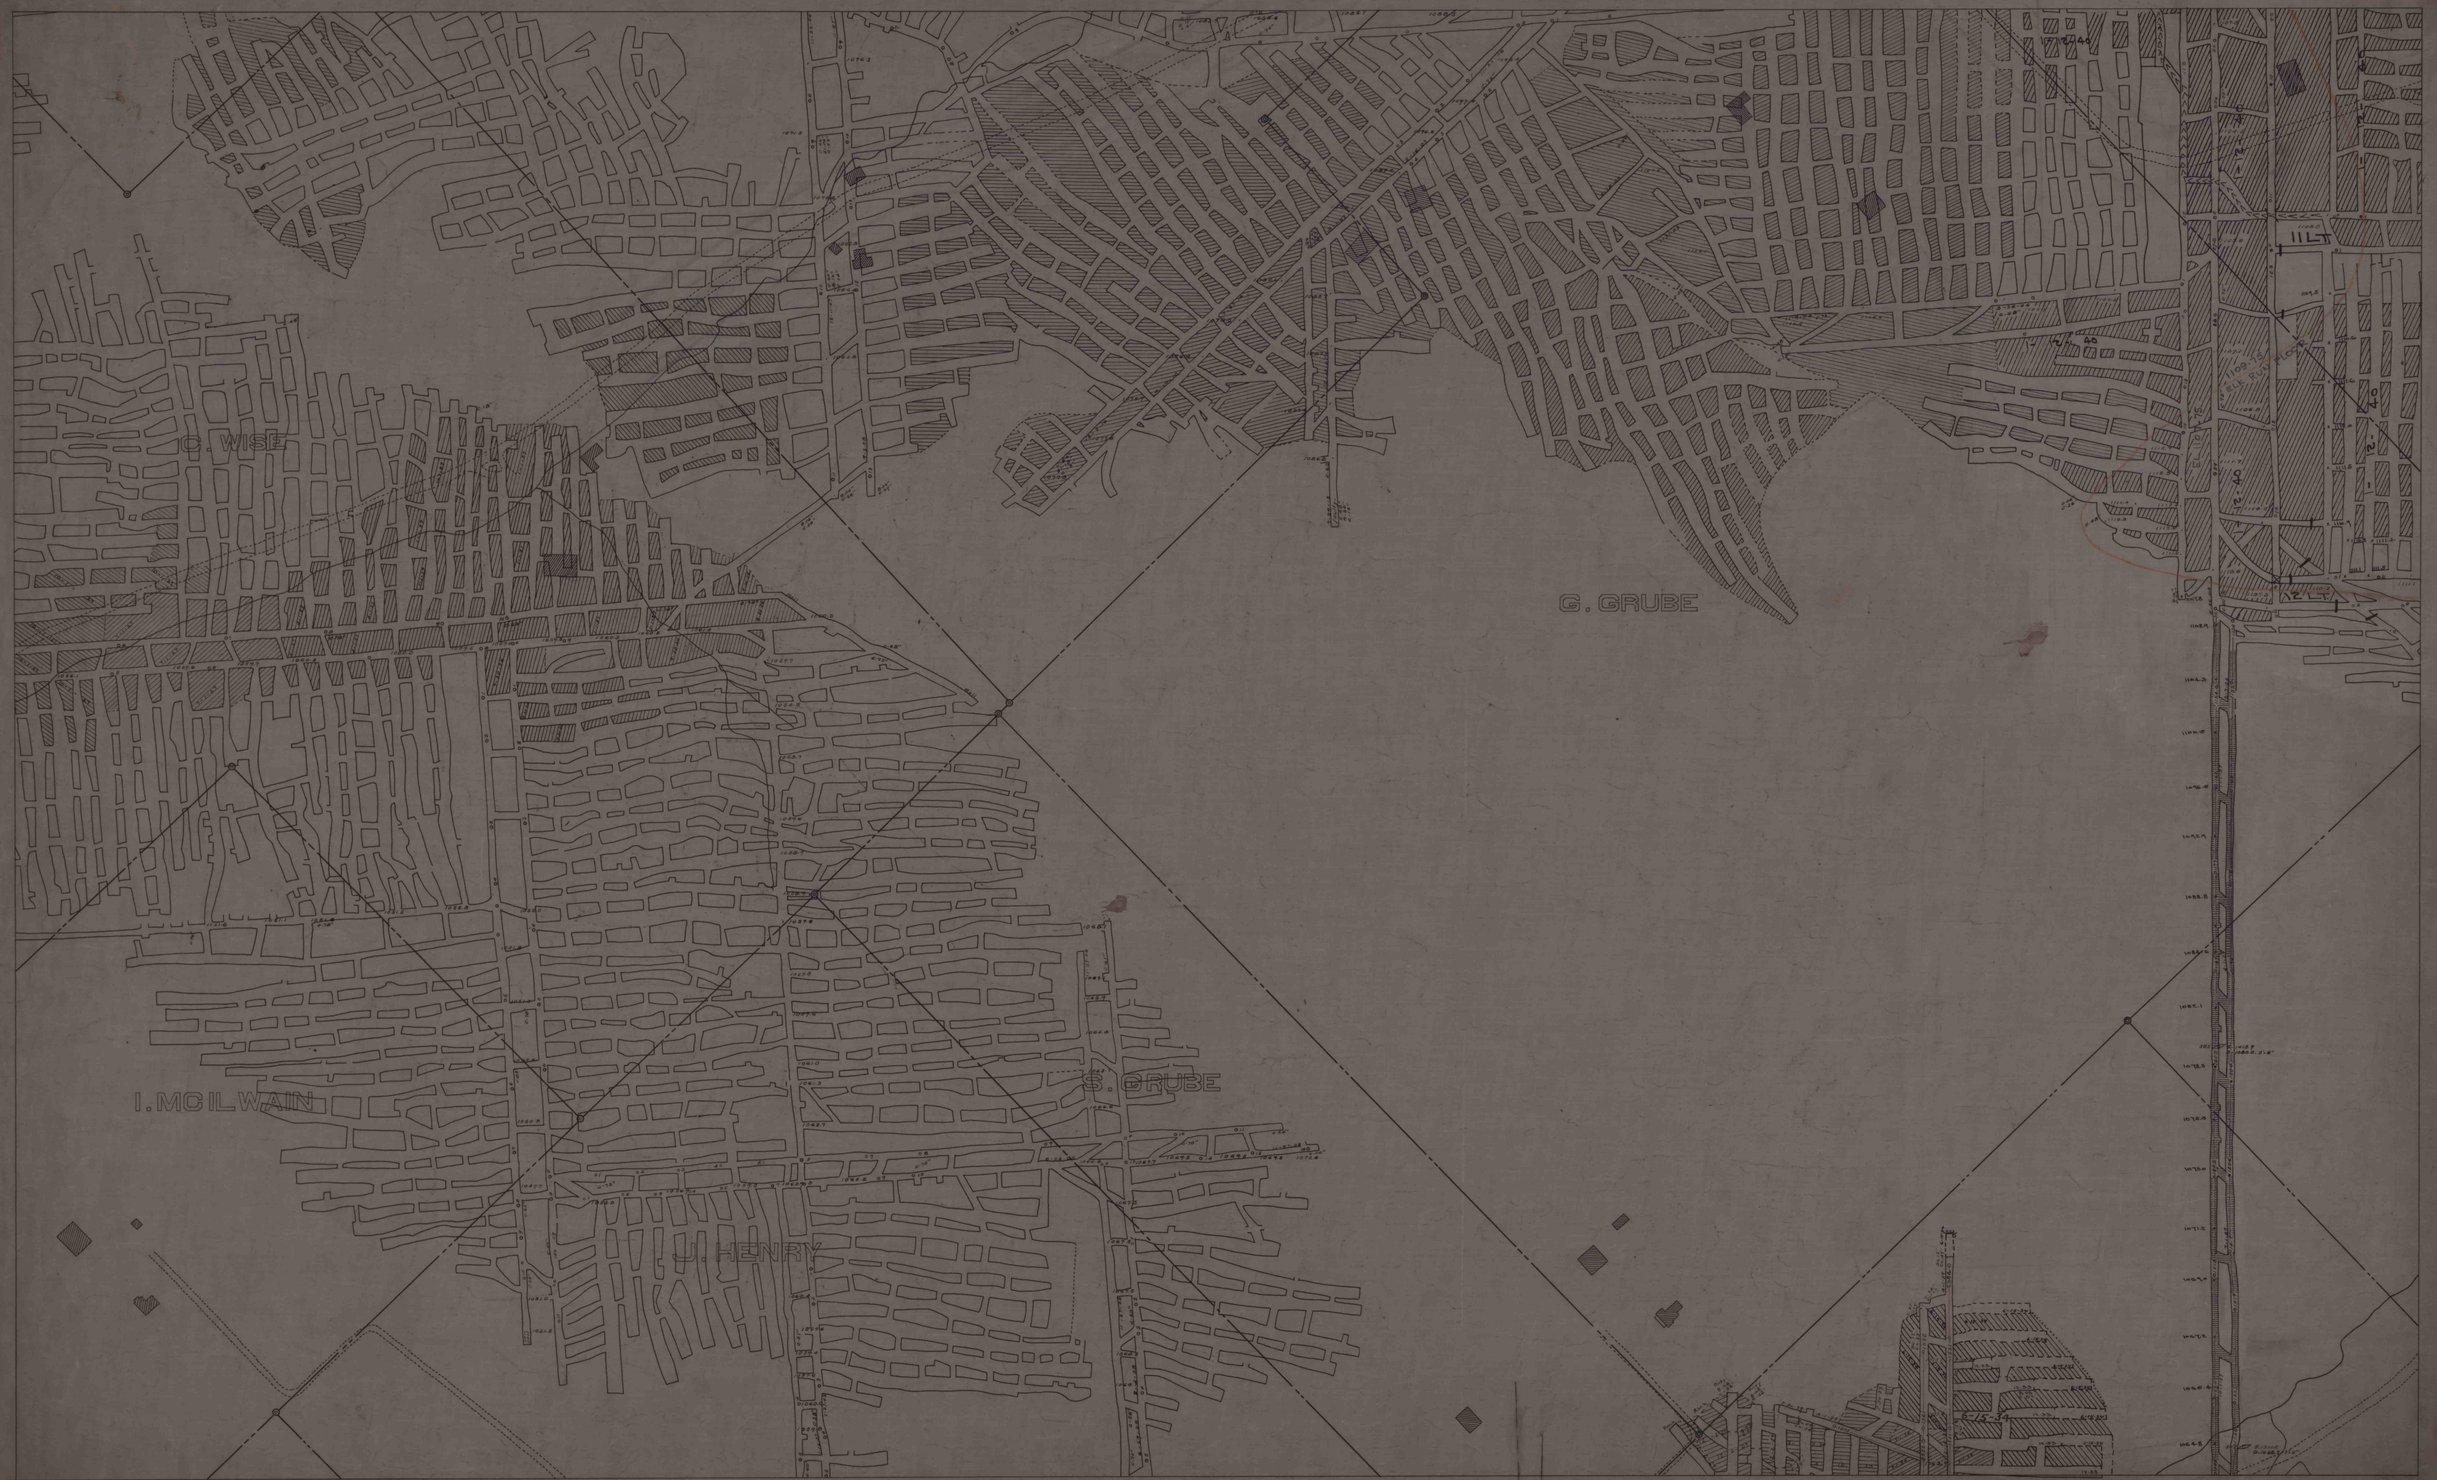
G. WISE
G. GRUBE
I. MCILWAIN
S. GRUBE
J. J. HENRY
11 ST
DRAWER 7 B-14-15
DRAWER 7 B-14-15