


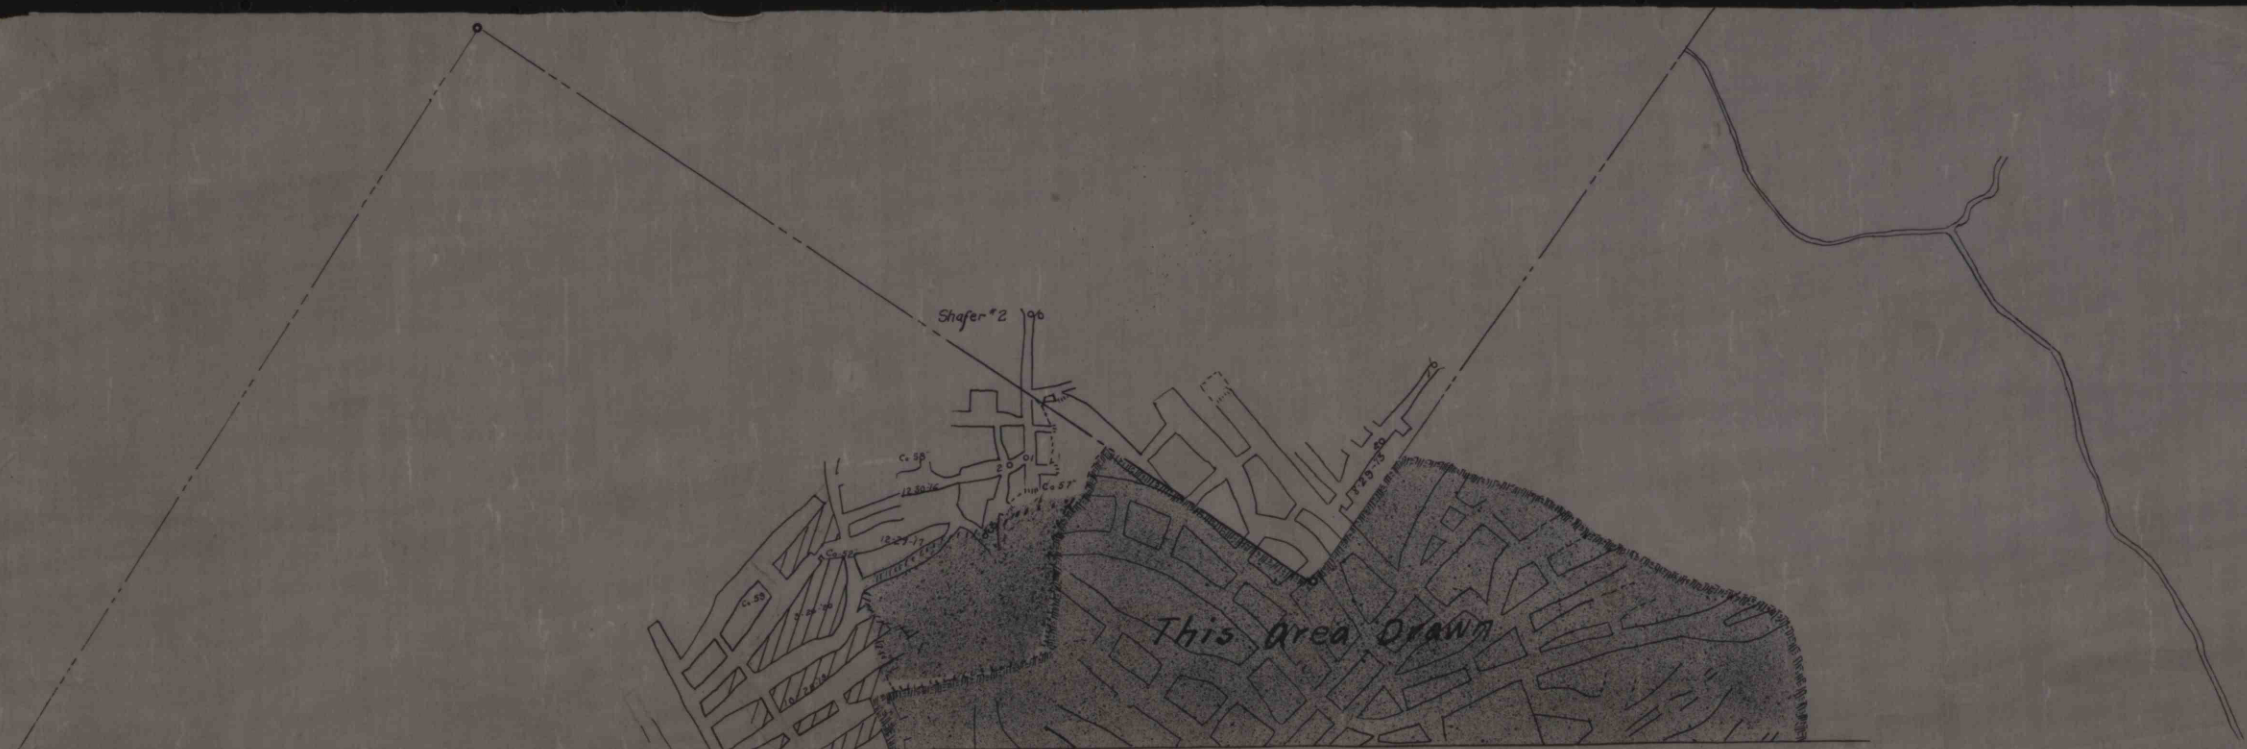

DRAWER 10 B-19-1B

DRAWER 10

B-19-1B