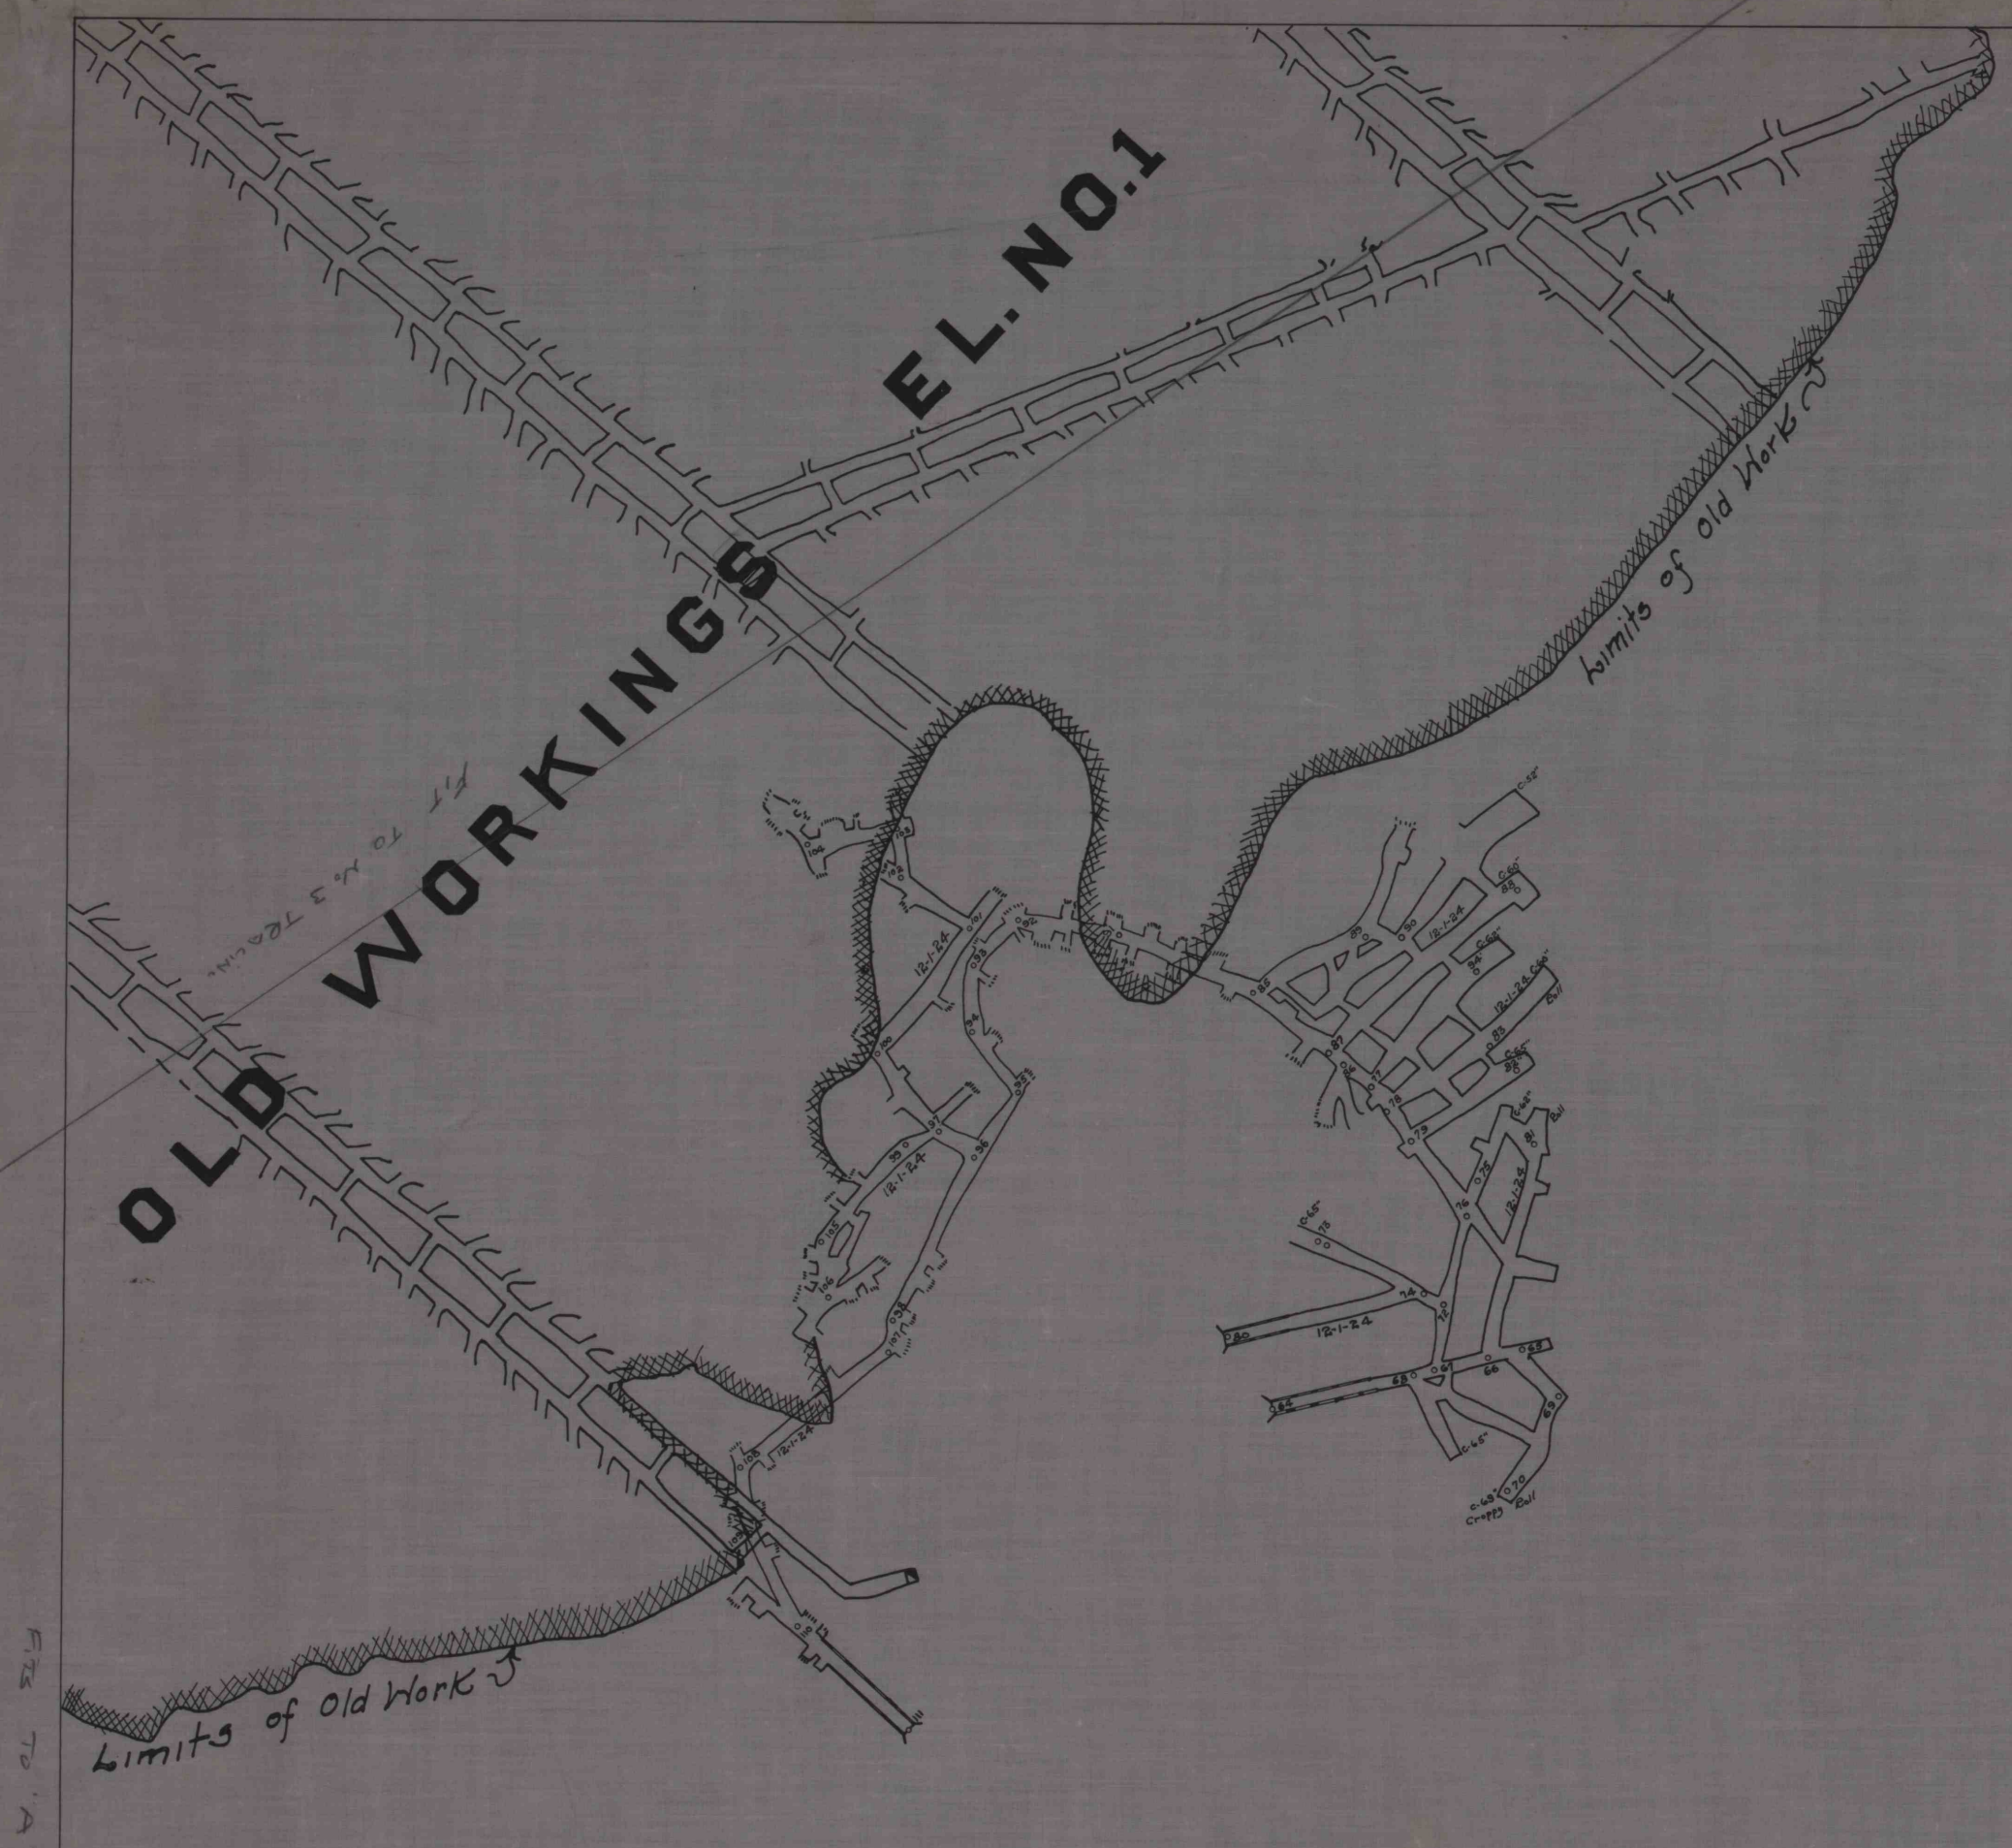


EL. NO. 1
OLD WORKINGS
Limits of Old Work
DRAWER 10
B-21-3A

DRAWER 10
B-21-3A