


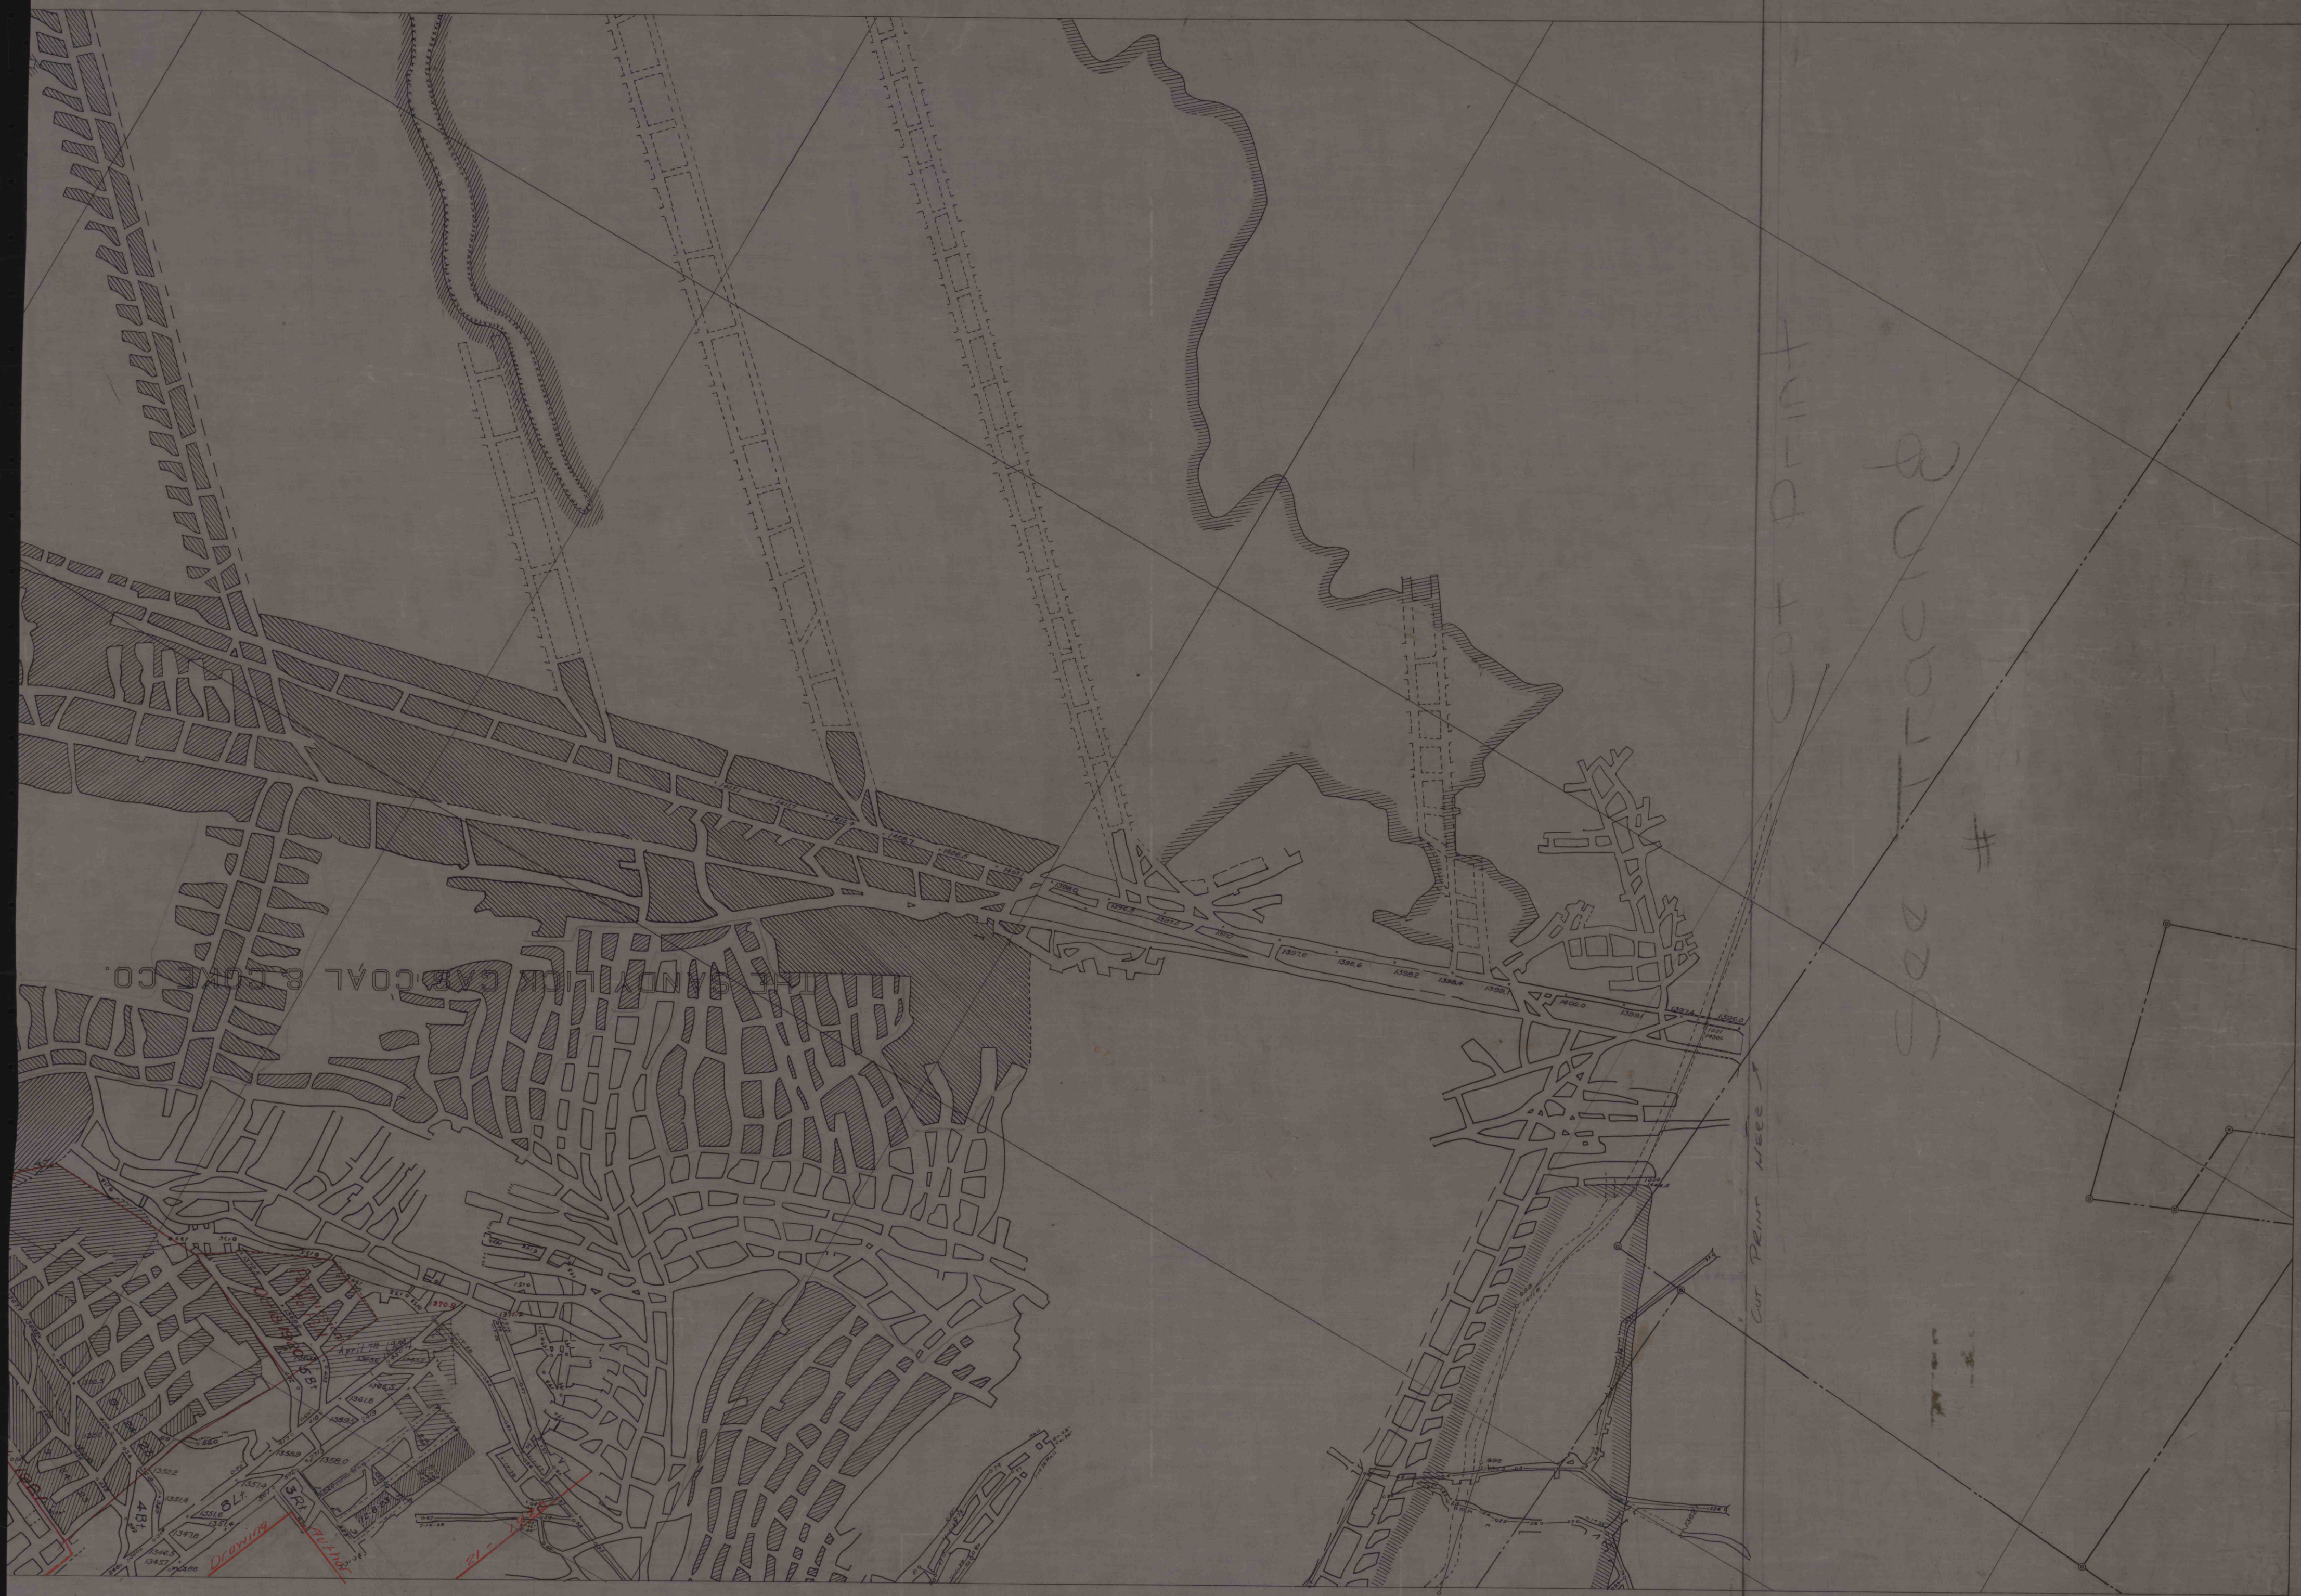

B-21-3 DRAWER 10