



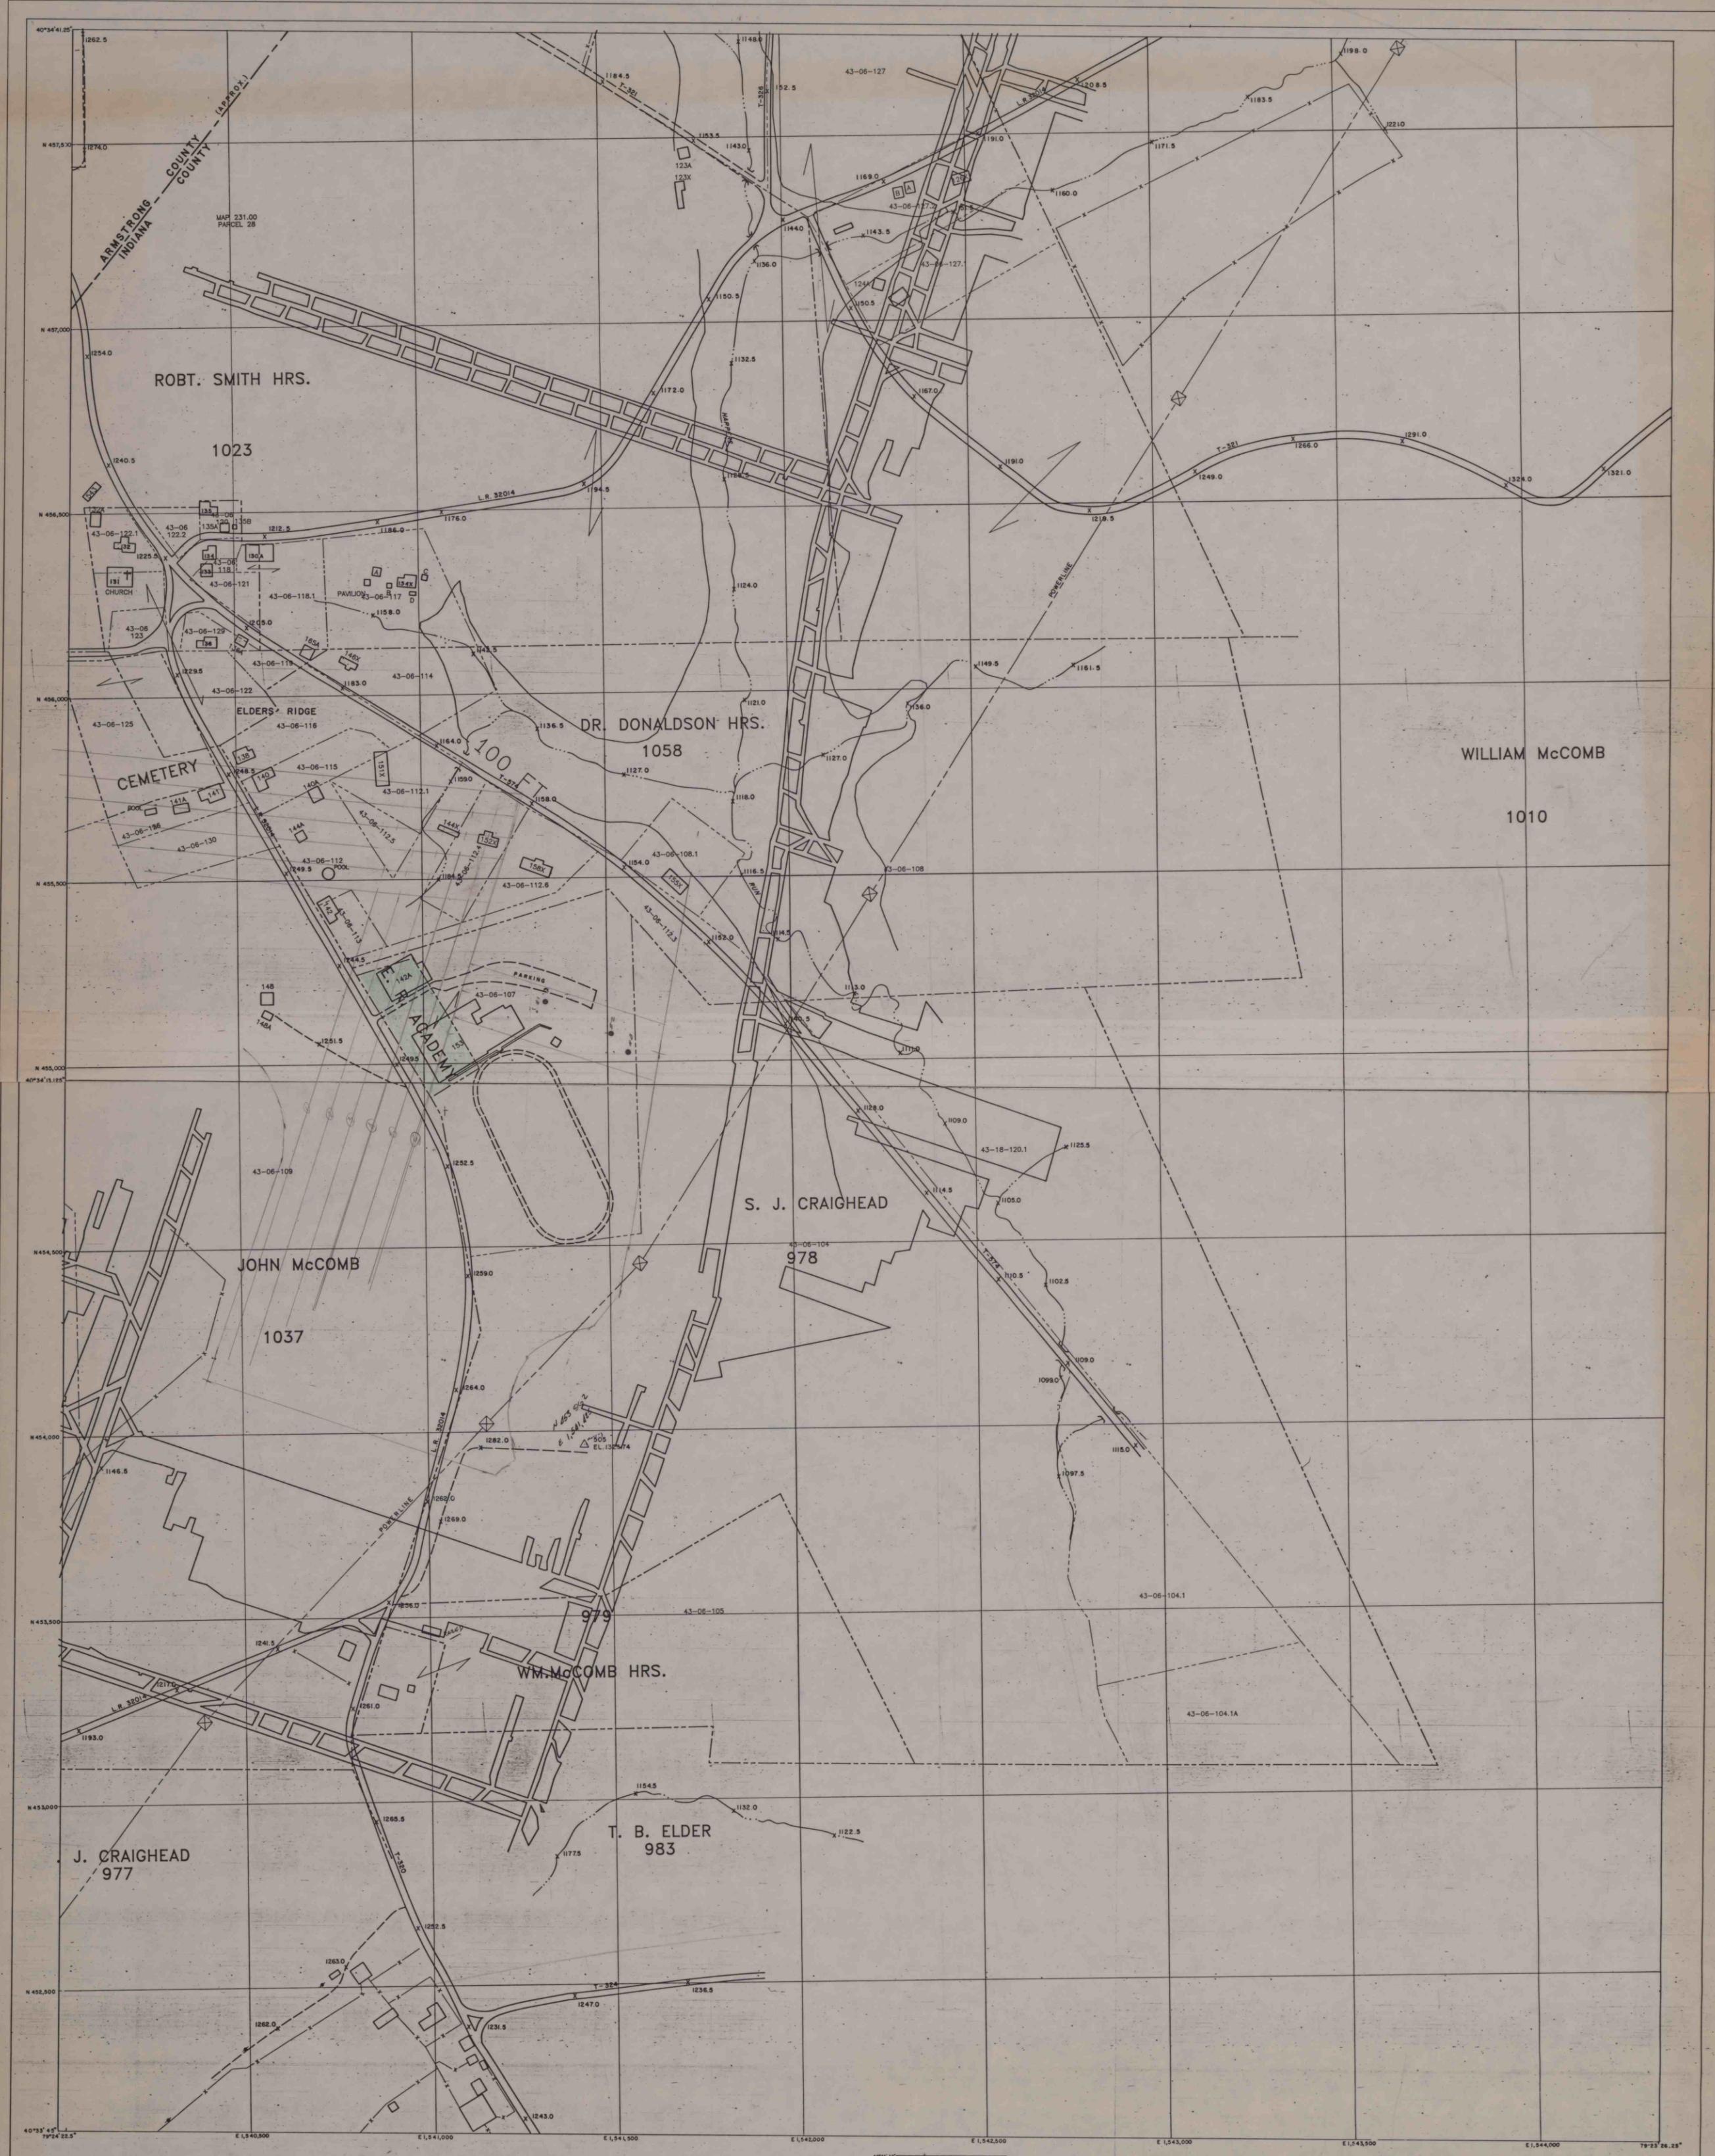

Prepared By
MICHAEL BAKER, JR., INC.
Consulting Engineers
Baker, Pennsylvania

SCALE: 1" = 100'
0 100 200 300

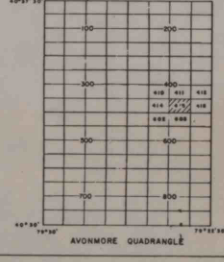

Map Showing
Iselin Ridge
School Area
Well Area
- LARRY -
What for D.C. Right
on water supply. 1-20-91

ROCHESTER AND PITTSBURGH COAL CO.
855 CHURCH STREET, INDIANA, PA.
ISELIN AREA
INDIANA COUNTY
AVONMORE QUADRANGLE
SHEET NO. 4030-790330/418