


Overburden
+ Roads

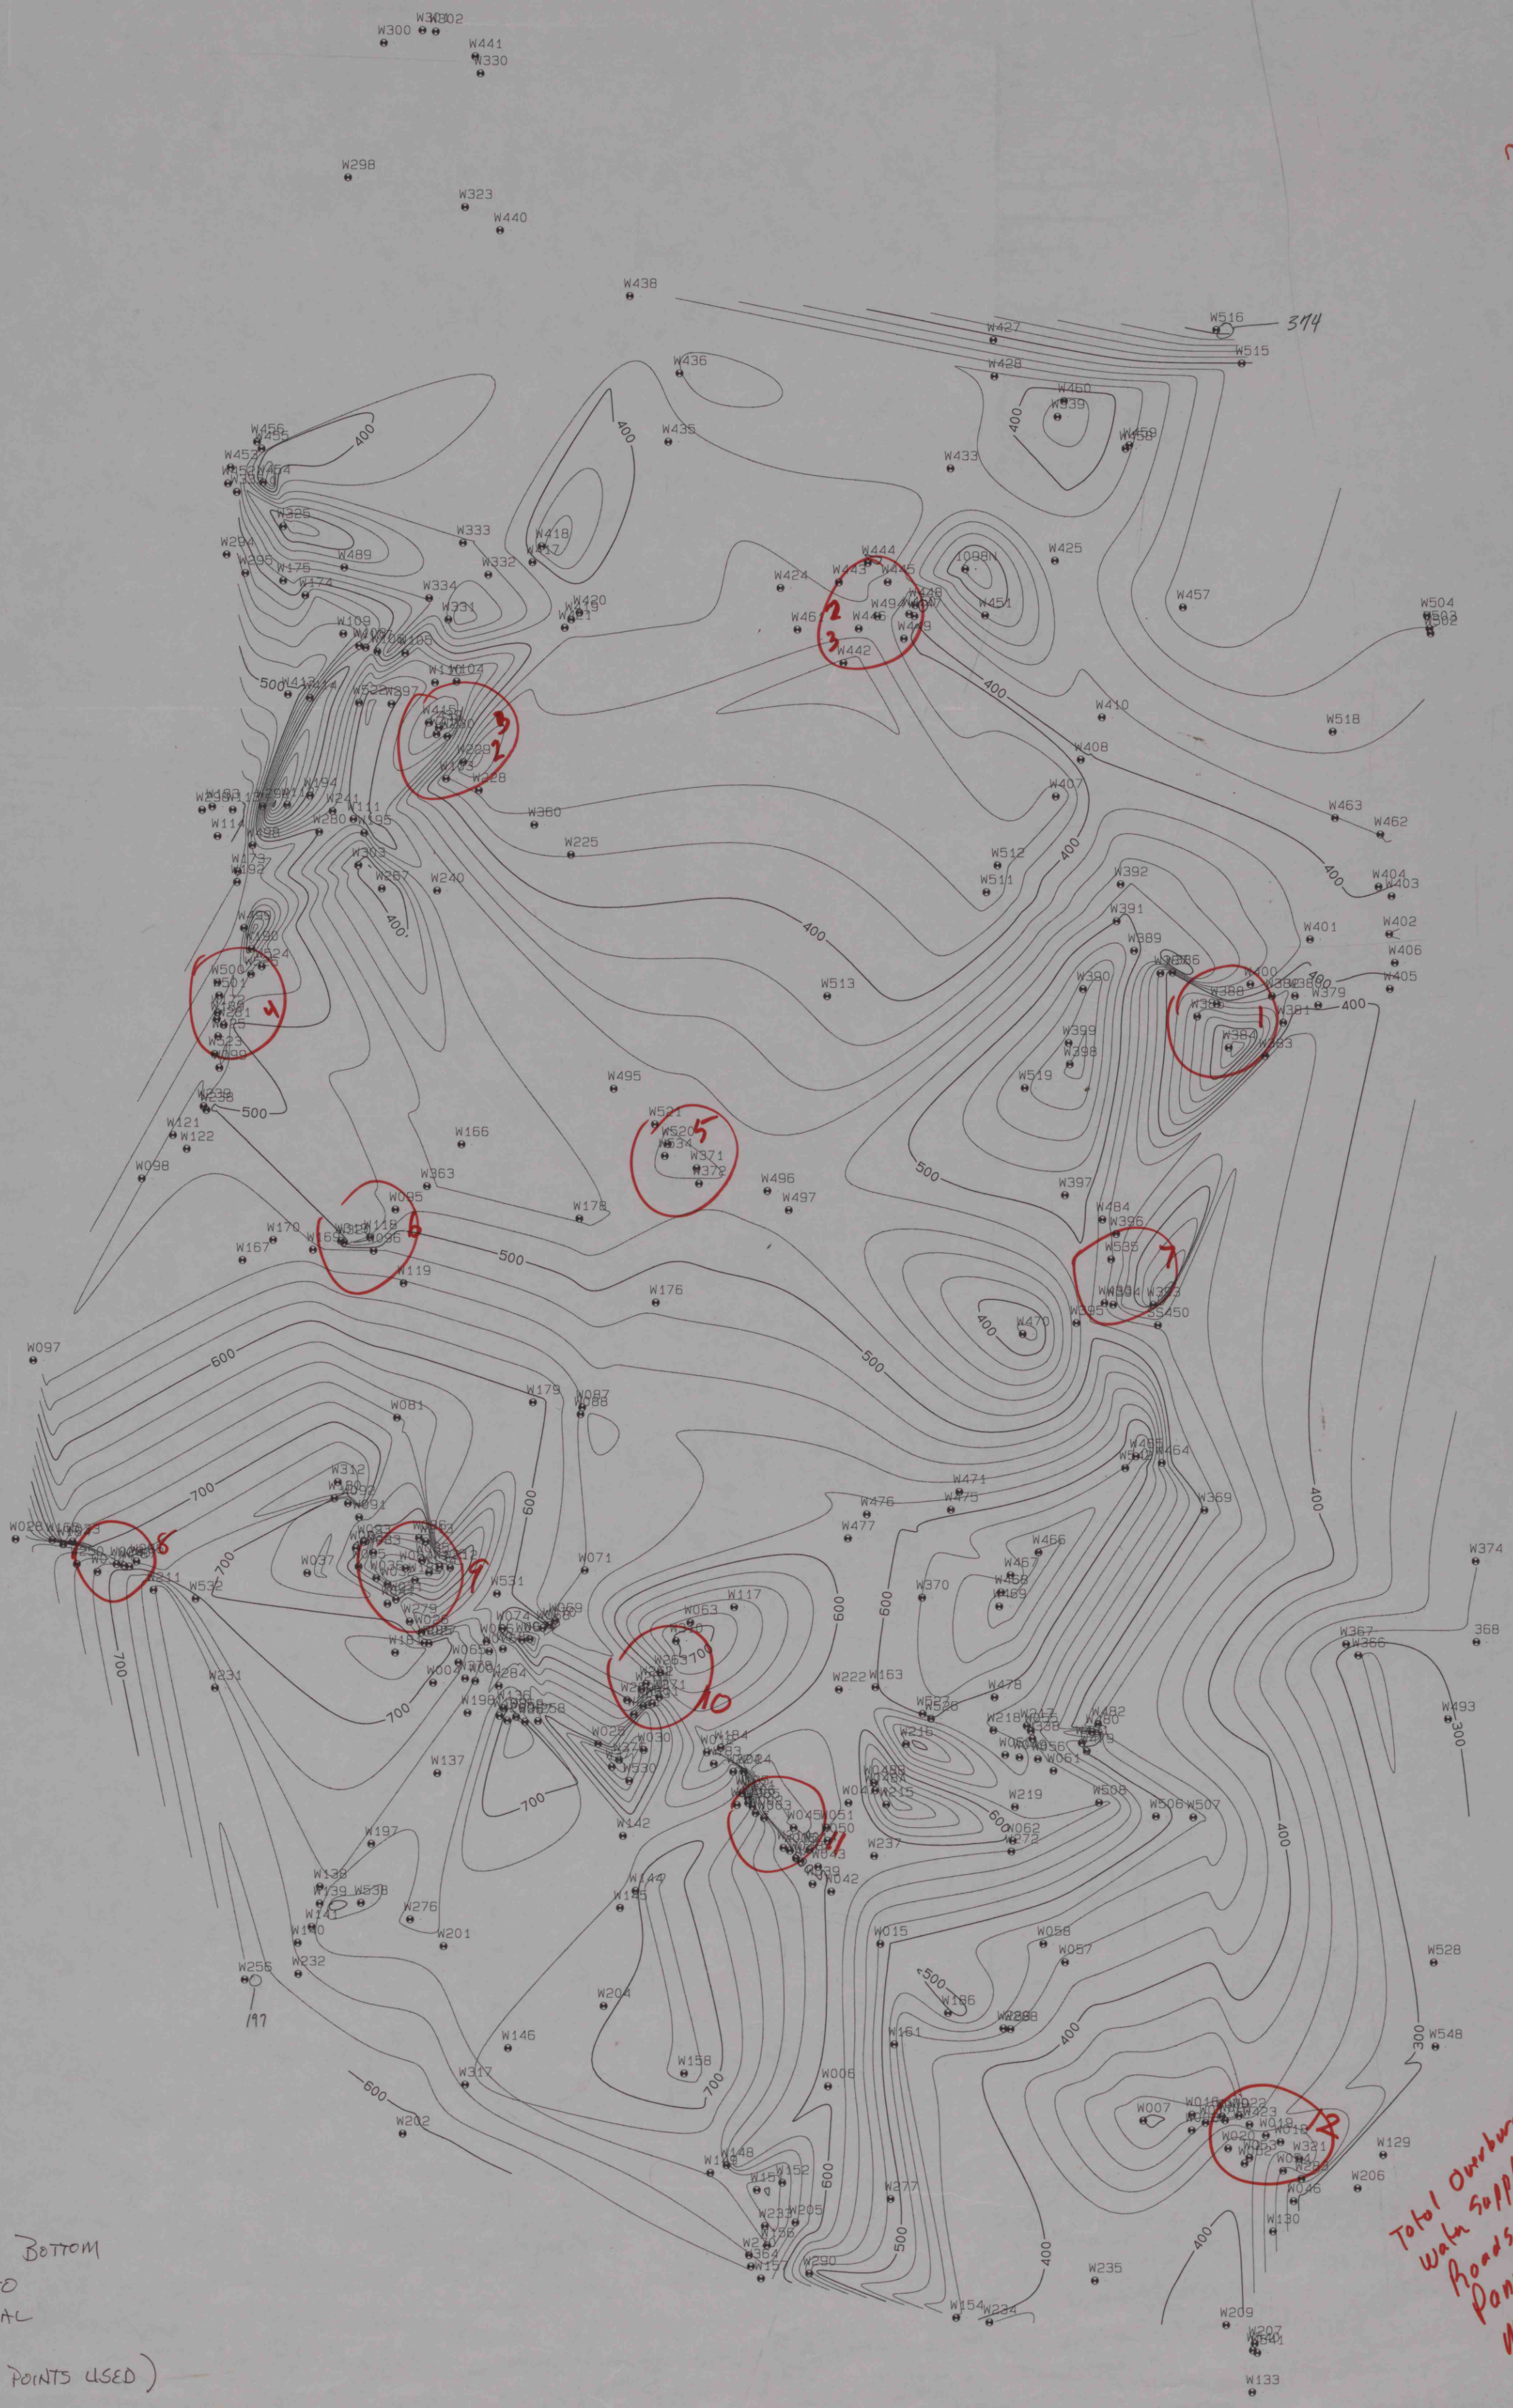

DISTANCE FROM BOTTOM
OF WELL TO
BOTTOM OF COAL
(NO PWS POINTS USED)

Total Overburden
Water Supplies
Roads
Pannals w/ Dates
Monitory Areas