


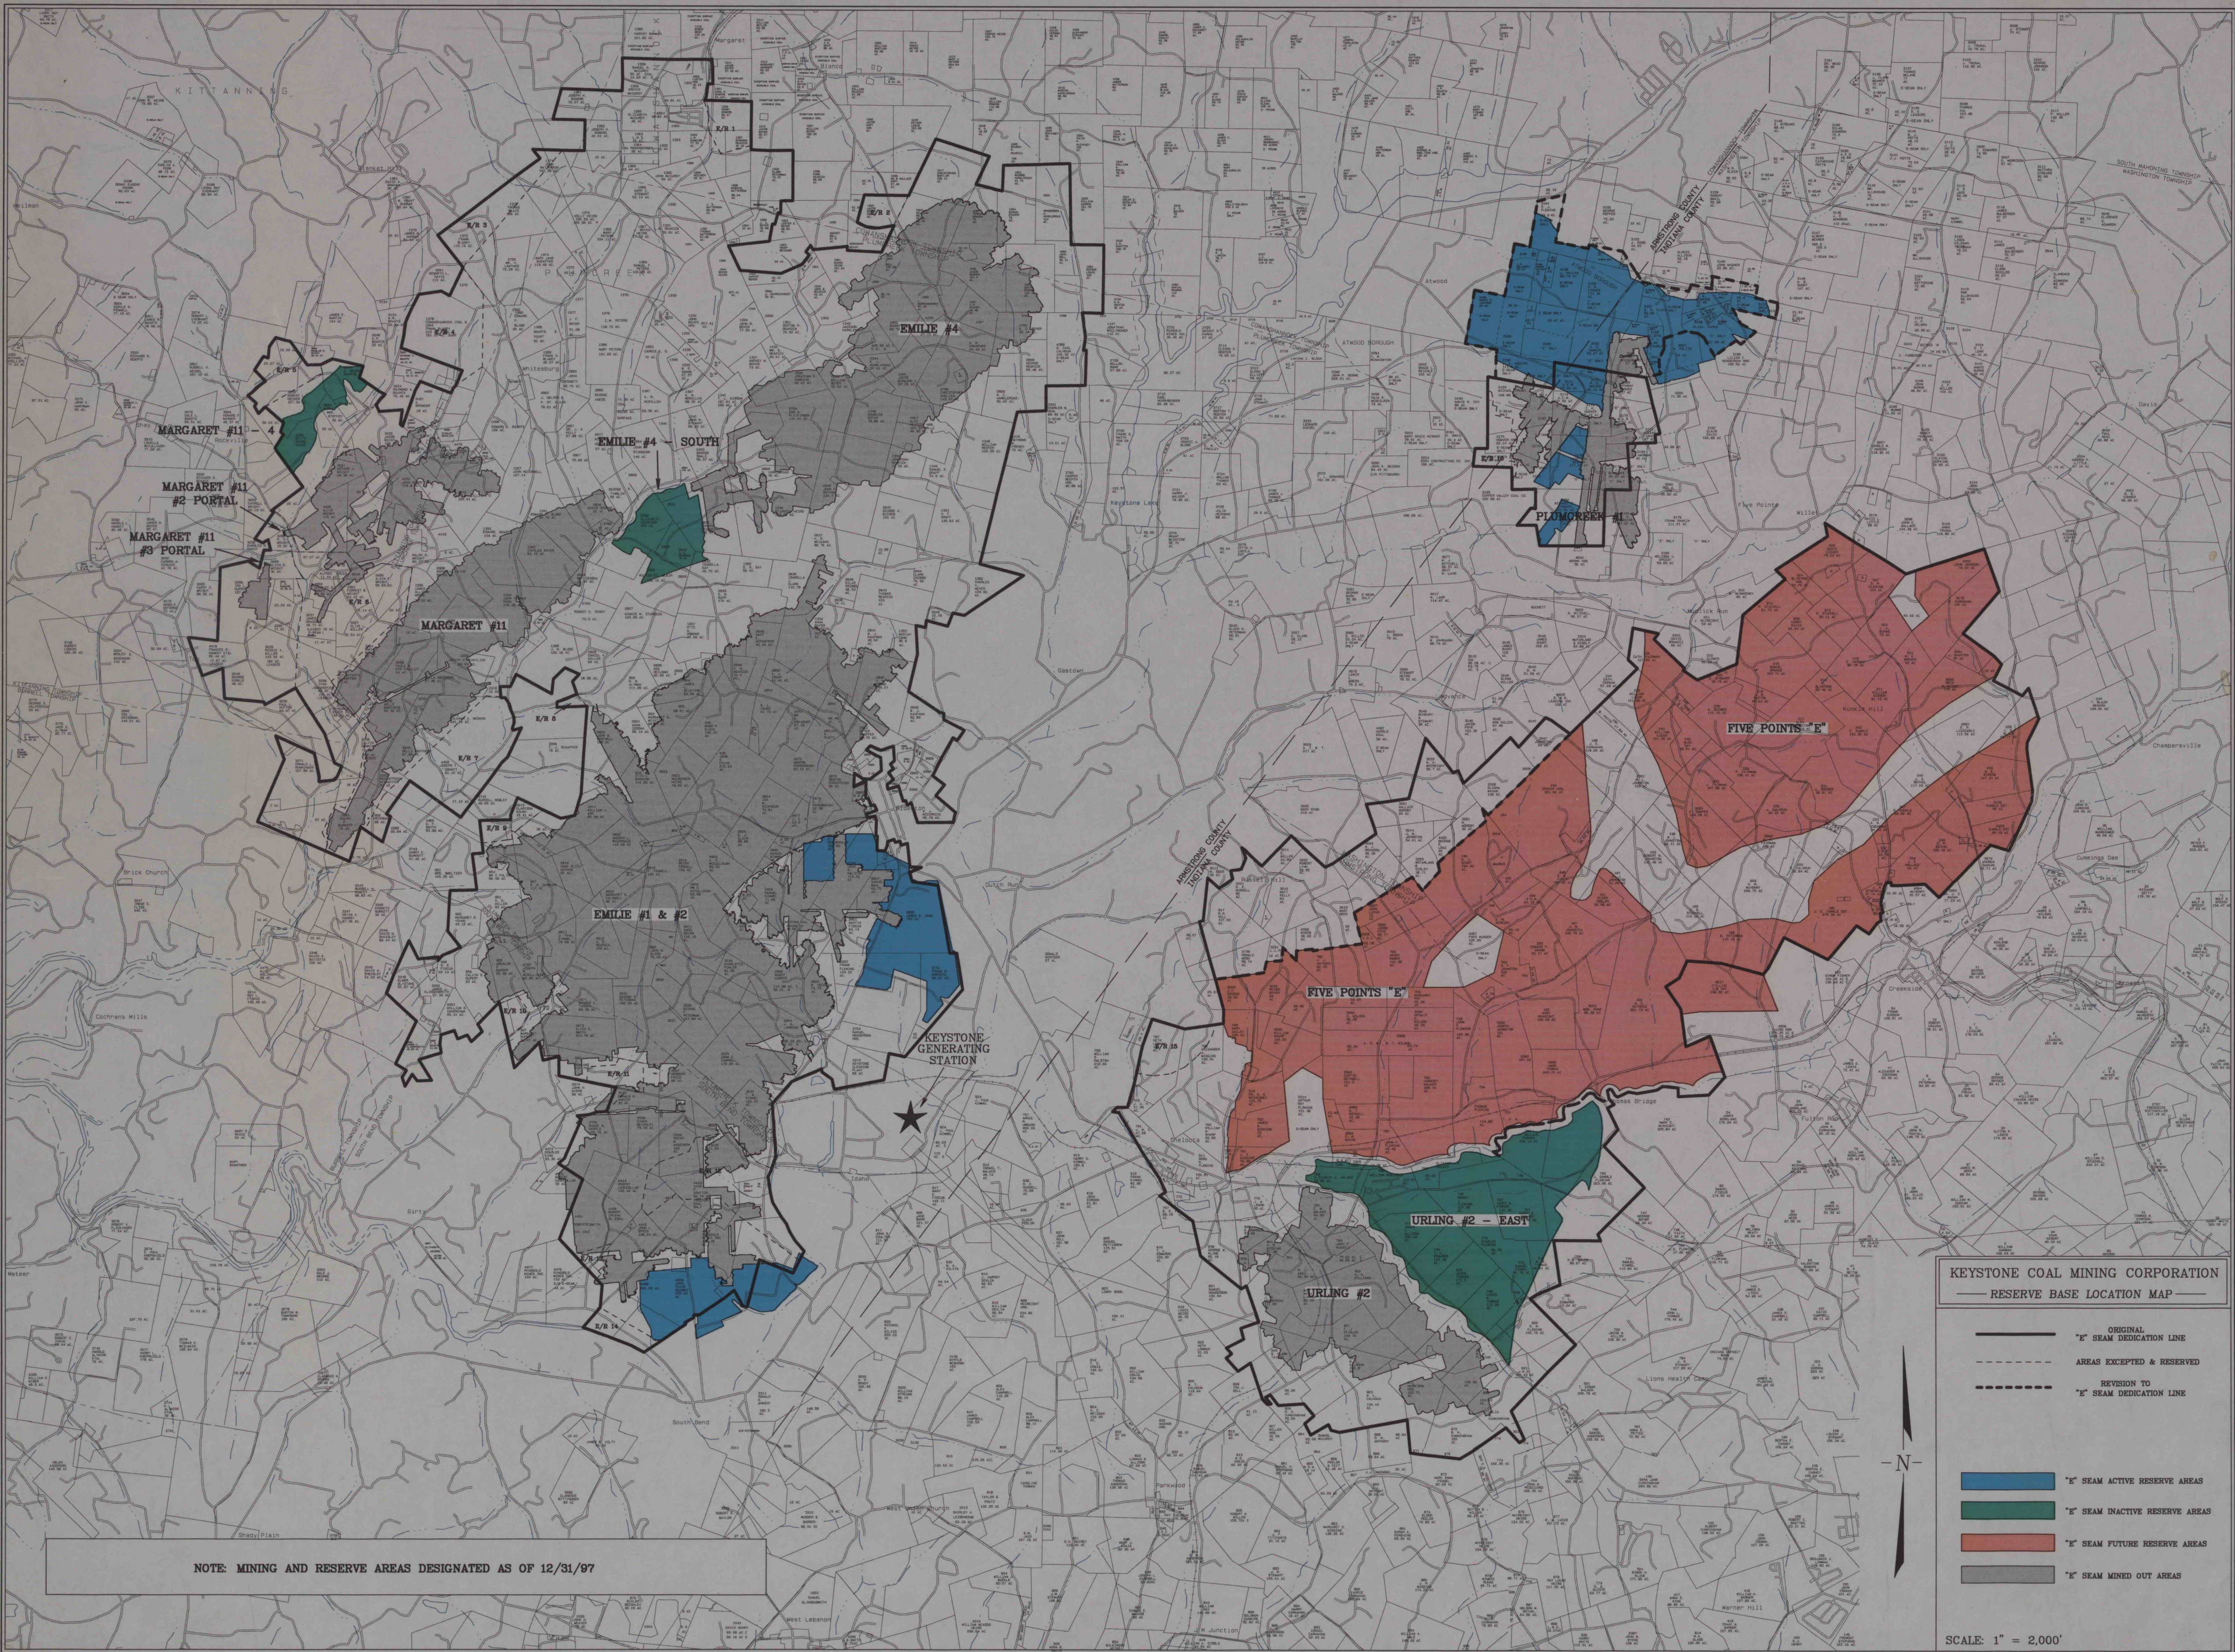

NOTE: MINING AND RESERVE AREAS DESIGNATED AS OF 12/31/97

KEYSTONE COAL MINING CORPORATION
RESERVE BASE LOCATION MAP

- ORIGINAL "E" SEAM DEDICATION LINE
- AREAS EXCEPTED & RESERVED
- REVISION TO "E" SEAM DEDICATION LINE

- "E" SEAM ACTIVE RESERVE AREAS
- "E" SEAM INACTIVE RESERVE AREAS
- "E" SEAM FUTURE RESERVE AREAS
- "E" SEAM MINED OUT AREAS

SCALE: 1" = 2,000'