


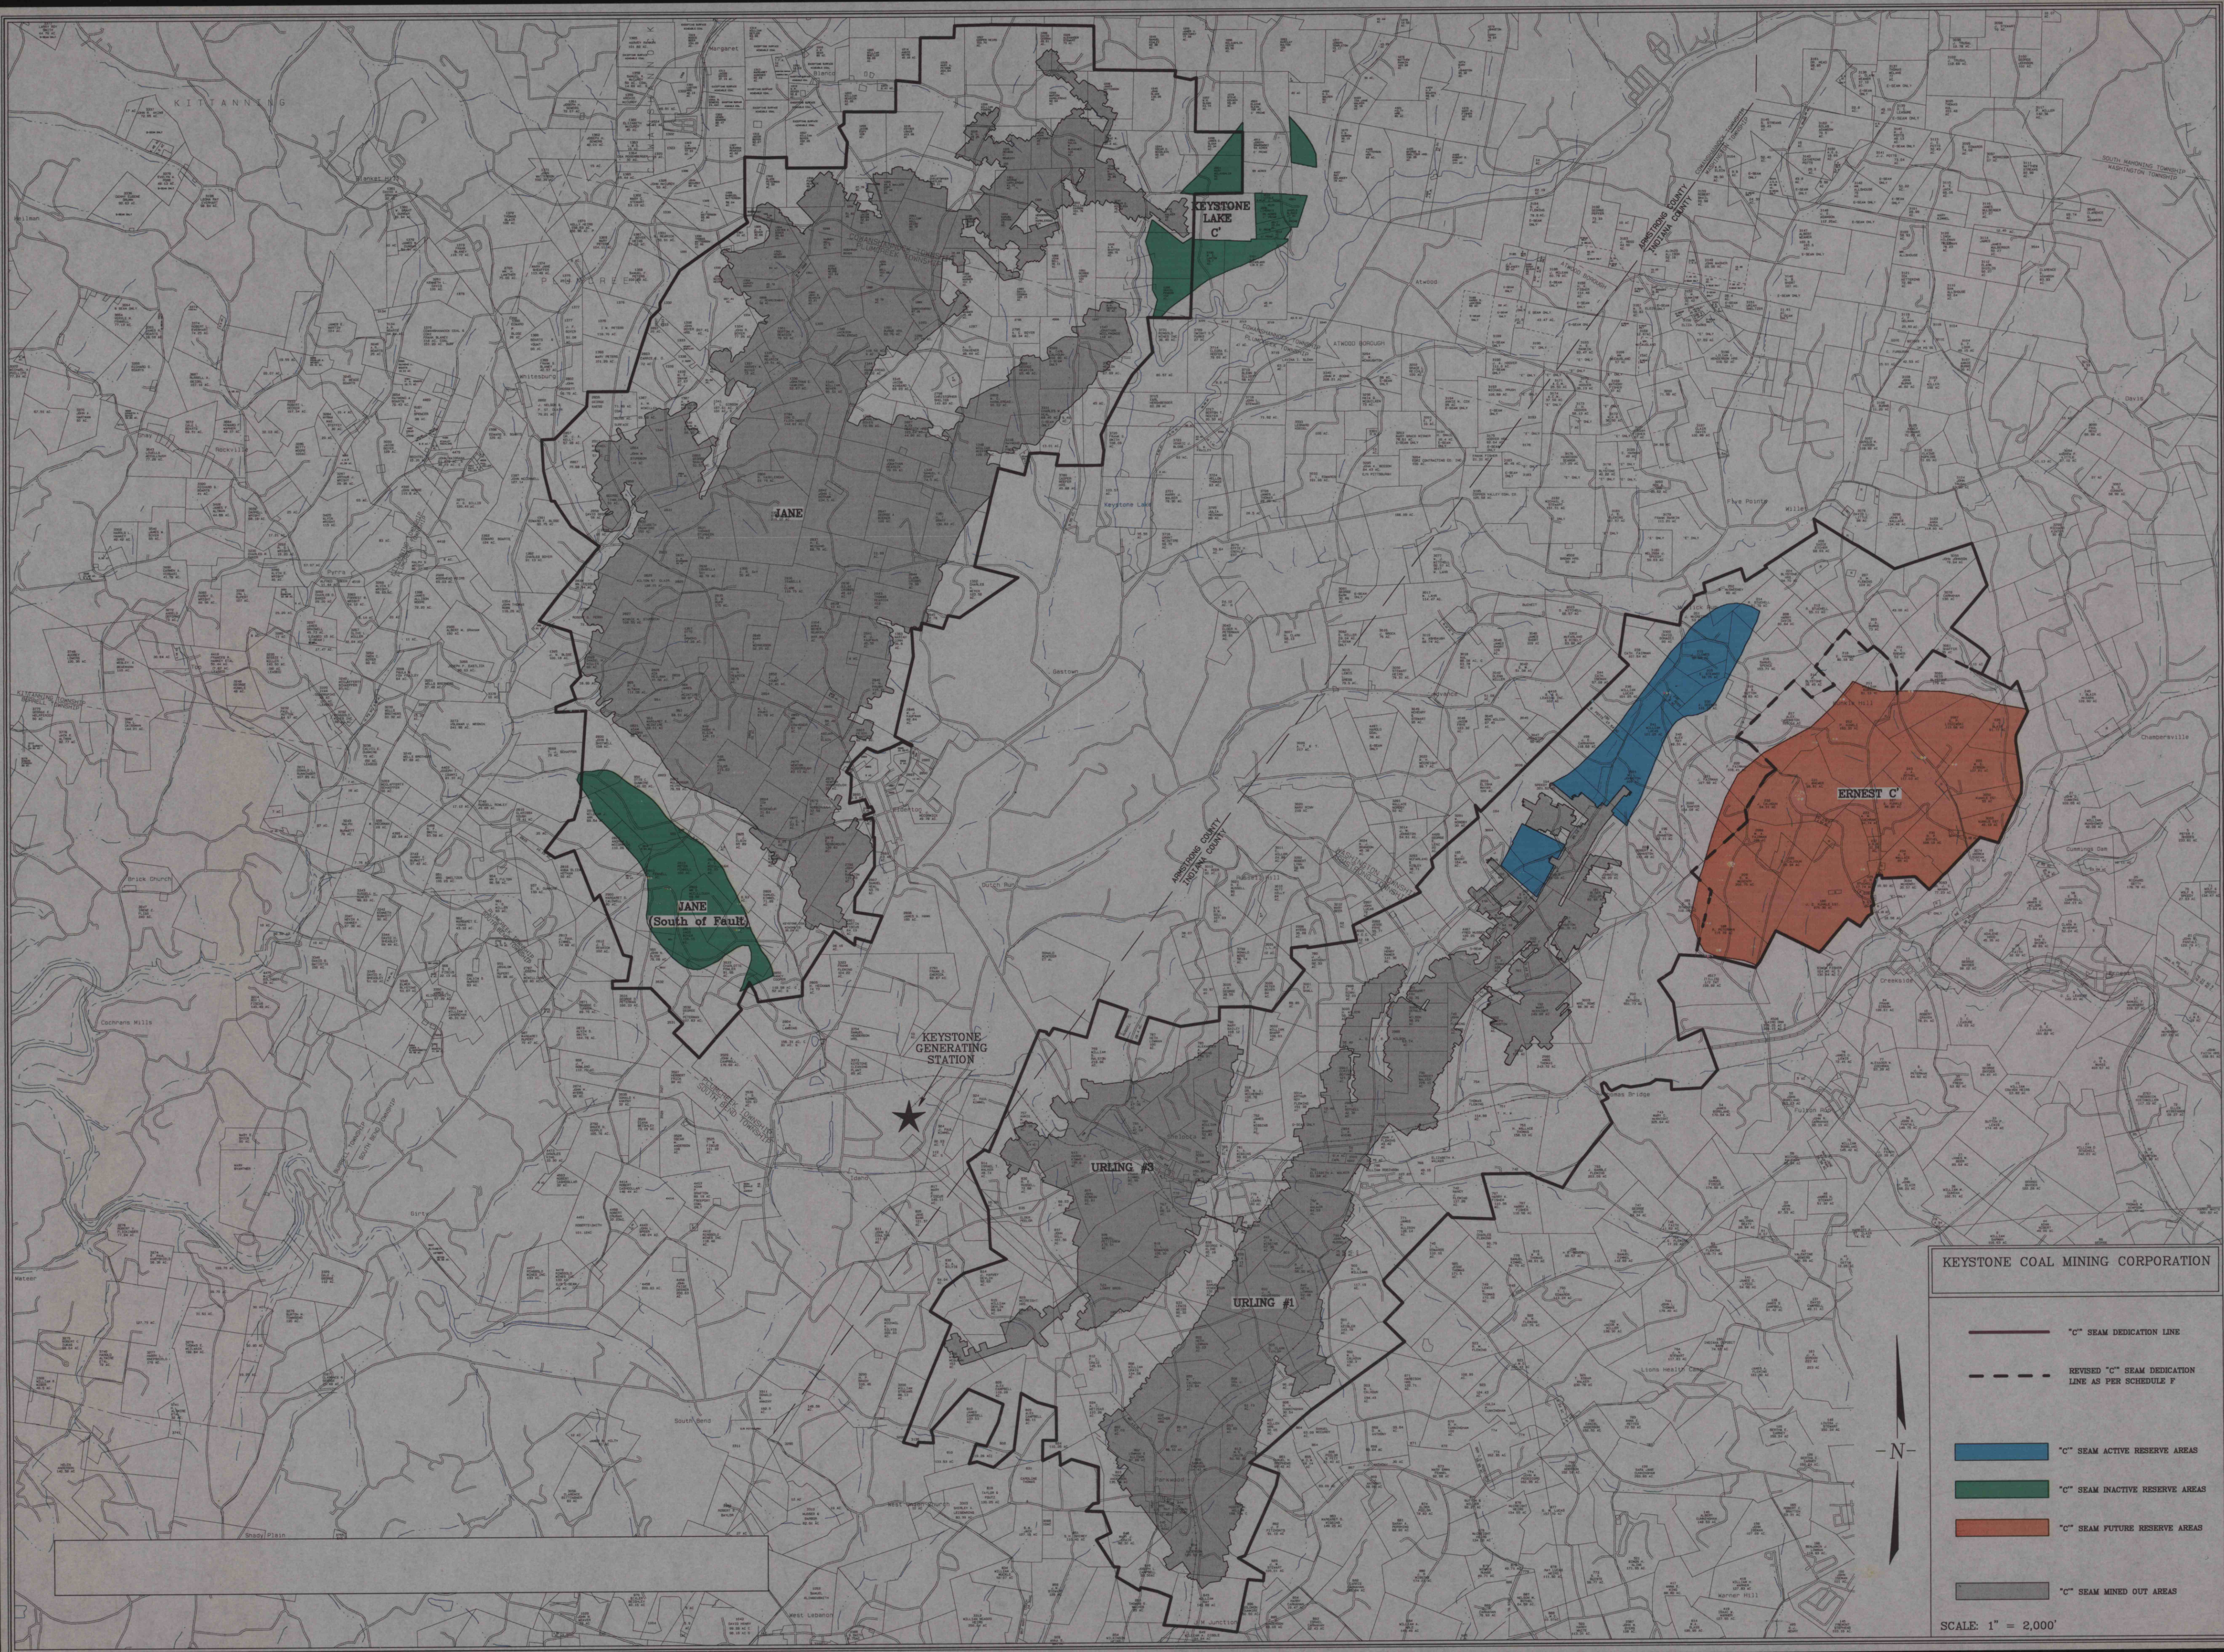

KEYSTONE COAL MINING CORPORATION

- "C" SEAM DEDICATION LINE
- - - REVISED "C" SEAM DEDICATION LINE AS PER SCHEDULE F
- "C" SEAM ACTIVE RESERVE AREAS
- "C" SEAM INACTIVE RESERVE AREAS
- "C" SEAM FUTURE RESERVE AREAS
- "C" SEAM MINED OUT AREAS

SCALE: 1" = 2,000'