

# Rochester & Pittsburgh Coal Company


## AVONMORE

RAW (R.O.M.) ASH % (MINEABLE SEAM)

FILE COPY  
RETURN

FILE COPY  
RETURN

FILE COPY  
RETURN

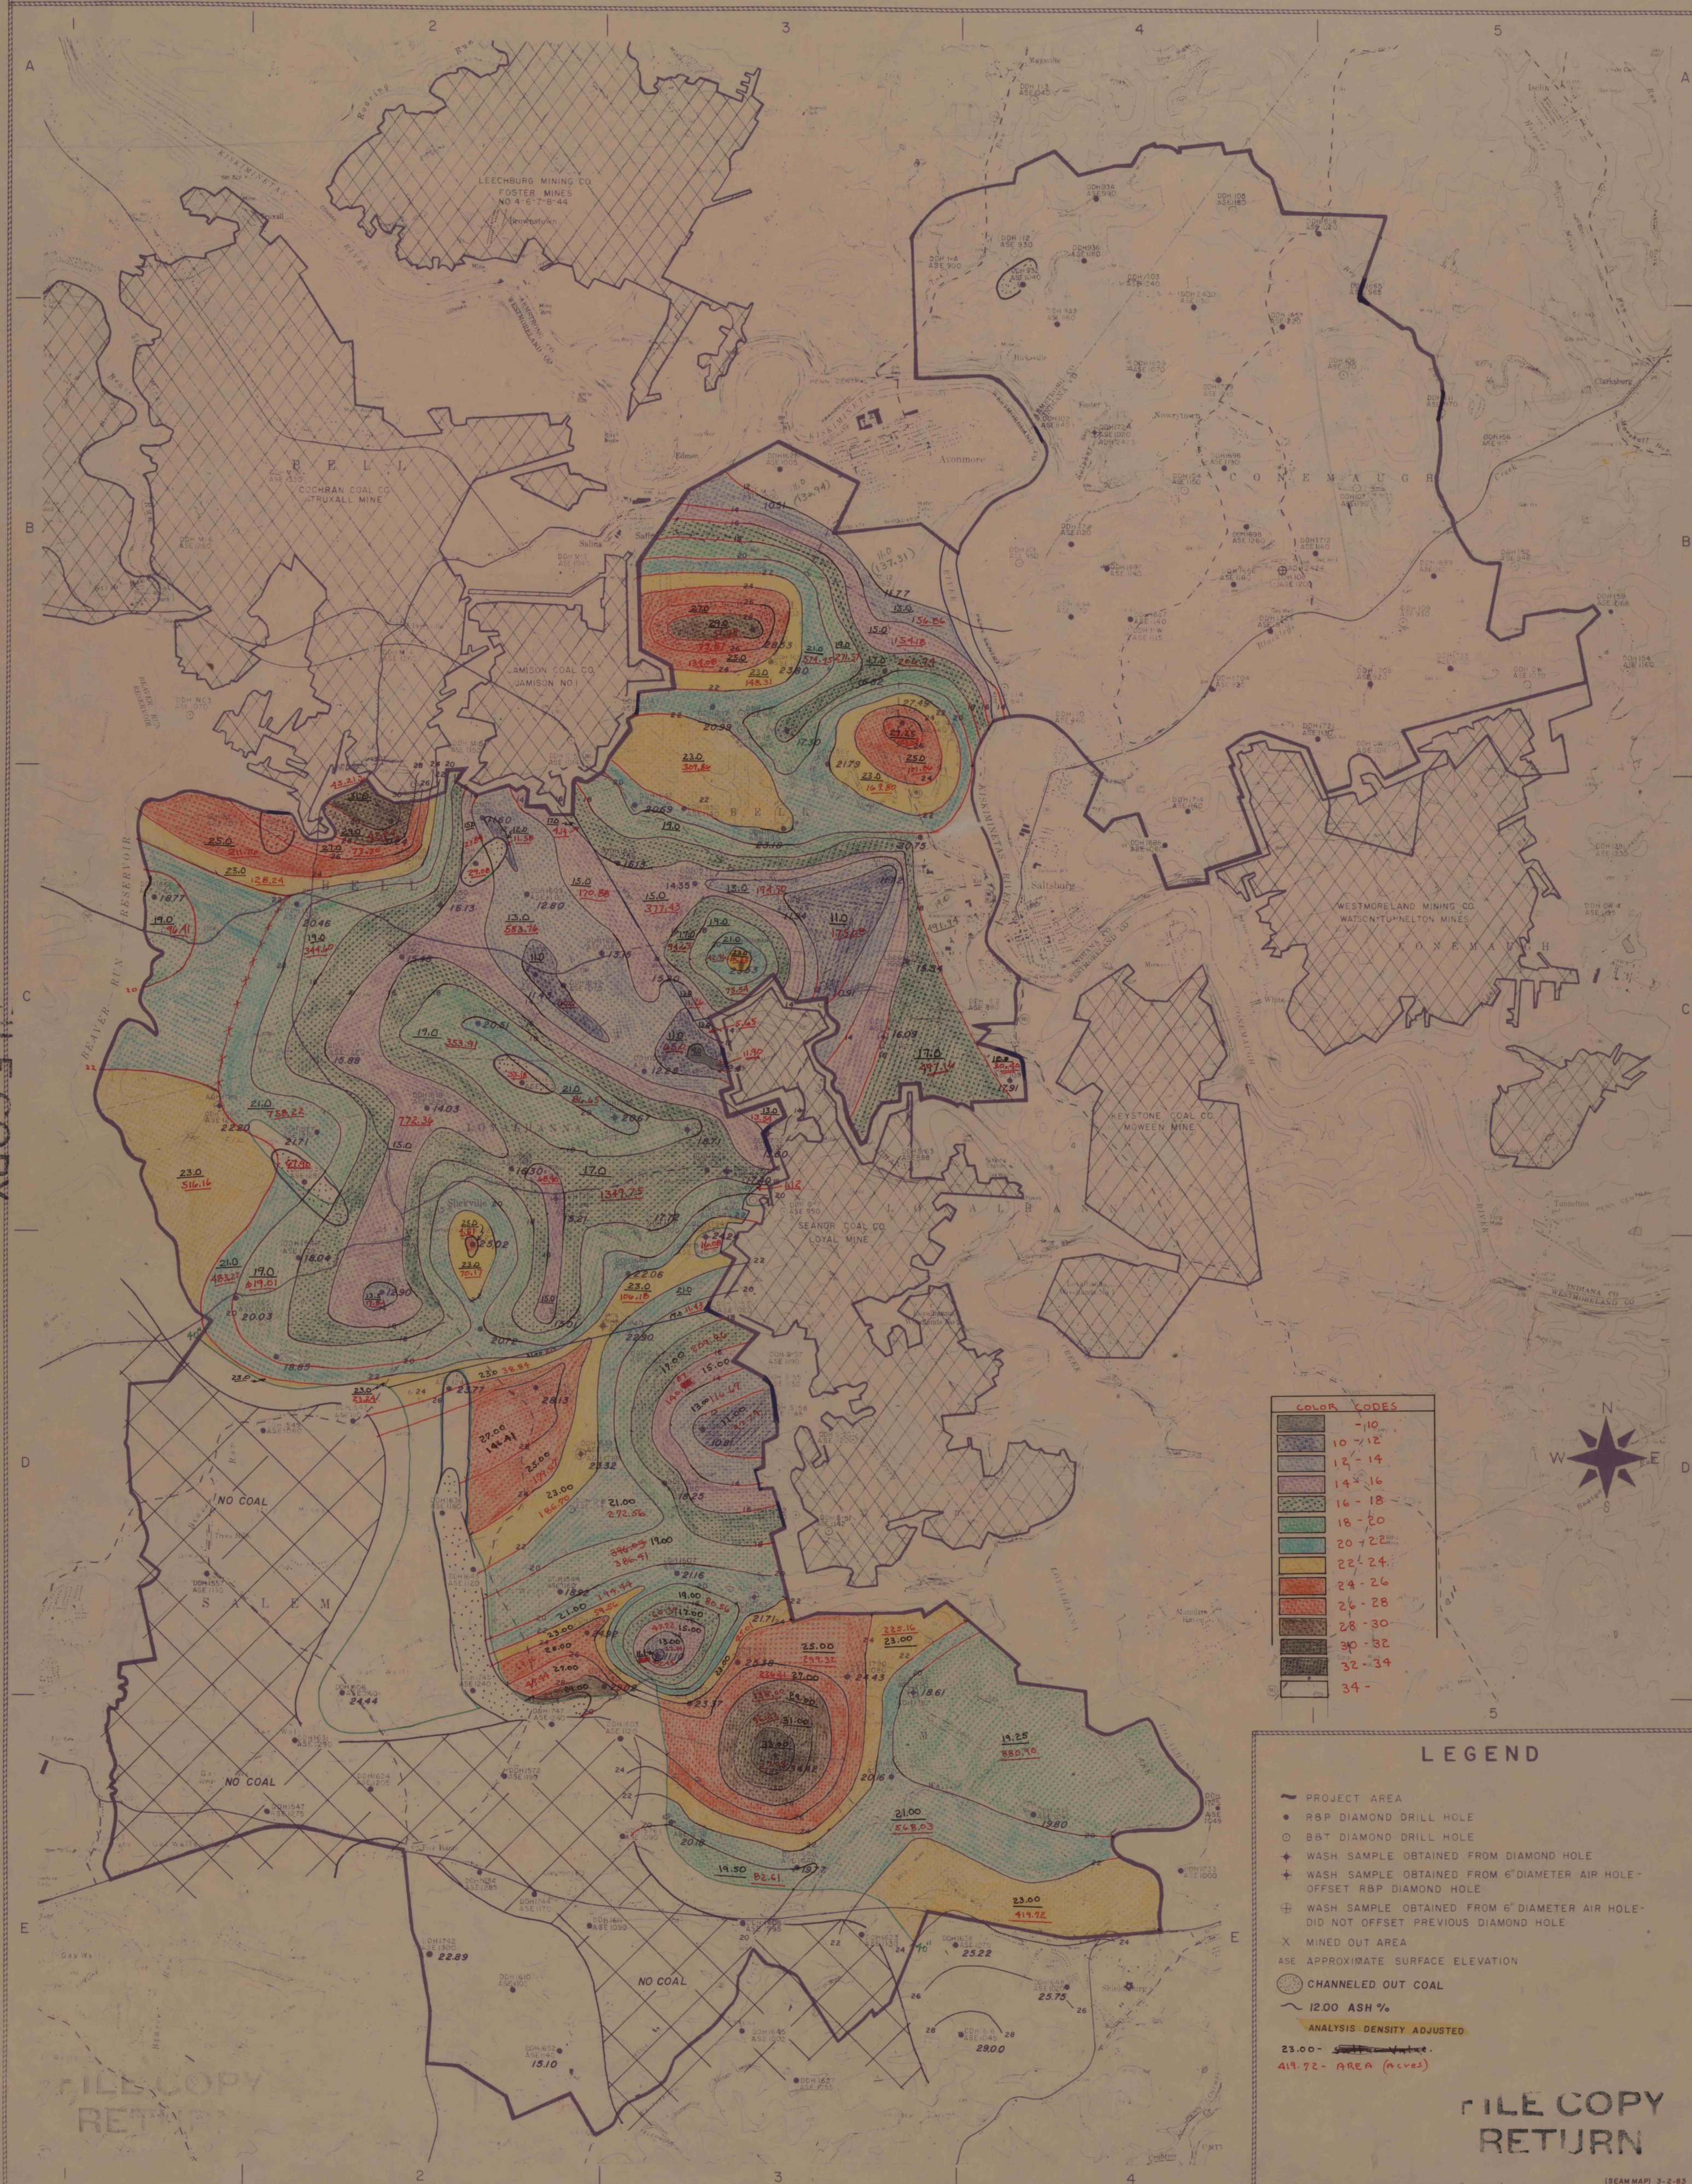

| COLOR CODES |       |
|-------------|-------|
| [Color]     | 10-12 |
| [Color]     | 12-14 |
| [Color]     | 14-16 |
| [Color]     | 16-18 |
| [Color]     | 18-20 |
| [Color]     | 20-22 |
| [Color]     | 22-24 |
| [Color]     | 24-26 |
| [Color]     | 26-28 |
| [Color]     | 28-30 |
| [Color]     | 30-32 |
| [Color]     | 32-34 |
| [Color]     | 34-   |

### LEGEND

- PROJECT AREA
- R&P DIAMOND DRILL HOLE
- B&T DIAMOND DRILL HOLE
- WASH SAMPLE OBTAINED FROM DIAMOND HOLE
- WASH SAMPLE OBTAINED FROM 6" DIAMETER AIR HOLE - OFFSET R&P DIAMOND HOLE
- WASH SAMPLE OBTAINED FROM 6" DIAMETER AIR HOLE - DID NOT OFFSET PREVIOUS DIAMOND HOLE
- X MINED OUT AREA
- ASE APPROXIMATE SURFACE ELEVATION
- CHANNELED OUT COAL
- 12.00 ASH %
- ANALYSIS DENSITY ADJUSTED
- 23.00 - AREA (acres)
- 419.72 - AREA (acres)

FILE COPY  
RETURN