
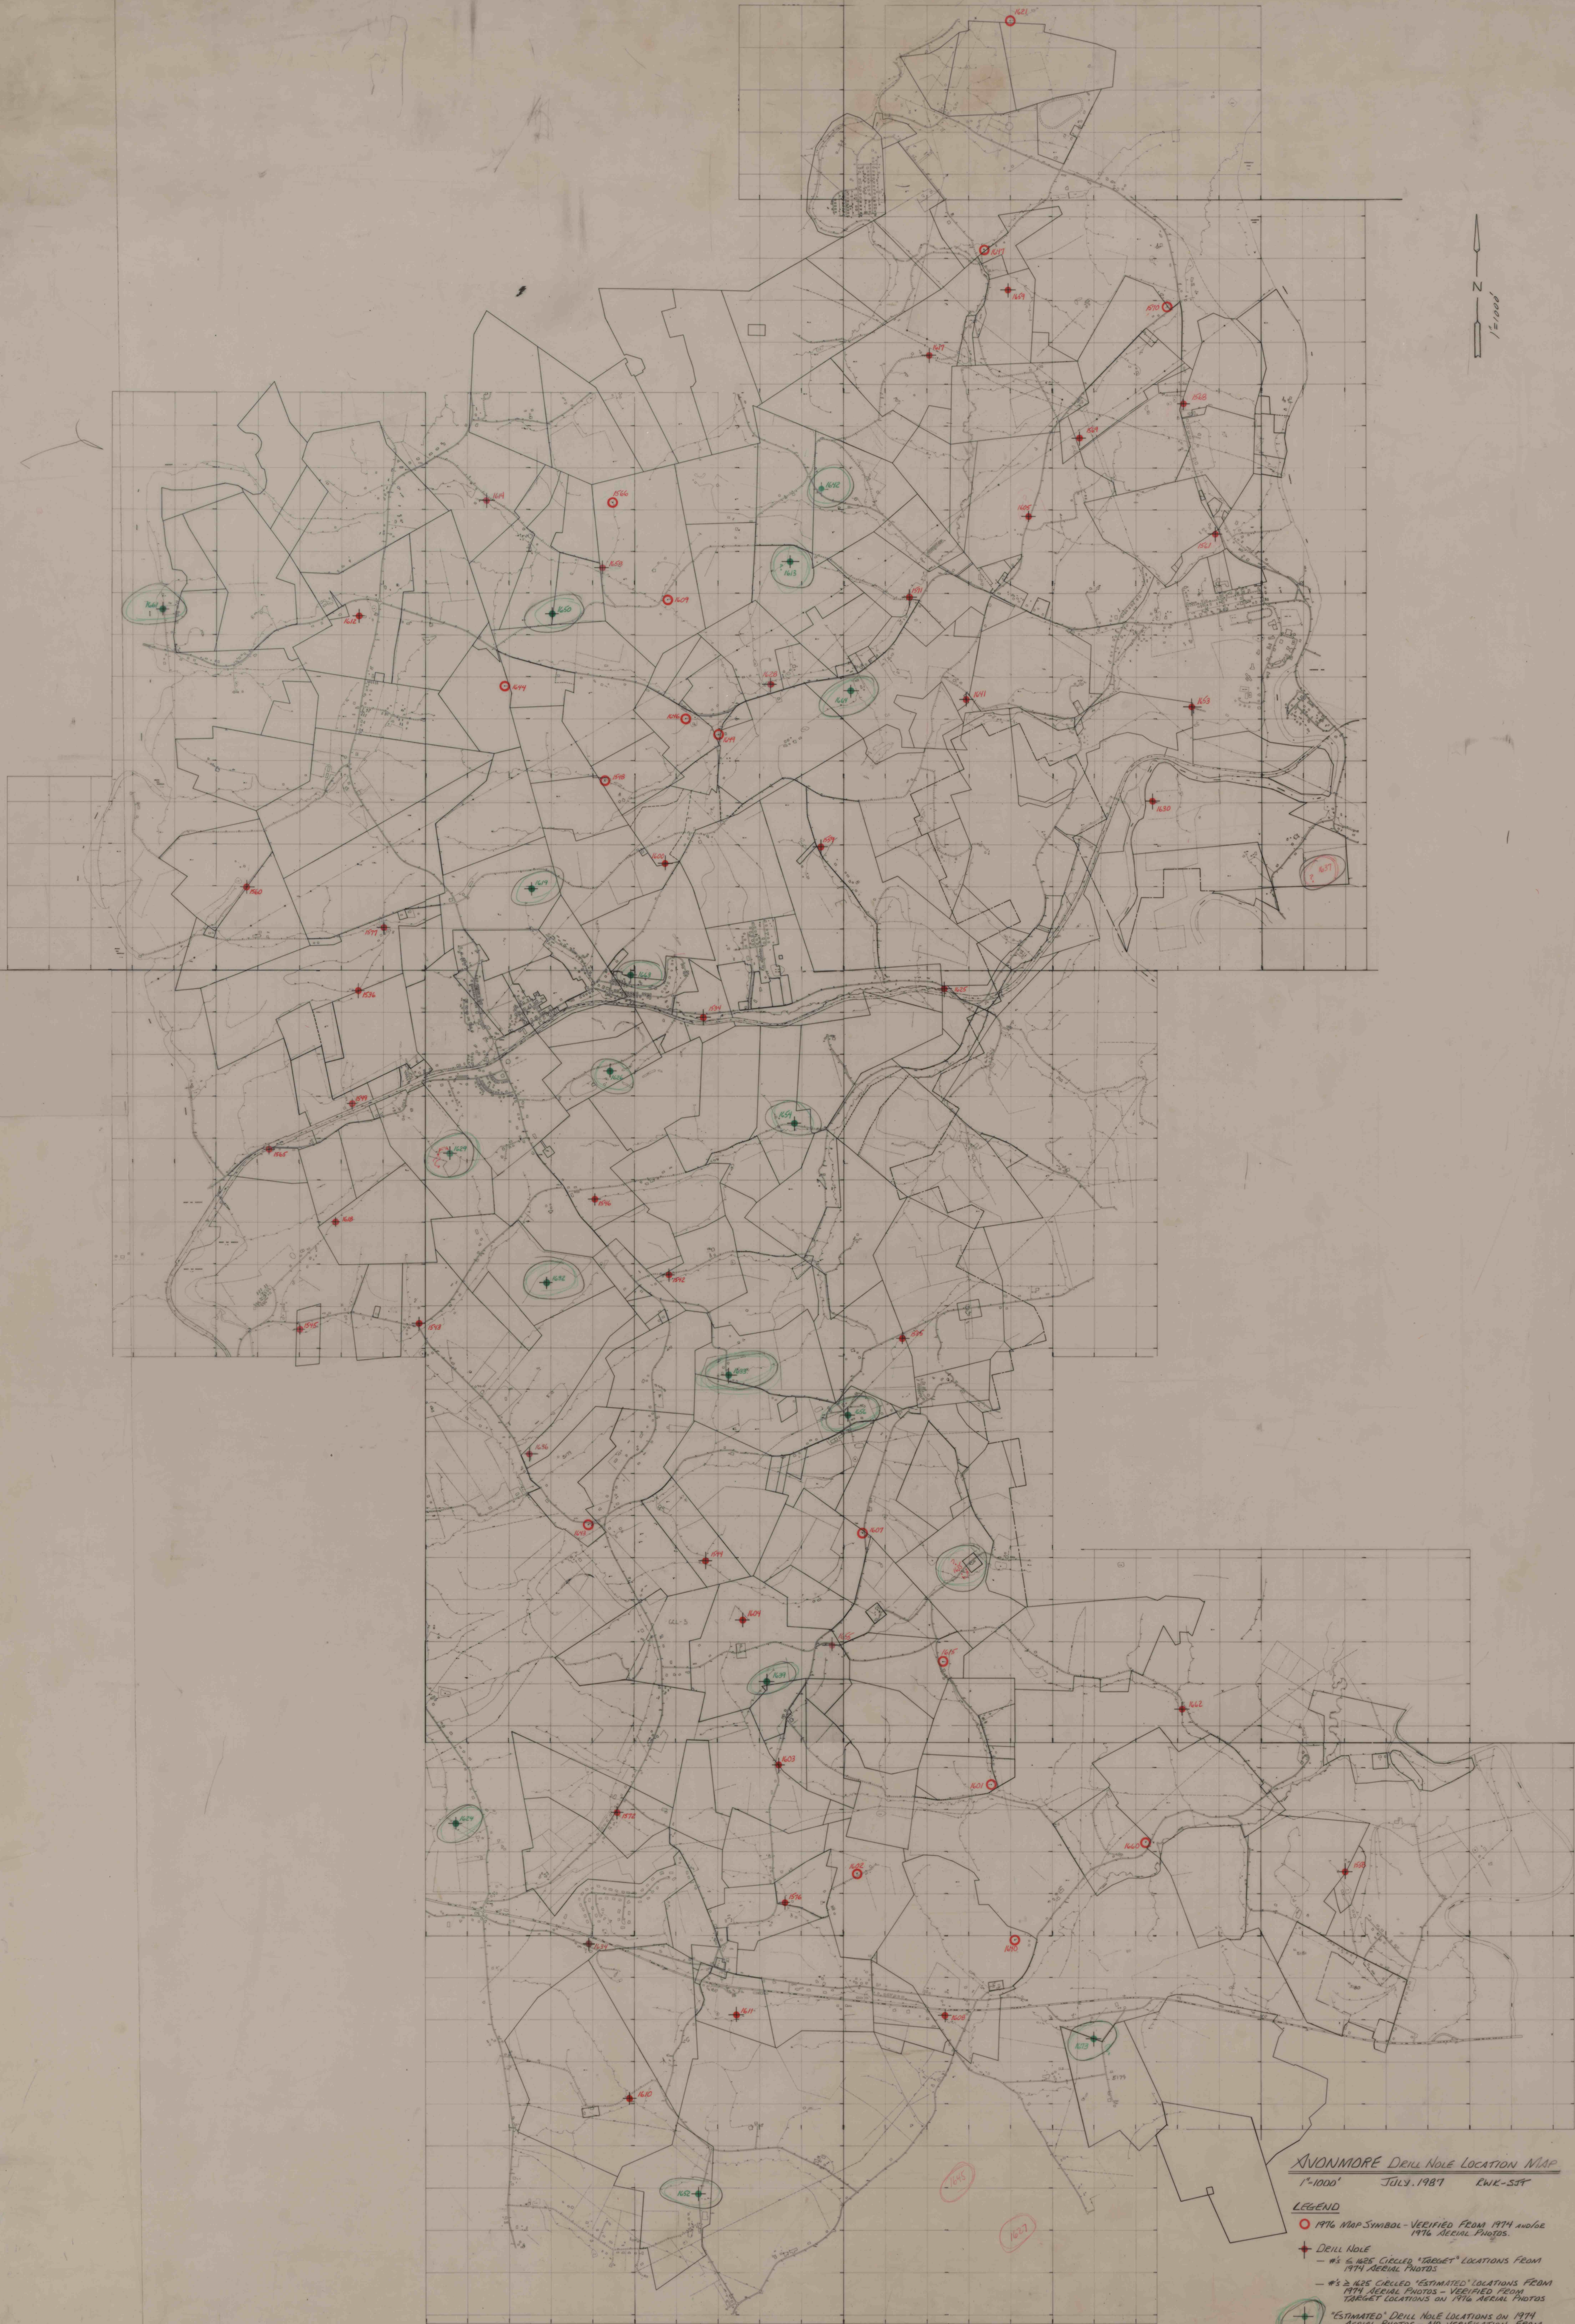


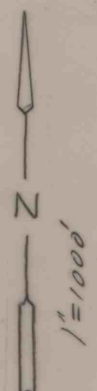

XIVONMORE DRILL HOLE LOCATION MAP
1"=1000' JULY, 1987 EWE-SFF

- LEGEND
- 1976 MAP SYMBOL - VERIFIED FROM 1974 AND/OR 1976 AERIAL PHOTOS.
 - DRILL HOLE
 - #1 & #25 CIRCLED "TARGET" LOCATIONS FROM 1974 AERIAL PHOTOS
 - #3 & #25 CIRCLED "ESTIMATED" LOCATIONS FROM 1974 AERIAL PHOTOS - VERIFIED FROM TARGET LOCATIONS ON 1976 AERIAL PHOTOS
 - "ESTIMATED" DRILL HOLE LOCATIONS ON 1974 AERIAL PHOTOS - NO VERIFICATION FROM ANY OTHER SOURCE
 - *DO NOT USE FOR DRILL HOLE DATA BASE*