


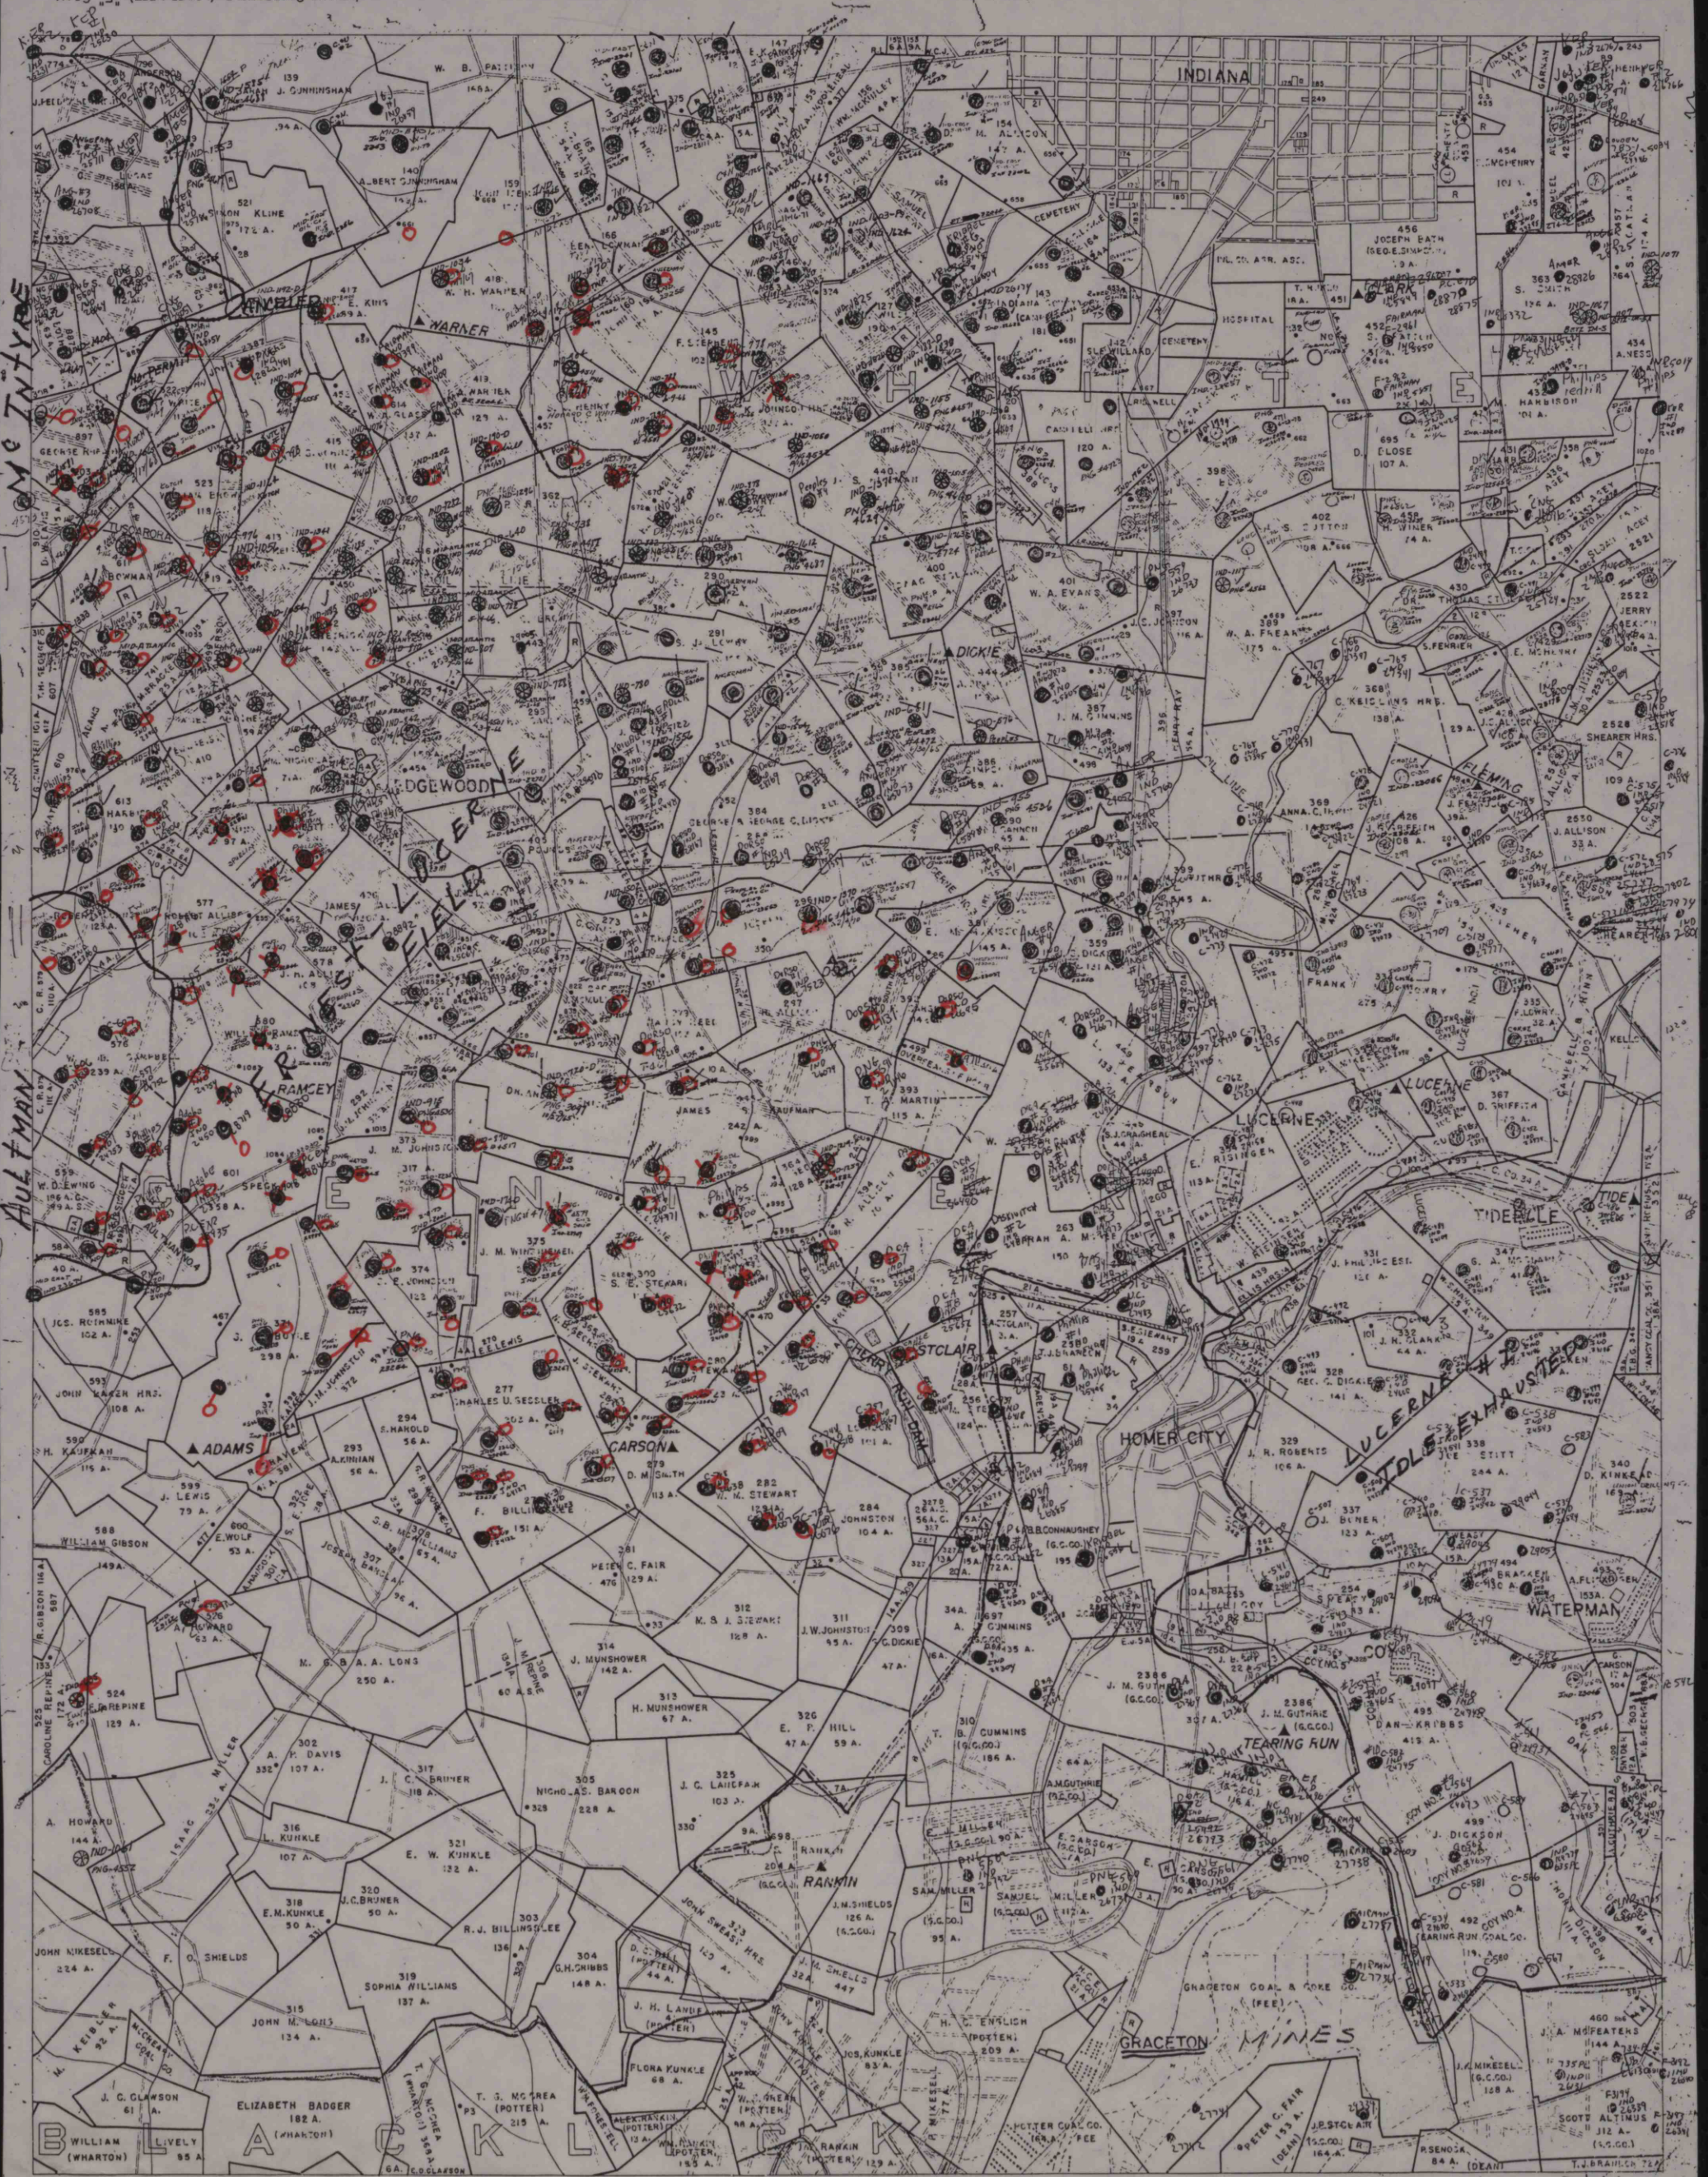

LAND DEPT. GAS WELL MAP

1/4" = 2000'