


5-573



C-5

UPPER FREEPORT COAL SEAM

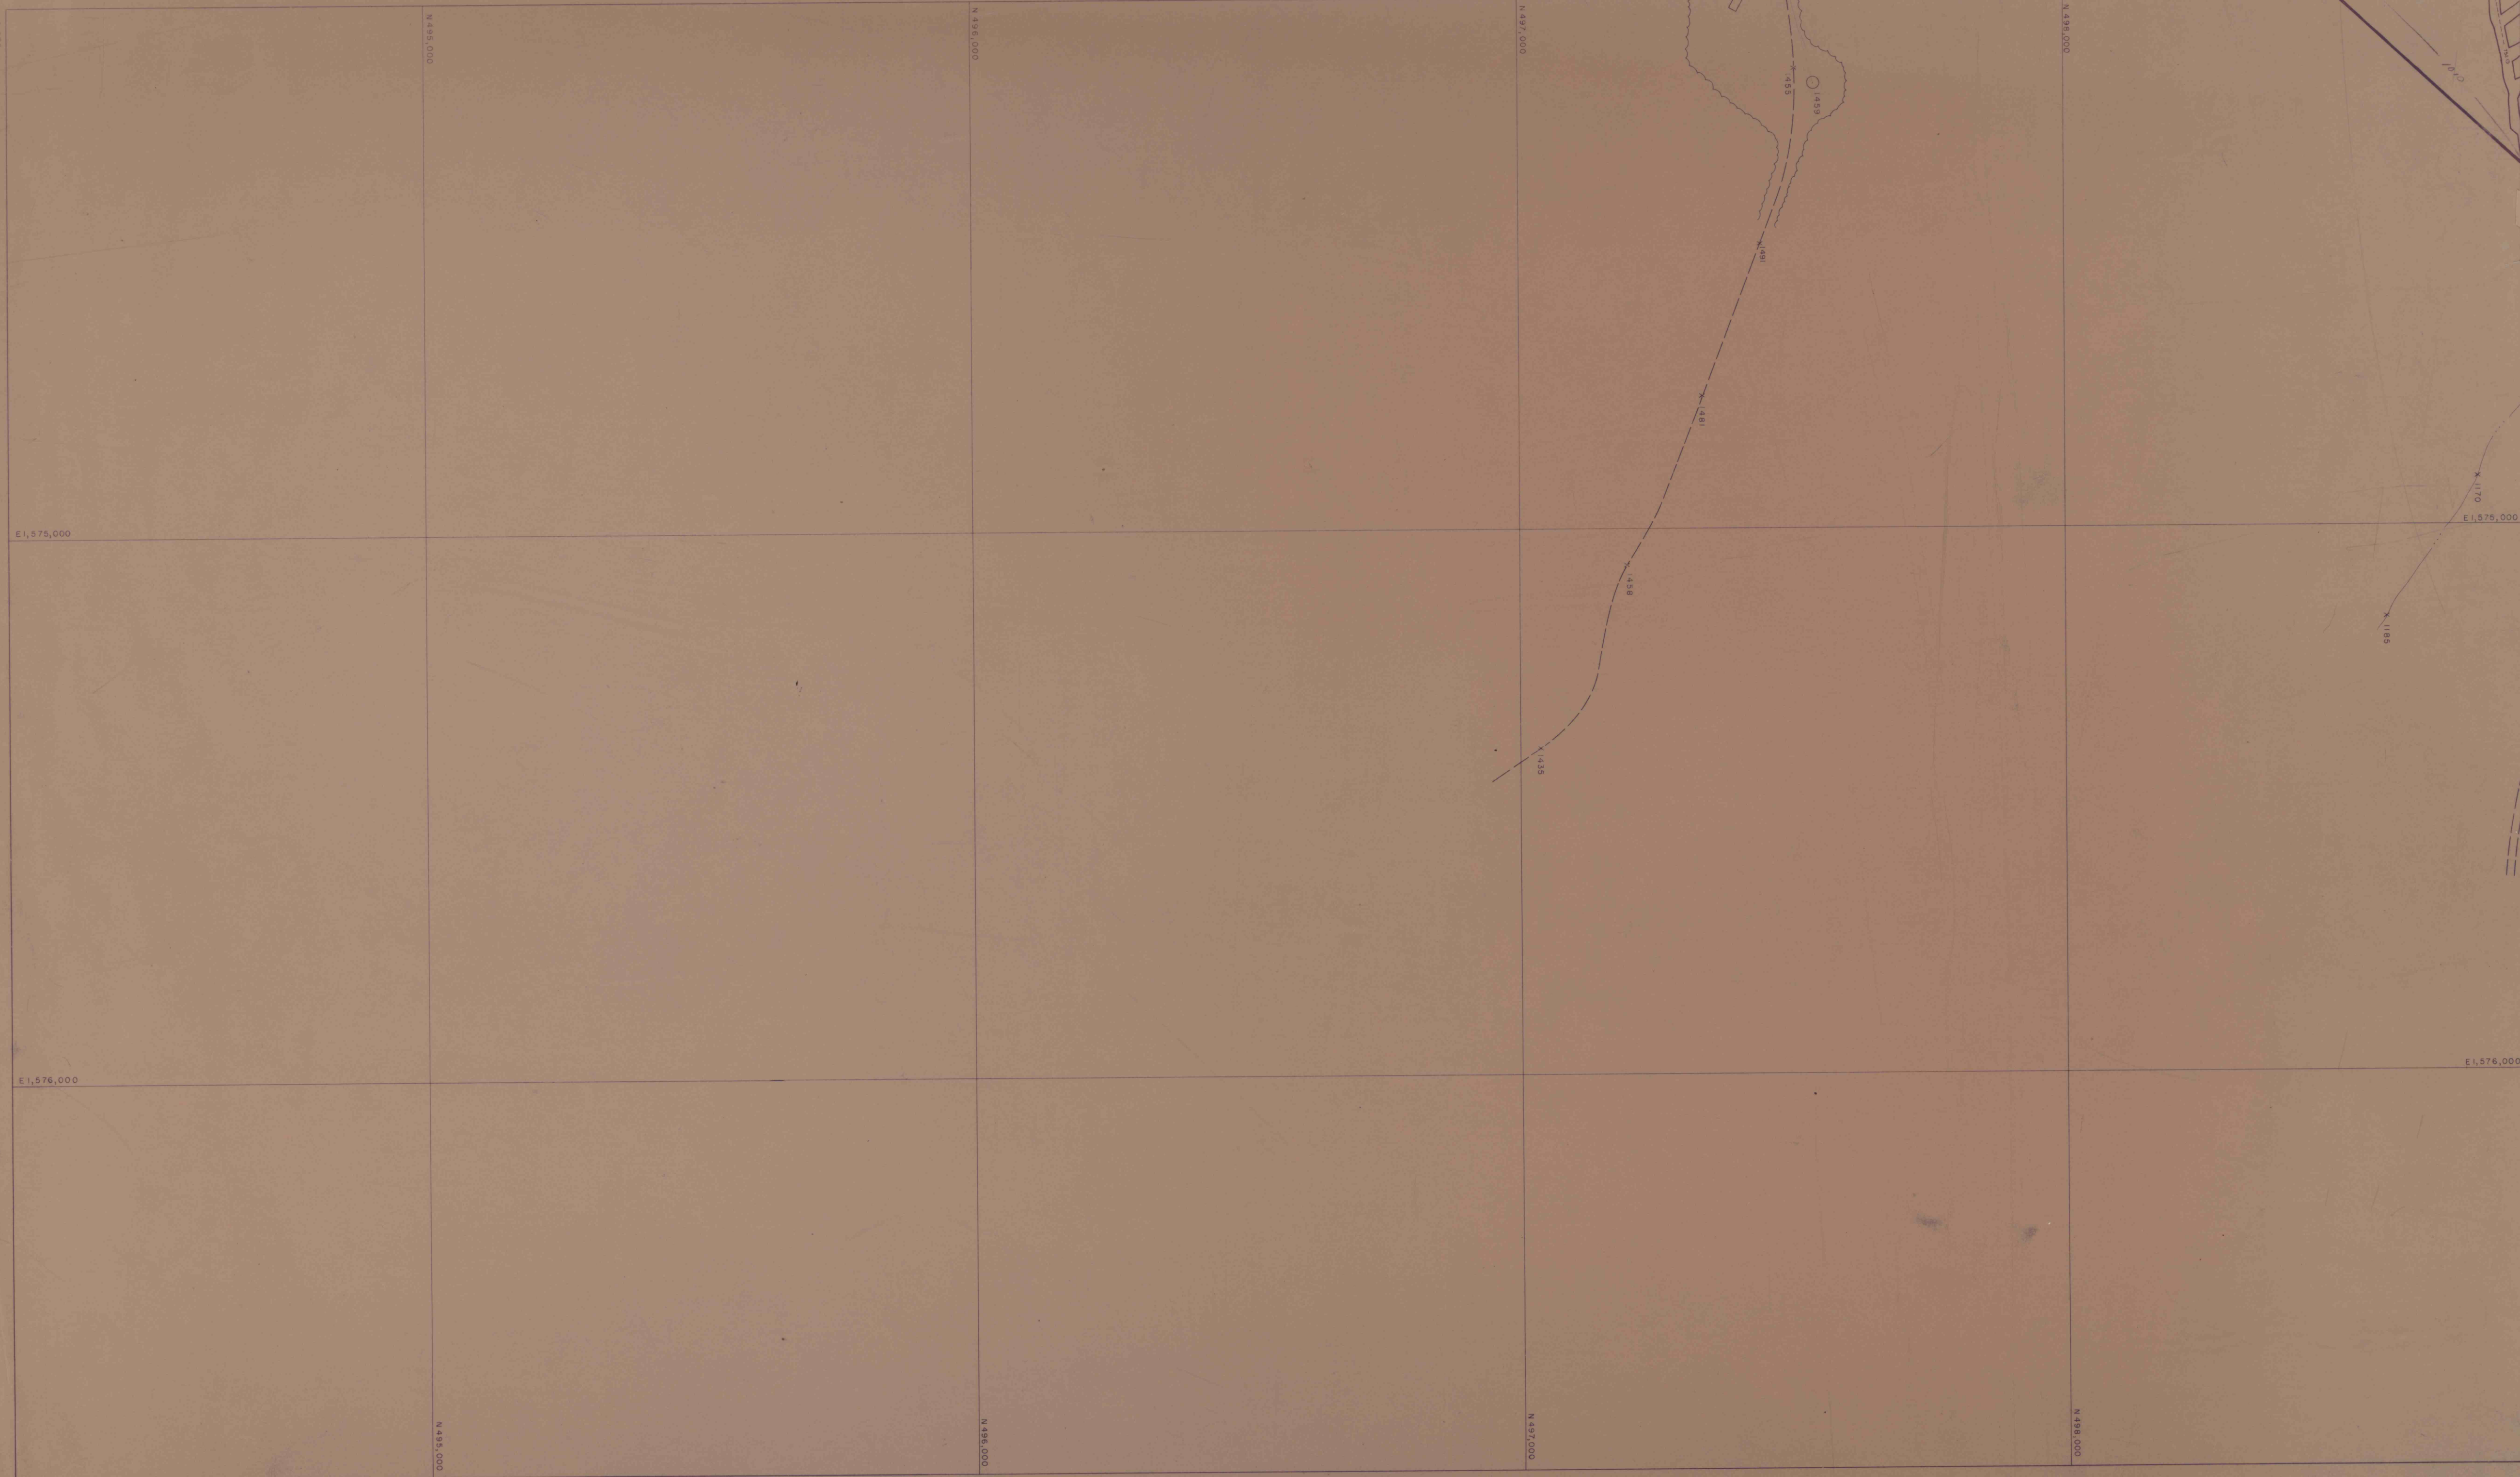

DARMAC NO. 2 MINE
PLUMCREEK AND ARMSTRONG TWPS.
ARMSTRONG AND INDIANA COS.
SCALE : 1" = 100'

DARMAC ASSOCIATES CORPORATION
PROJECTION NO : 5
MINING PERIOD : 12-1-91 TO 6-1-92
POSTING DATE : 12-1-91