


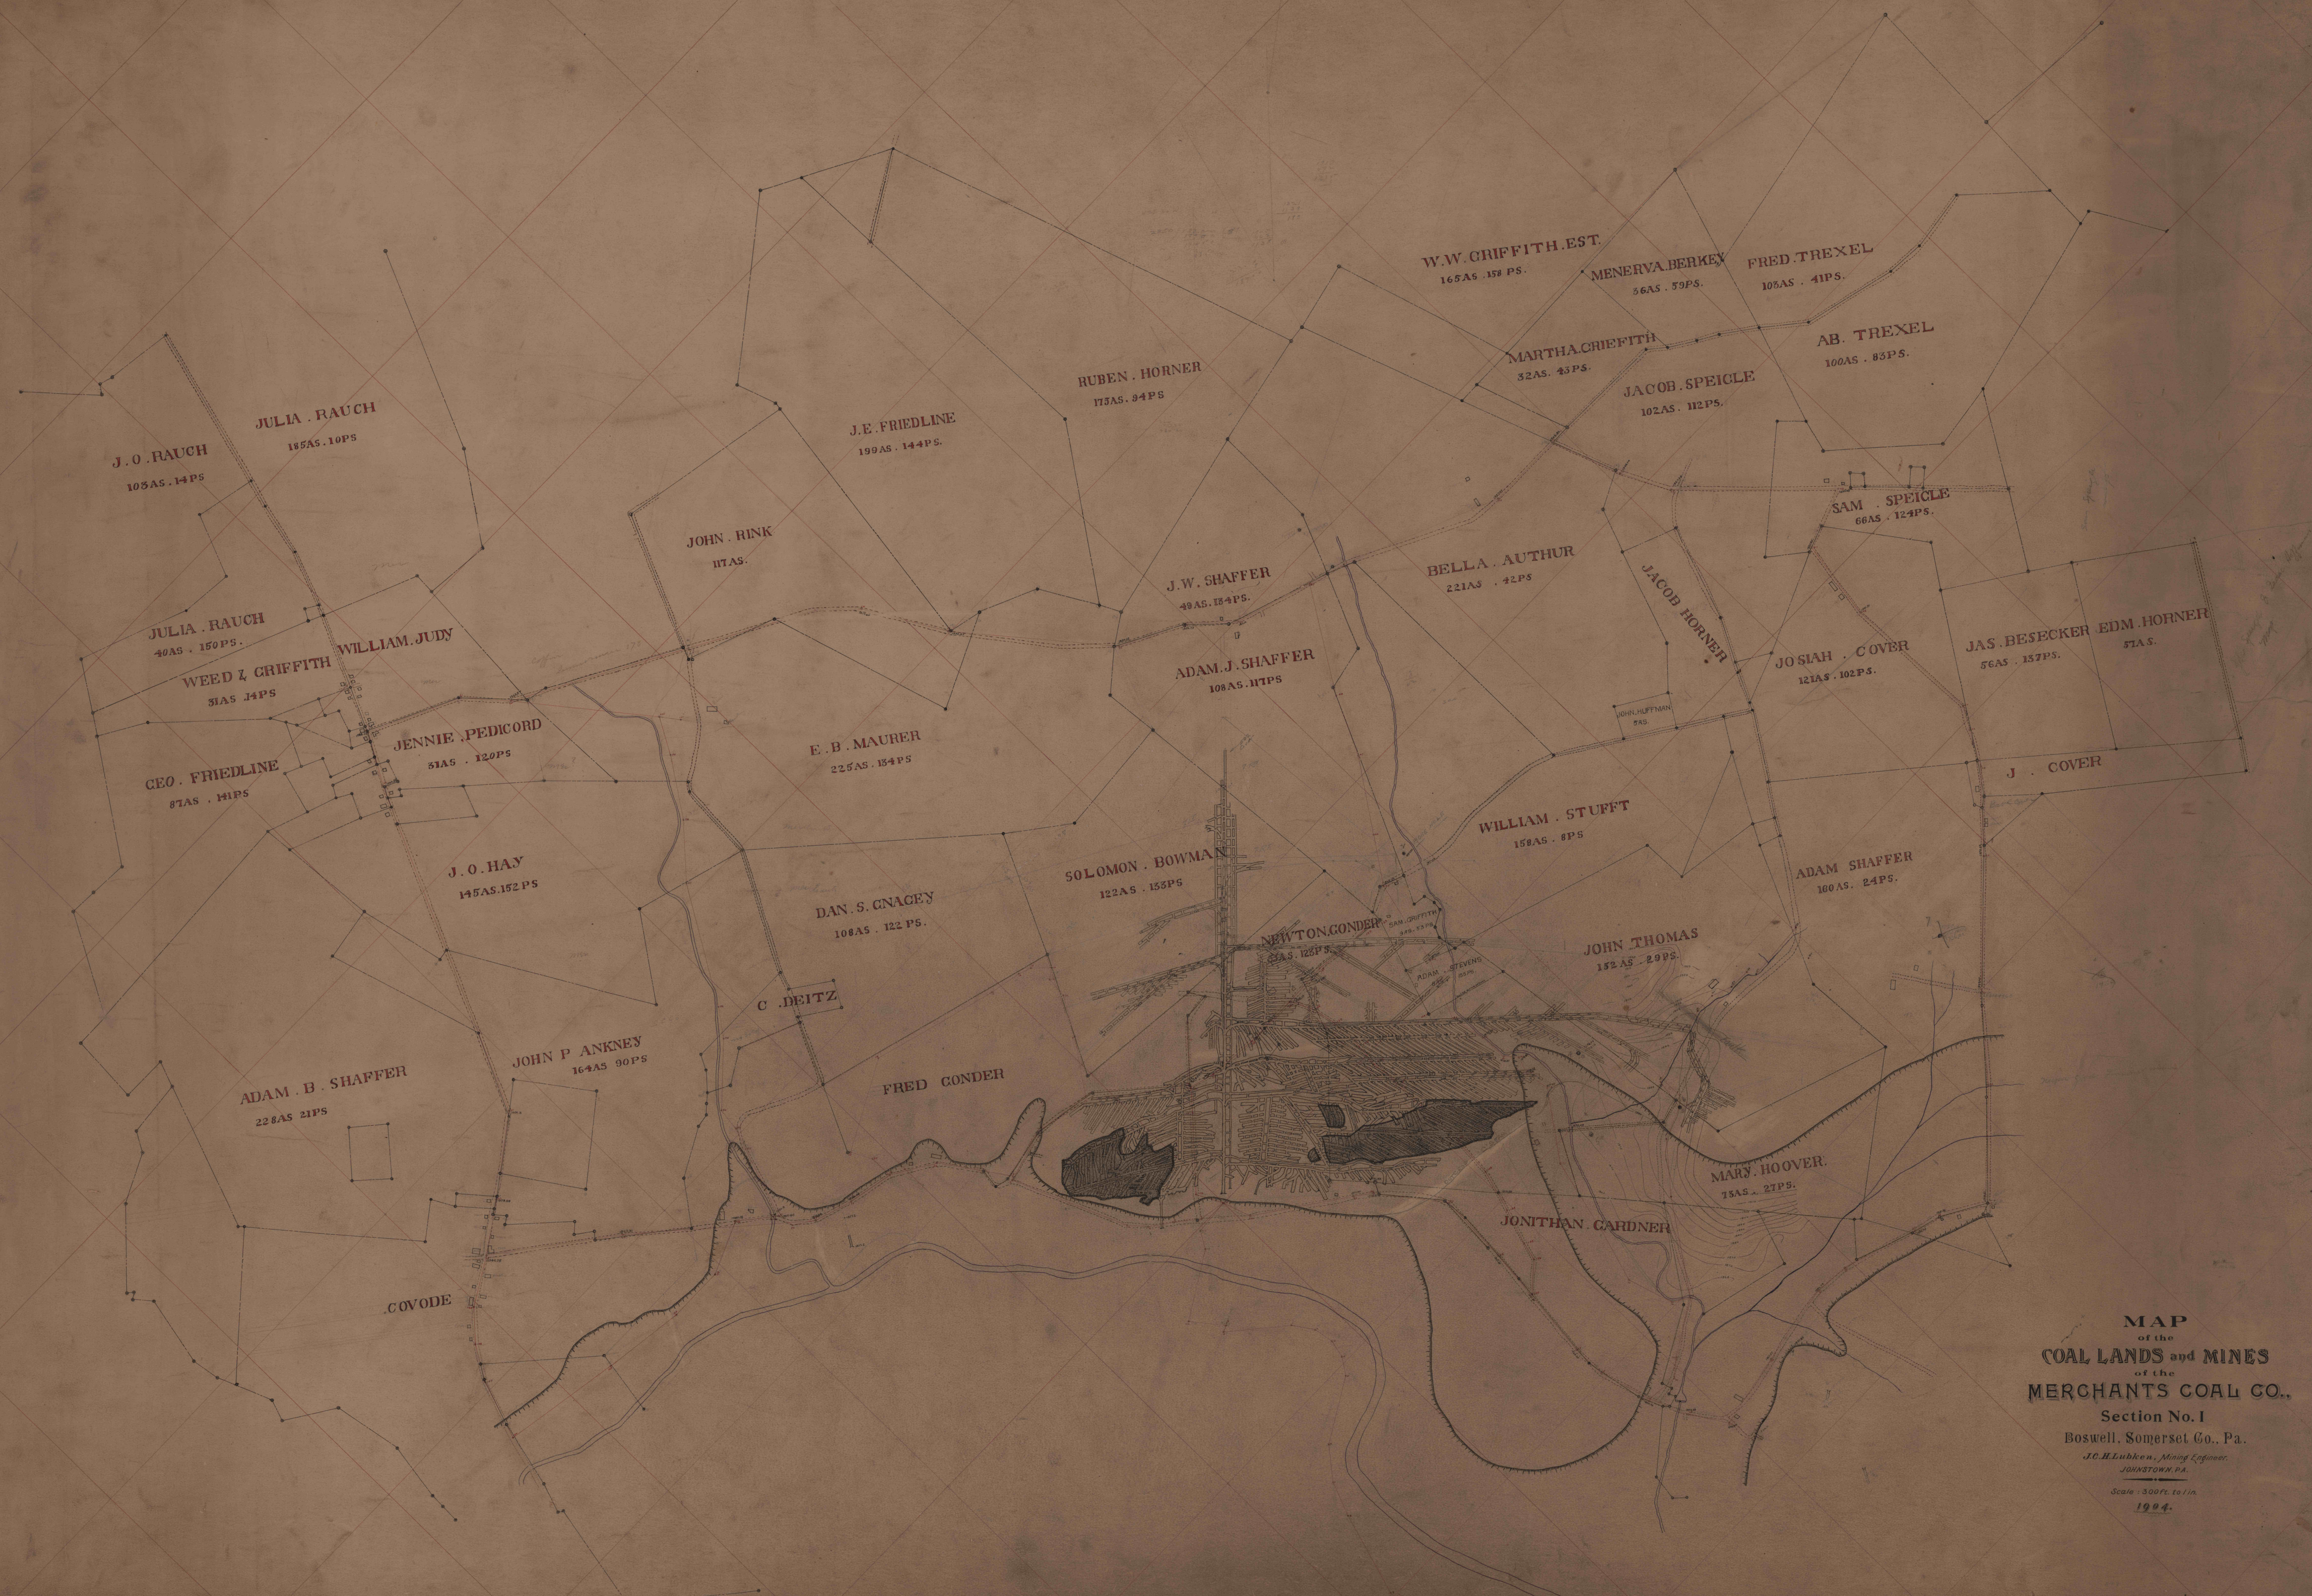

MAP
of the
COAL LANDS and MINES
of the
MERCHANTS COAL CO.,
Section No. I
Boswell, Somerset Co., Pa.
J.C. Hlubken, Mining Engineer,
JOHNSTOWN, PA.
Scale: 300 FT. to 1 in.
1904.