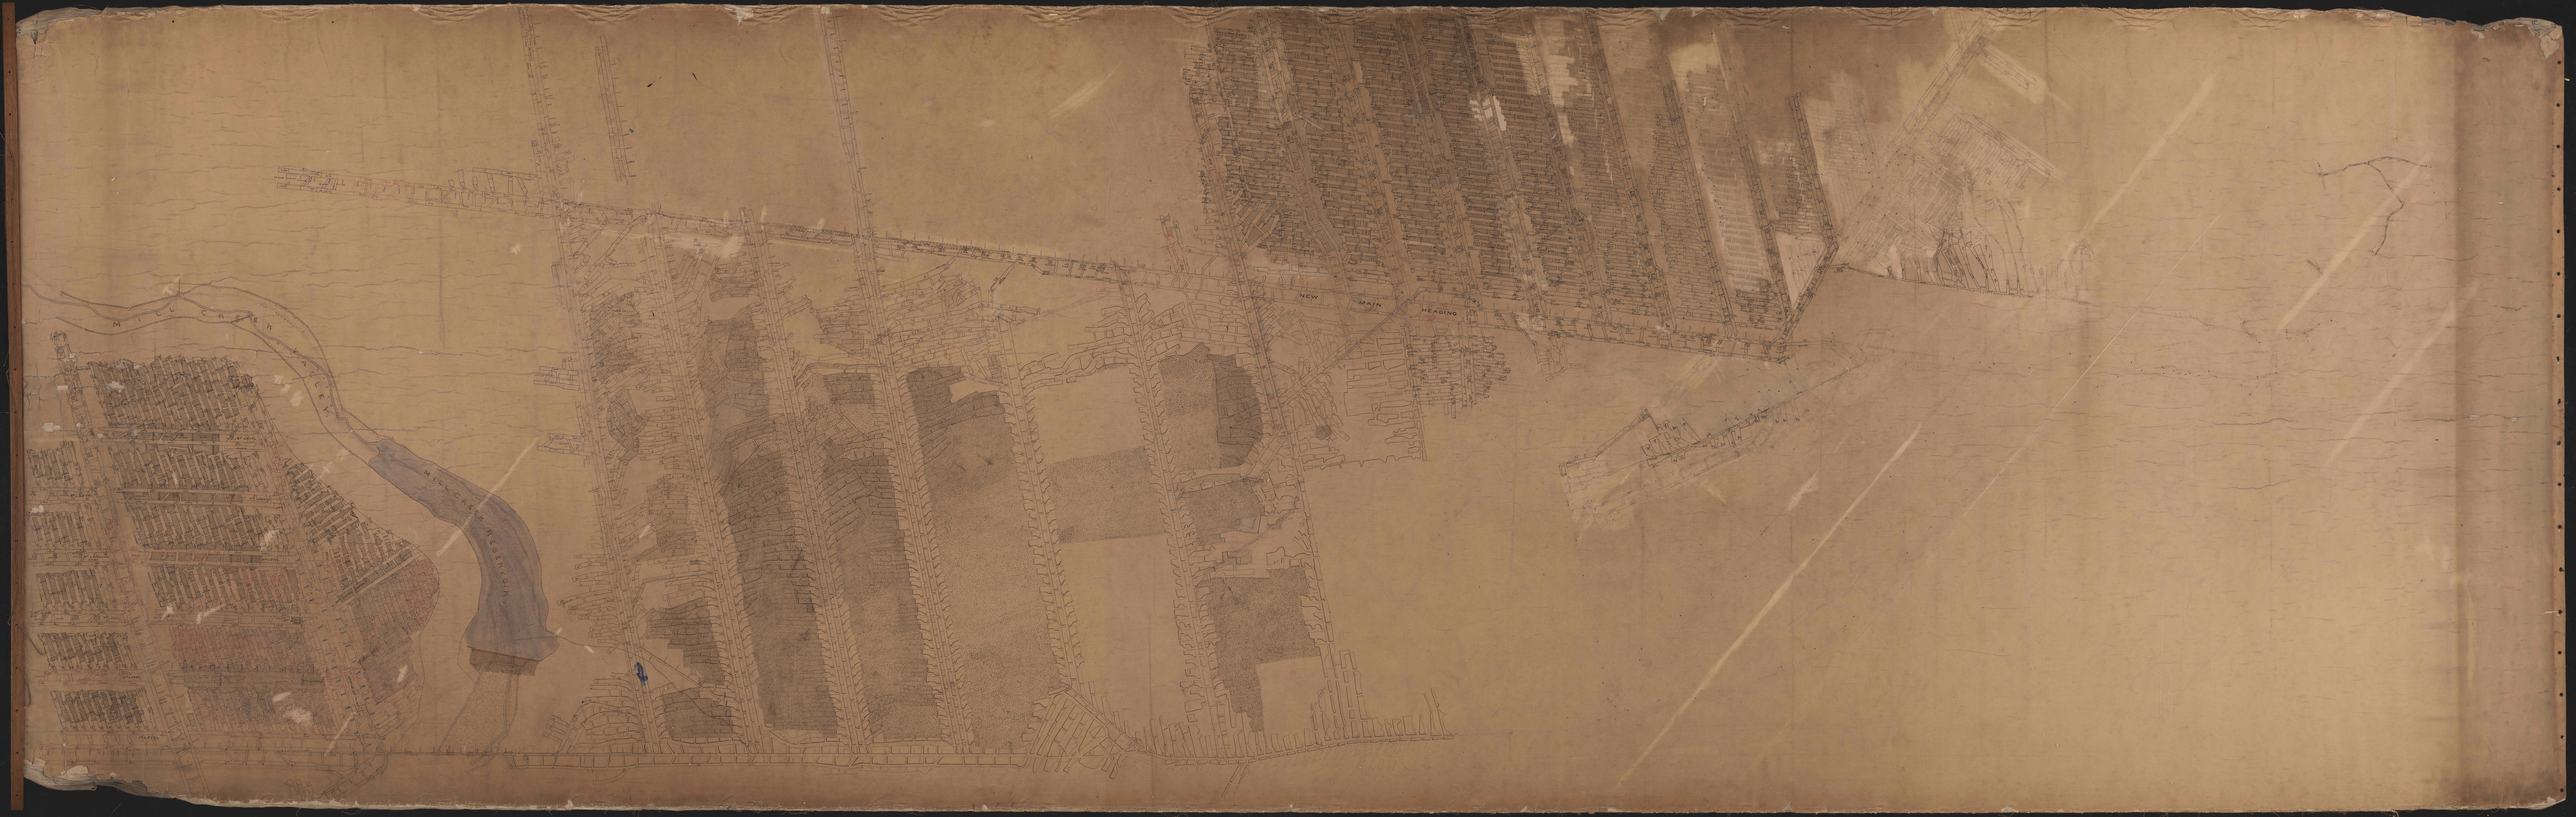
MILLCREEK VALLEY
MILLCREEK RESERVOIR
NEW
MAIN
HEADING