


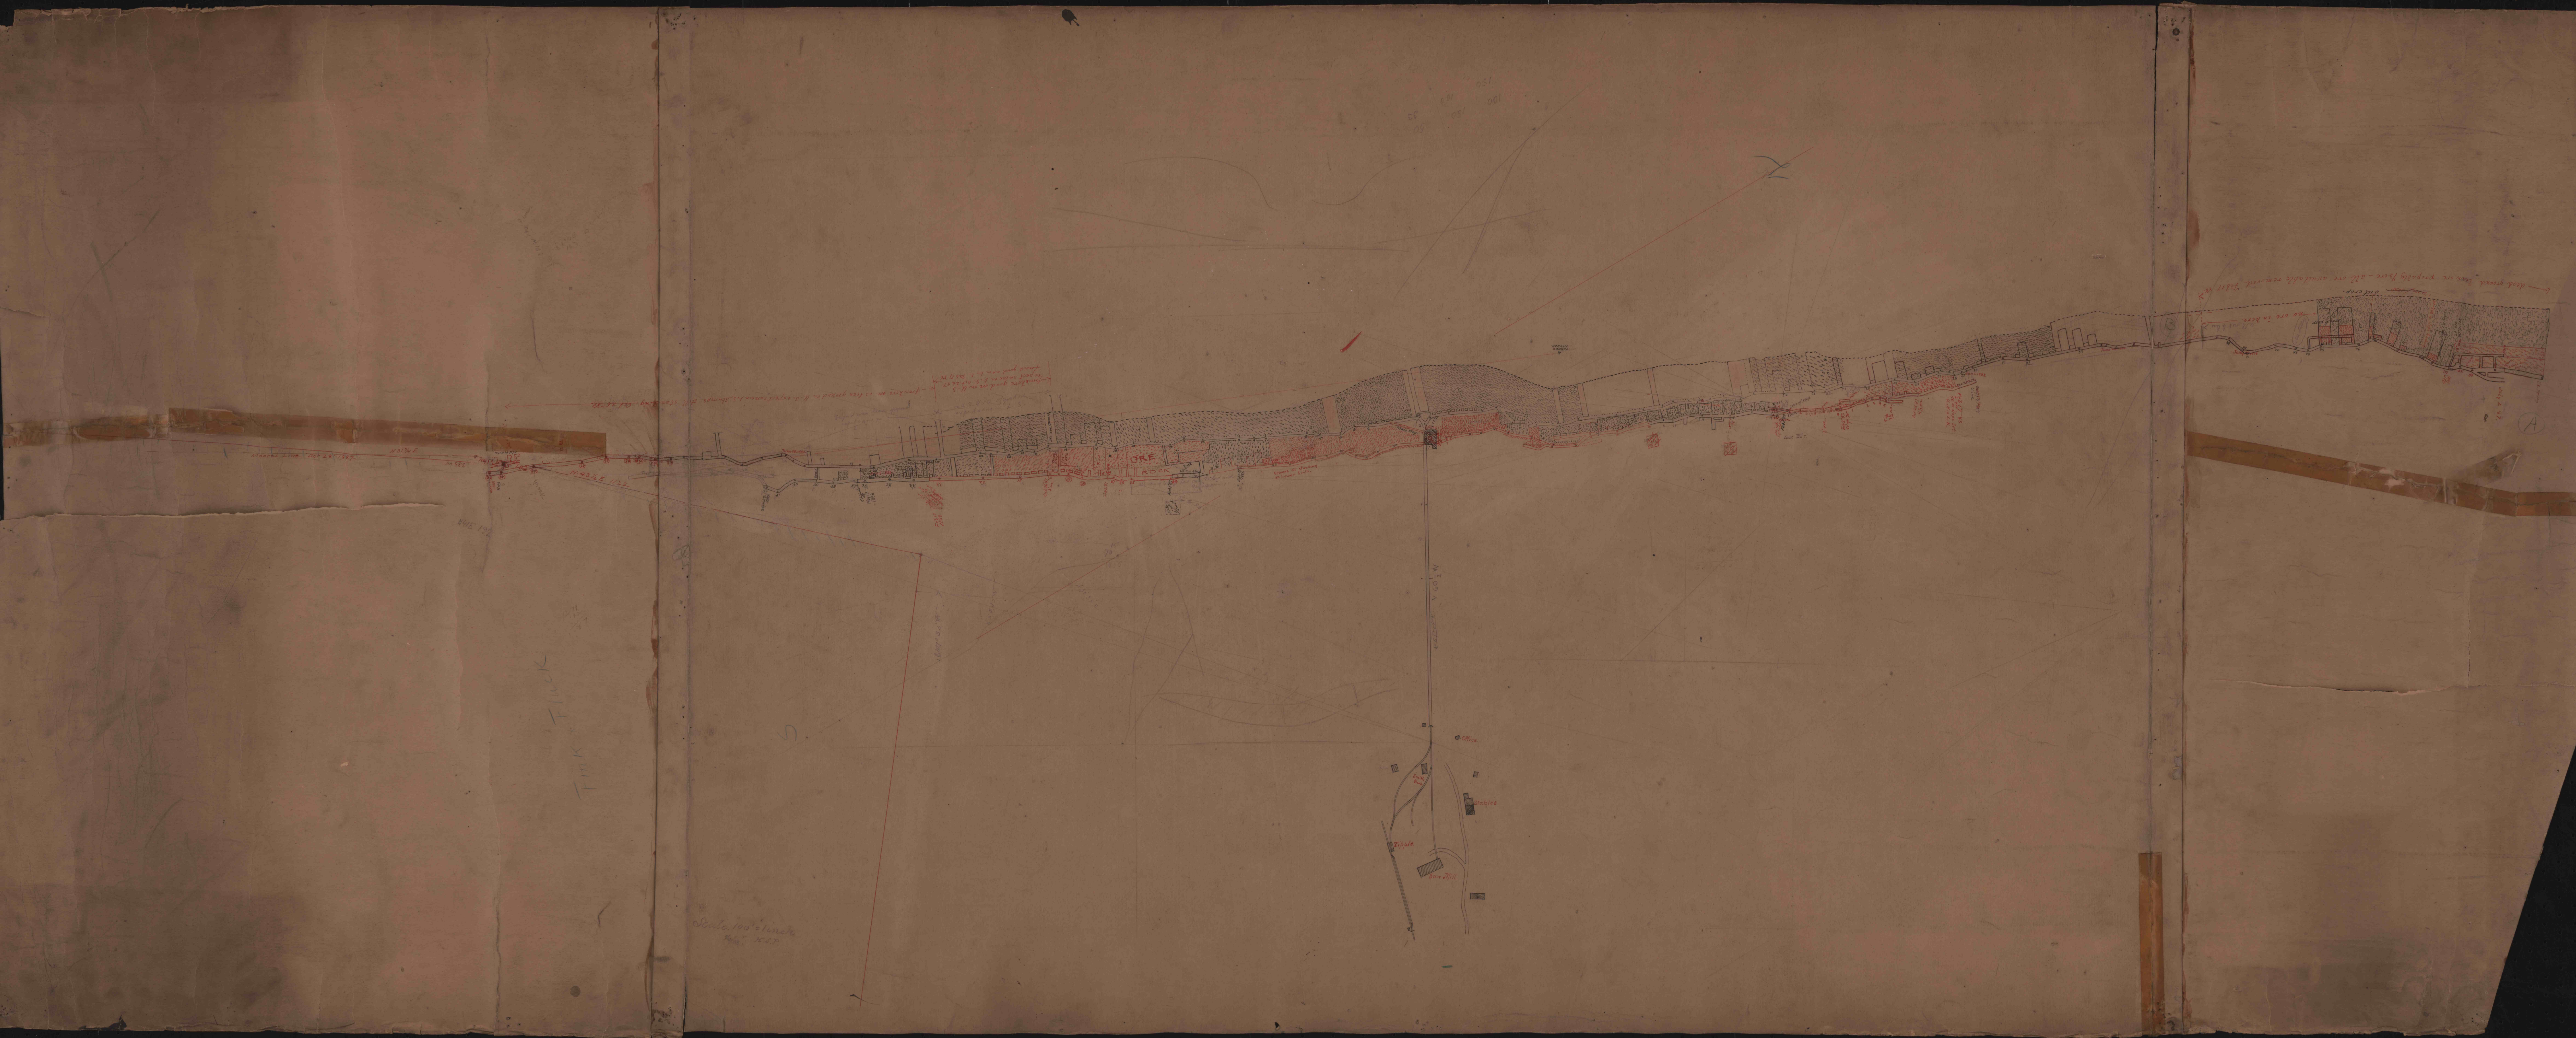

THICK

Scale 100' = 1 inch


ONE ROCK

Office

Stables

Barn

27th