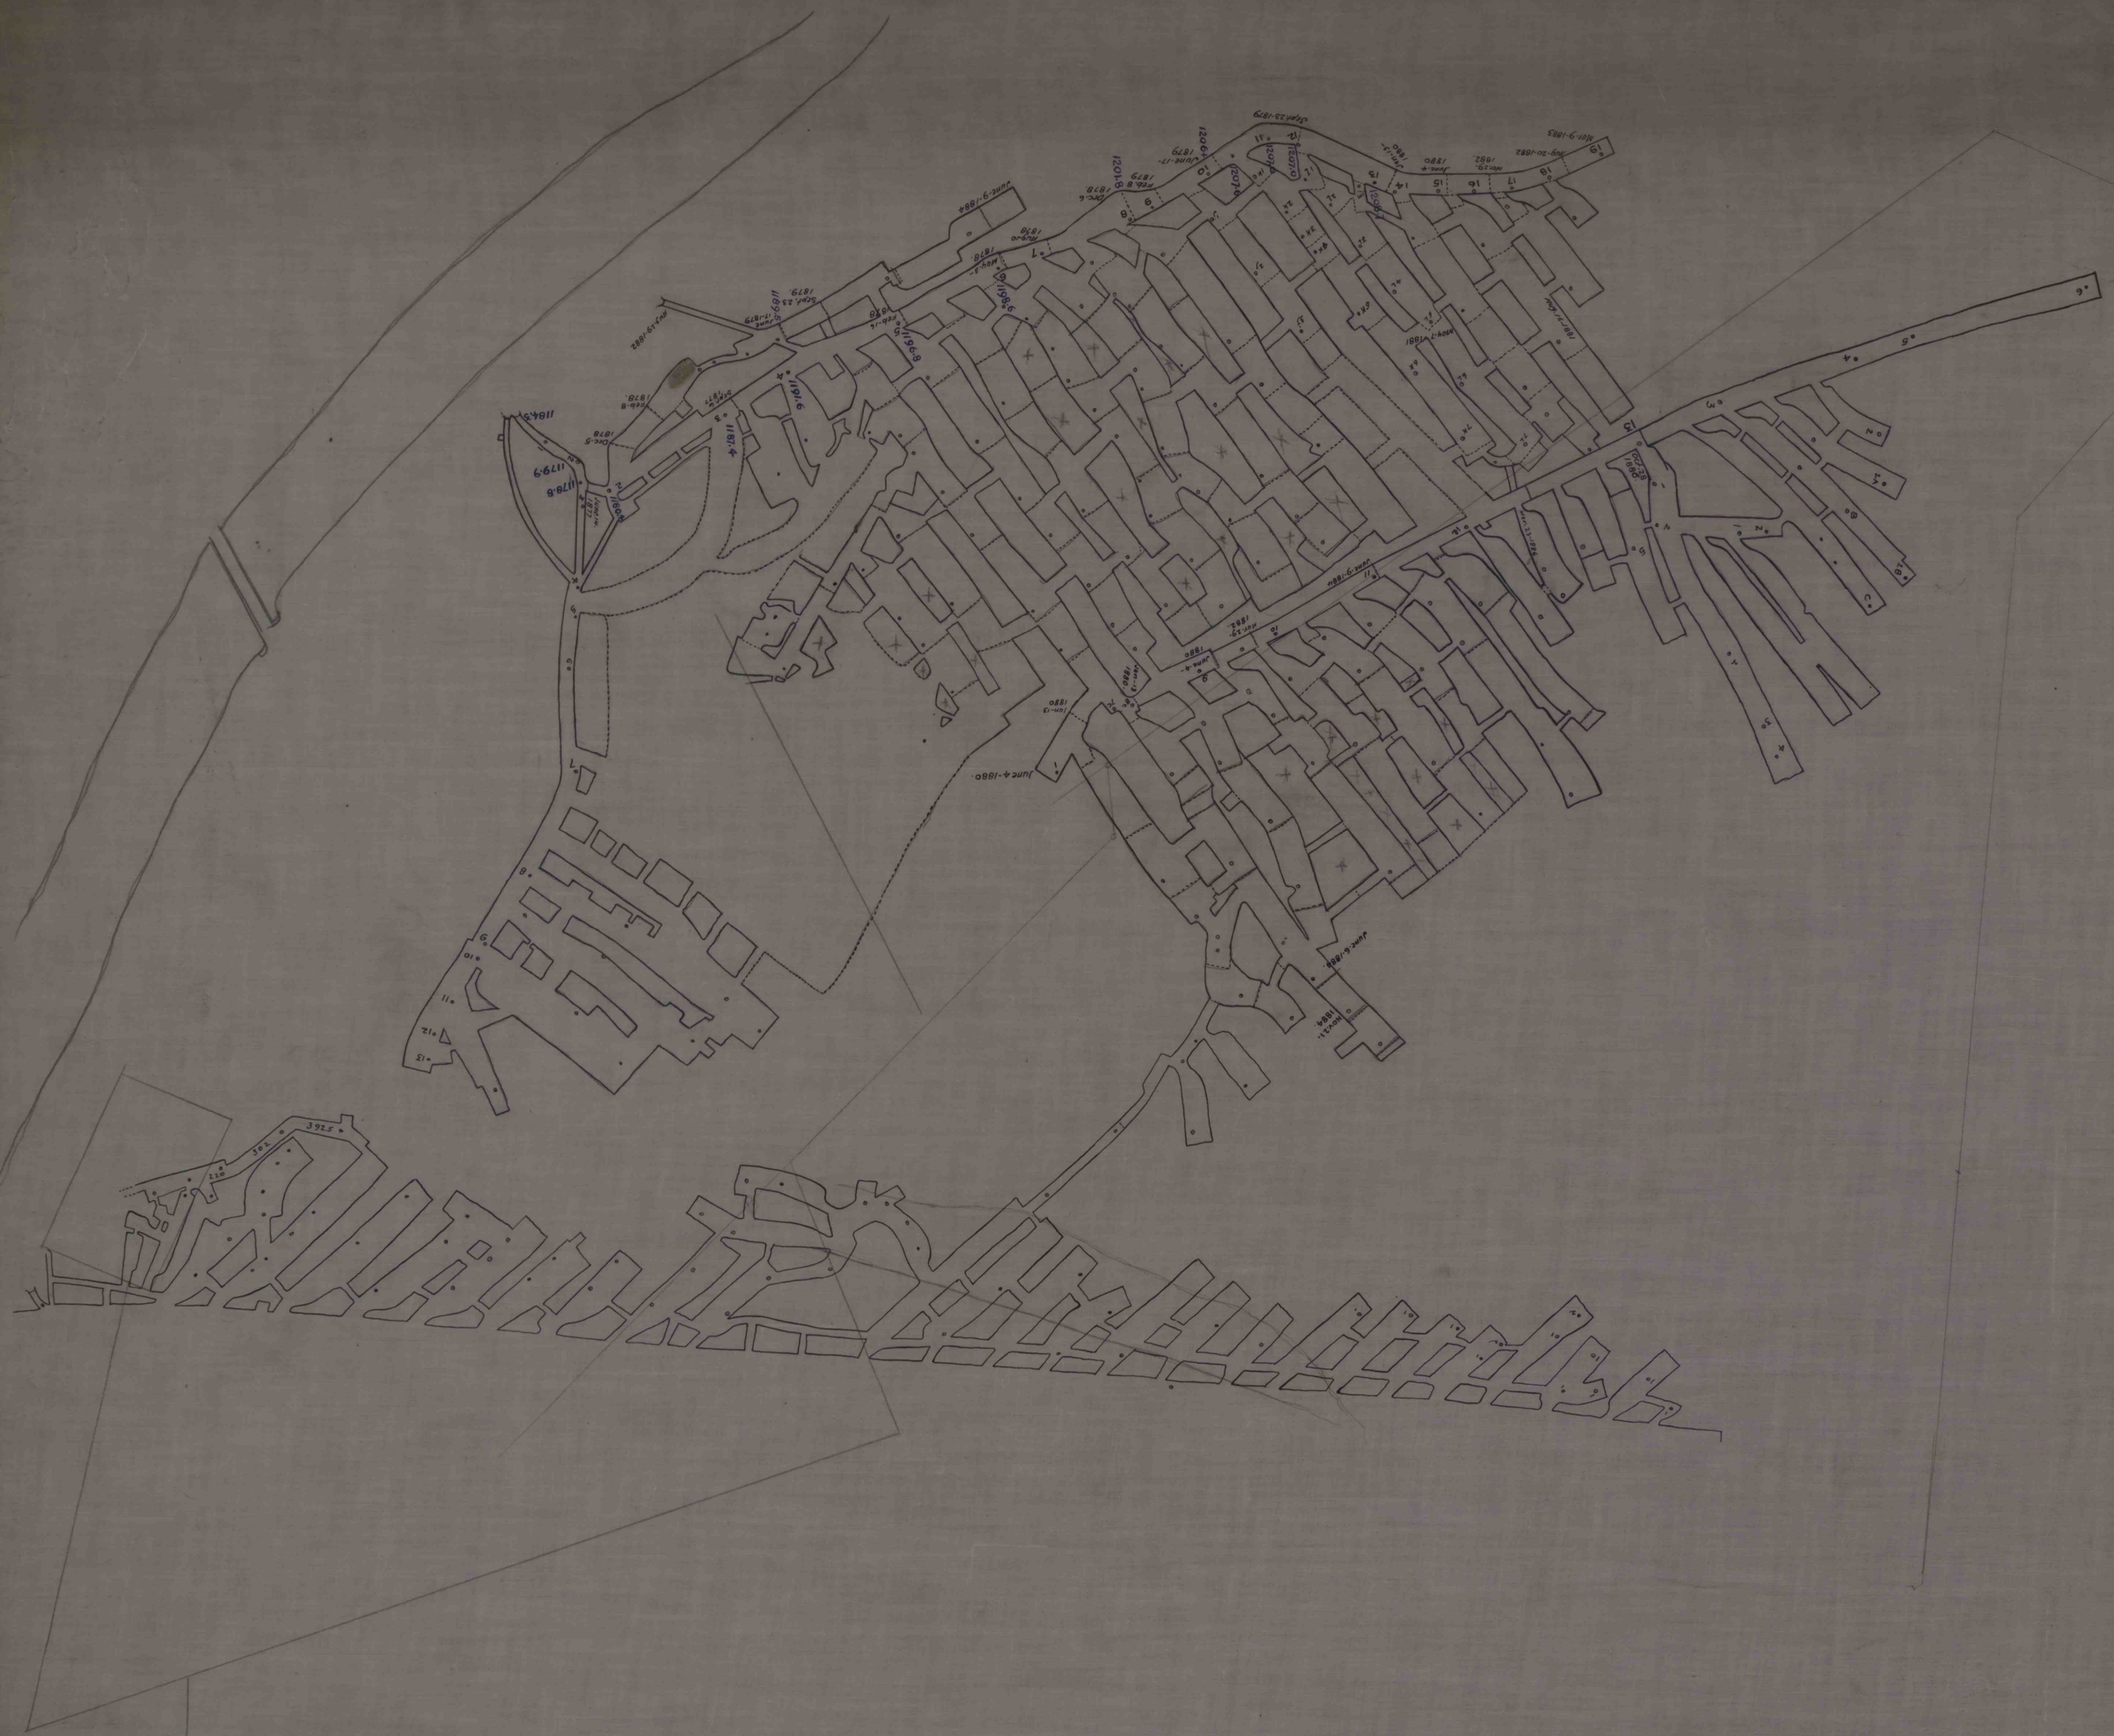

4-D-3