


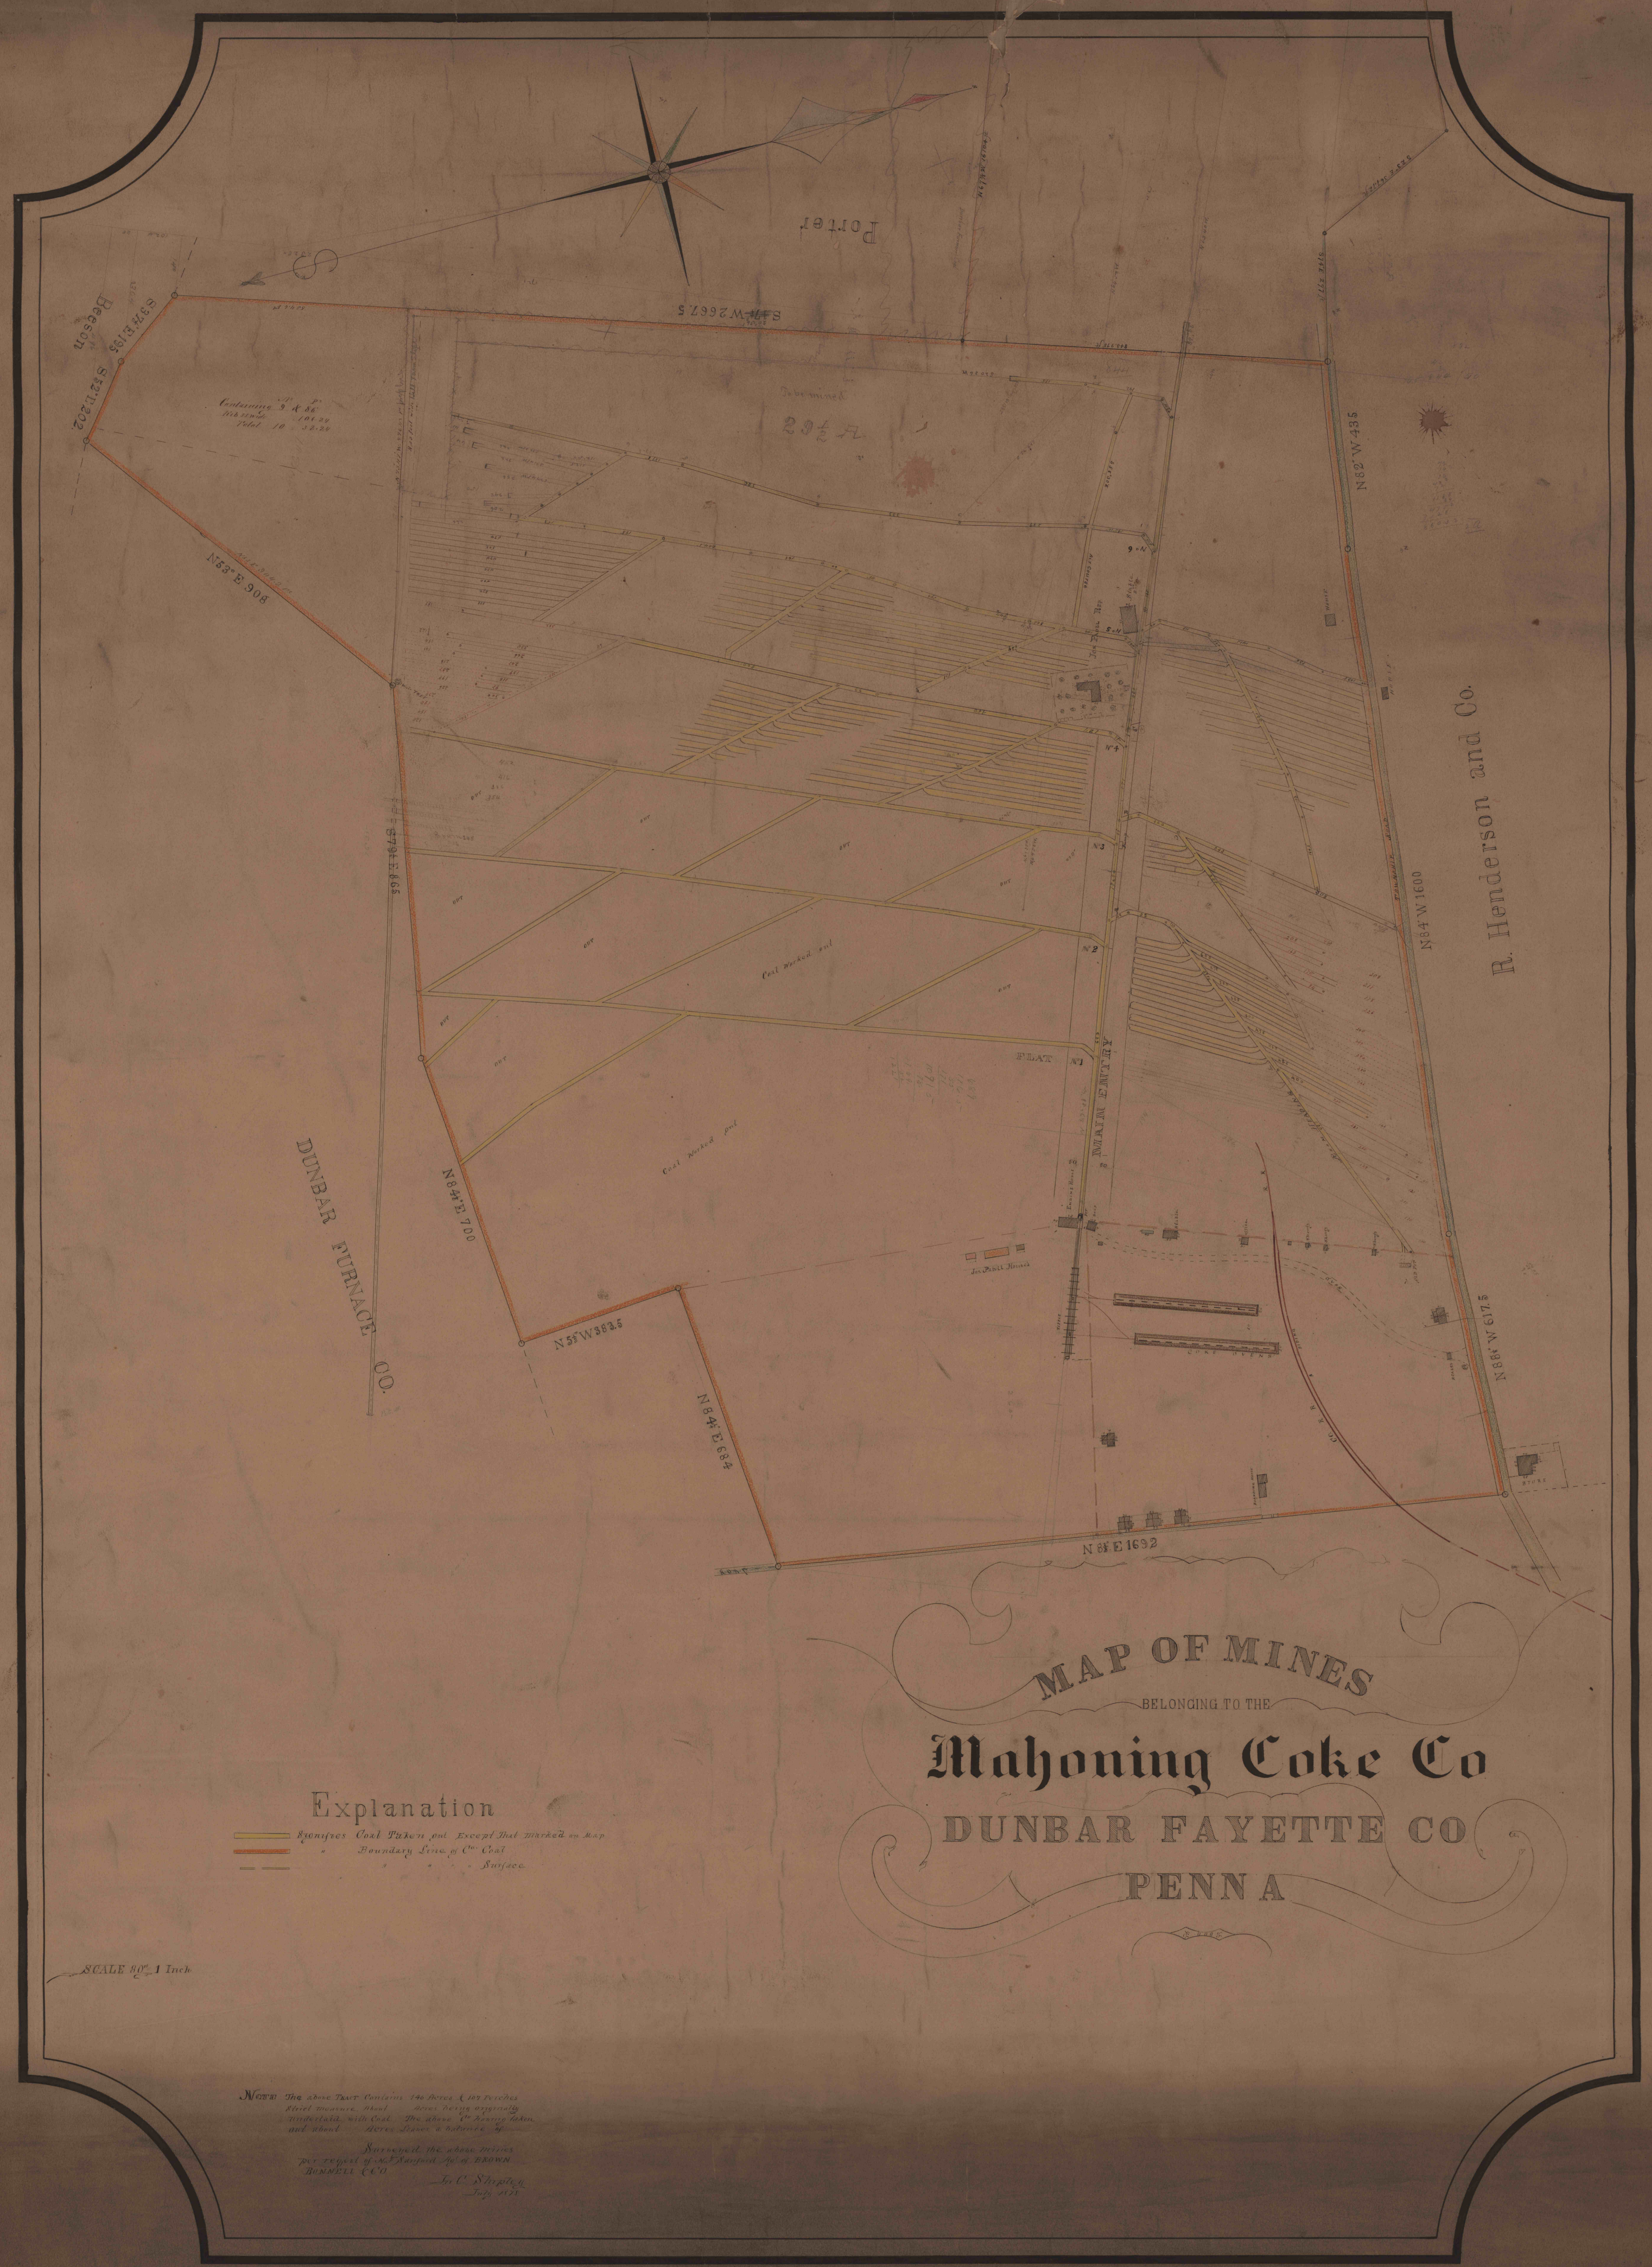

Porter

S 31° W 2667.5

Beeson

N 55° E 906

N 82° W 435

N 84° W 1600

R. Henderson and Co.

DUNBAR FURNACE CO.

N 84° E 700

N 55° W 562.5

N 84° E 682

N 84° E 1692

N 84° W 617.5

MAP OF MINES

BELONGING TO THE

Mahoning Coke Co

DUNBAR FAYETTE CO

PENNA

Explanation

- signifies Coal Taken out Except that marked on map
- Boundary Line of Co's Coal
- Surface

SCALE 60' = 1 Inch

NOTE: The above map contains 140 Acres & 100 Perches
Steel measure, and does not vary materially
with Coal. The above 100 Acres taken
and about 100 Acres shown a surface of

Noted: the above mines
are registered in the name of
BROOKS & CO.
J. C. Shipton
July 1871