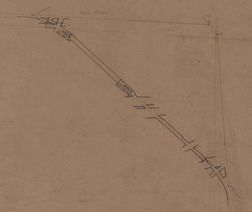

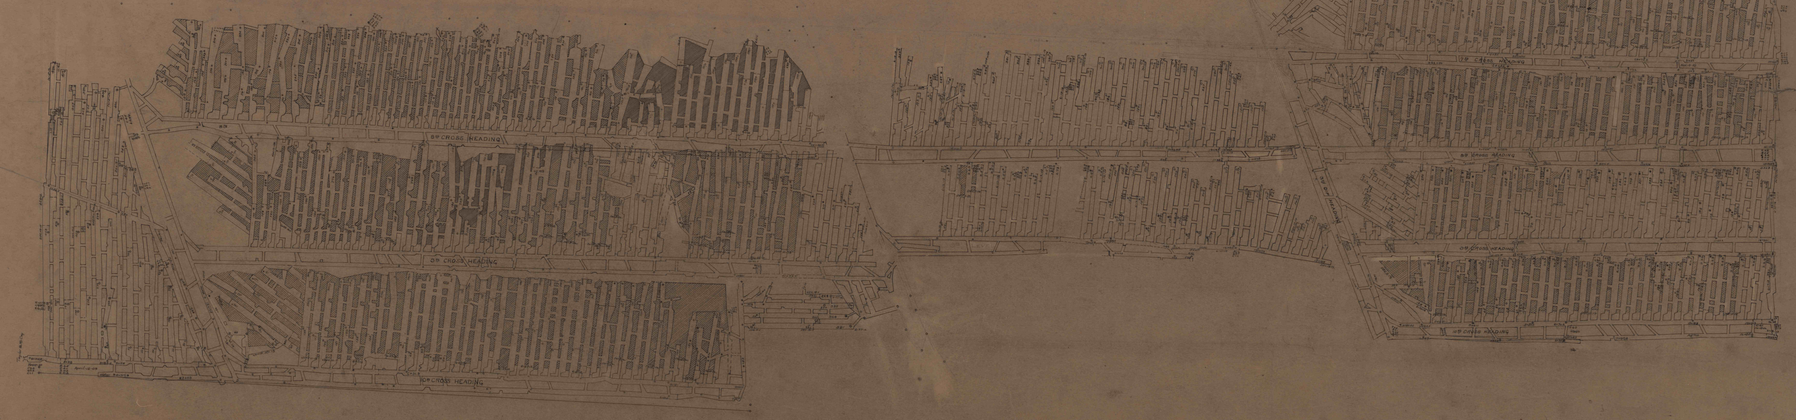

LEMON MINE
Nov. 20, 1907
L.B. 271