


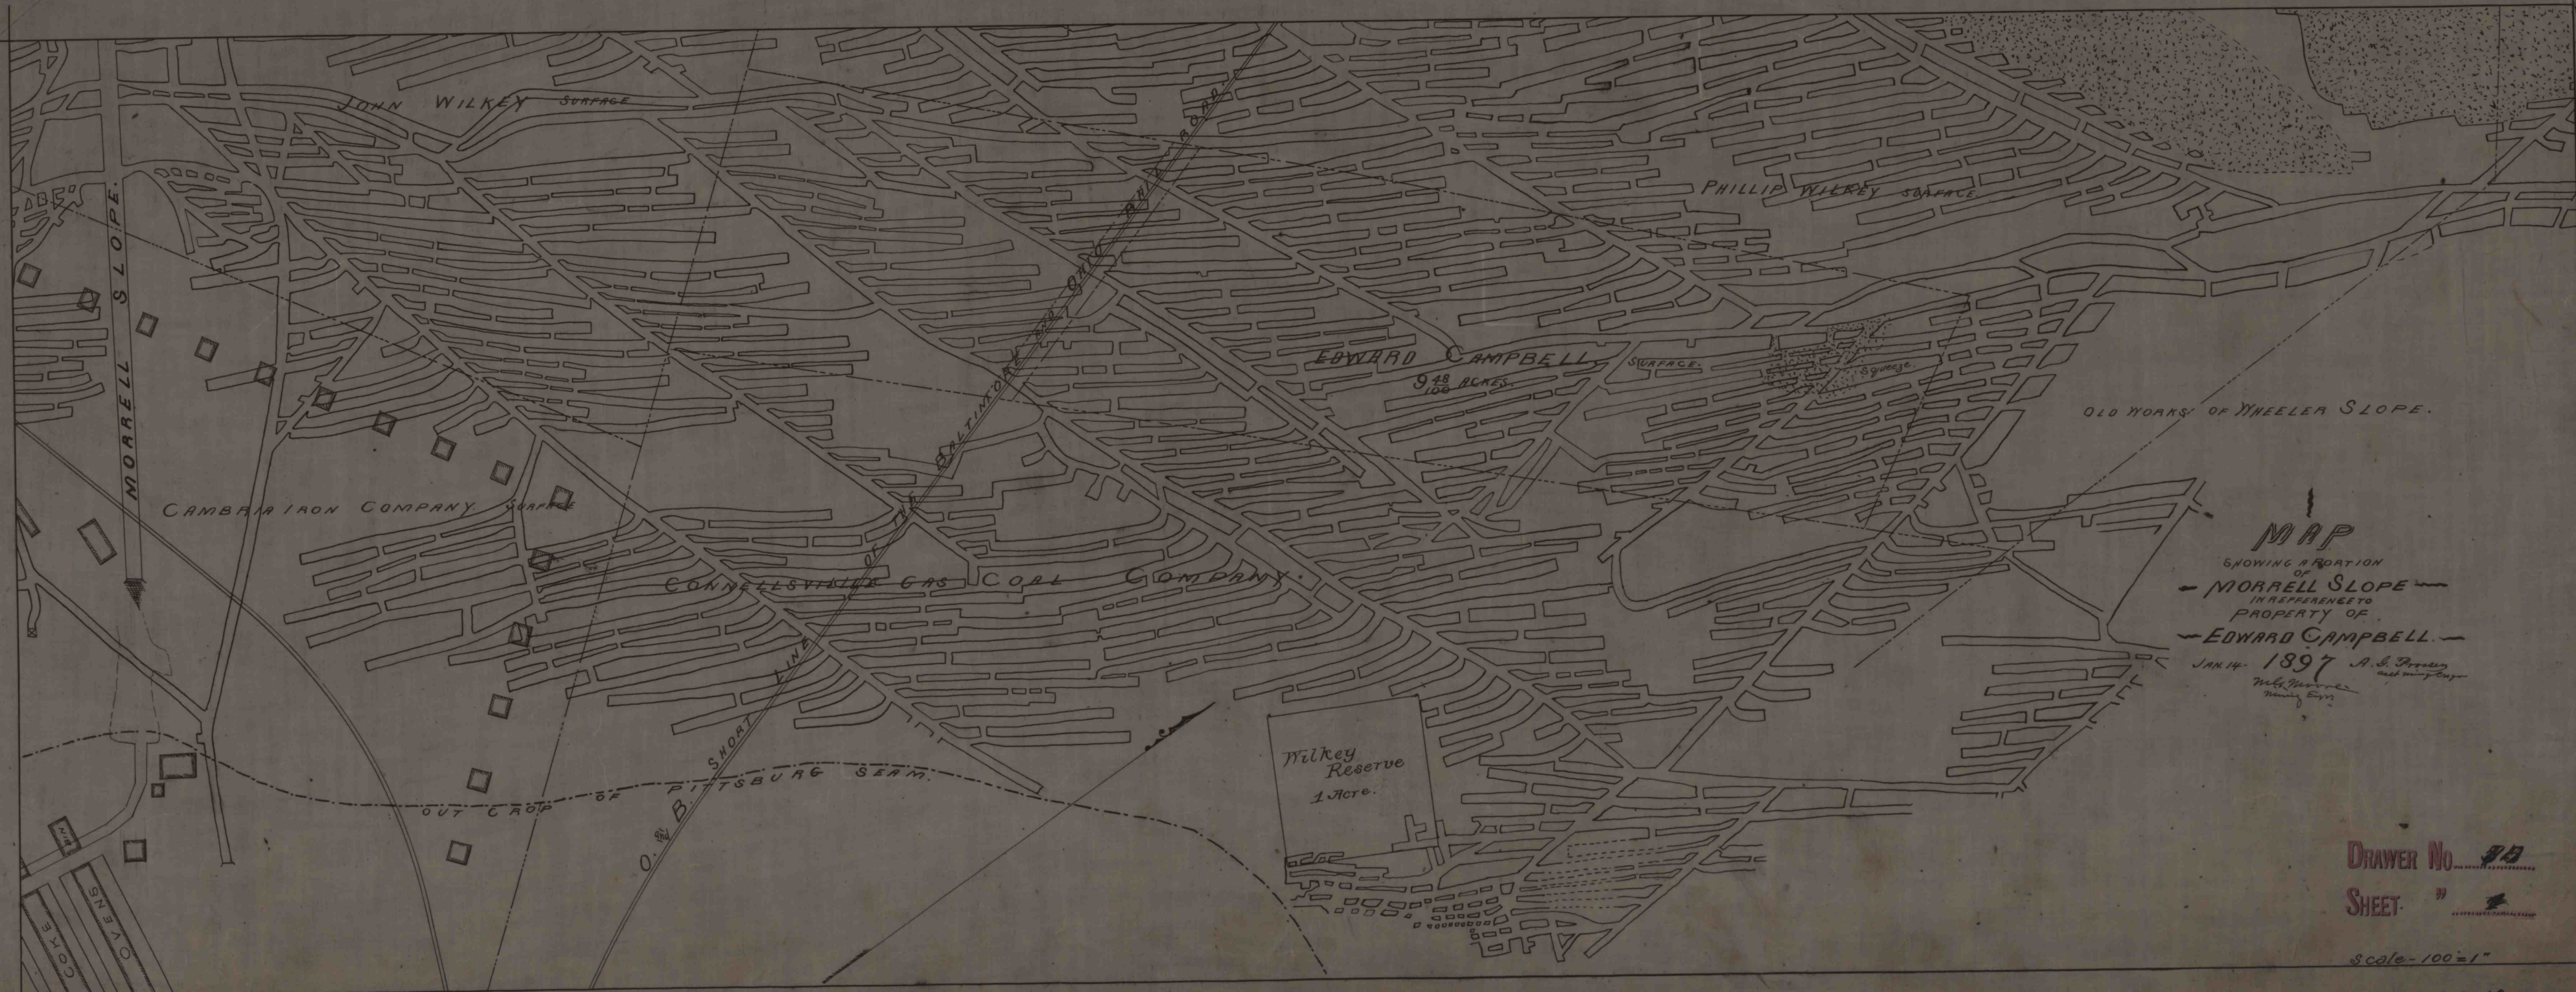

MAP
SHOWING A PORTION
OF
— MORRELL SLOPE —
IN REFERENCE TO
PROPERTY OF
— EDWARD CAMPBELL —
JAN. 14. 1897
A. S. Rogers
Wm. H. Moore
Henry Egan

DRAWER No. 73
SHEET "

Scale - 100 = 1"